

MIDSHIP SECTION

STEEL SCREW TRAWLER

N° 579


DIMS 130'-0" BP x 23'-6" EX x 13'-6" MLD

SCALE 1/2 INCH

TO CLASS 100A1 STEAM TRAWLER. DECK PLATED OVER IN WAY OF MACHINERY SPACE. E. & B. CASING AS PREVIOUSLY APPROVED

PLAN No. 2977
FOR ENCLOSURE TO
Messrs Lloyd's Surveyors
Hull FROM
COCHRANE & SONS, LTD.
SHIPBUILDERS, SELBY.
DATE 12/9/13. *J.S.M.*

16.6.13
14.7.13

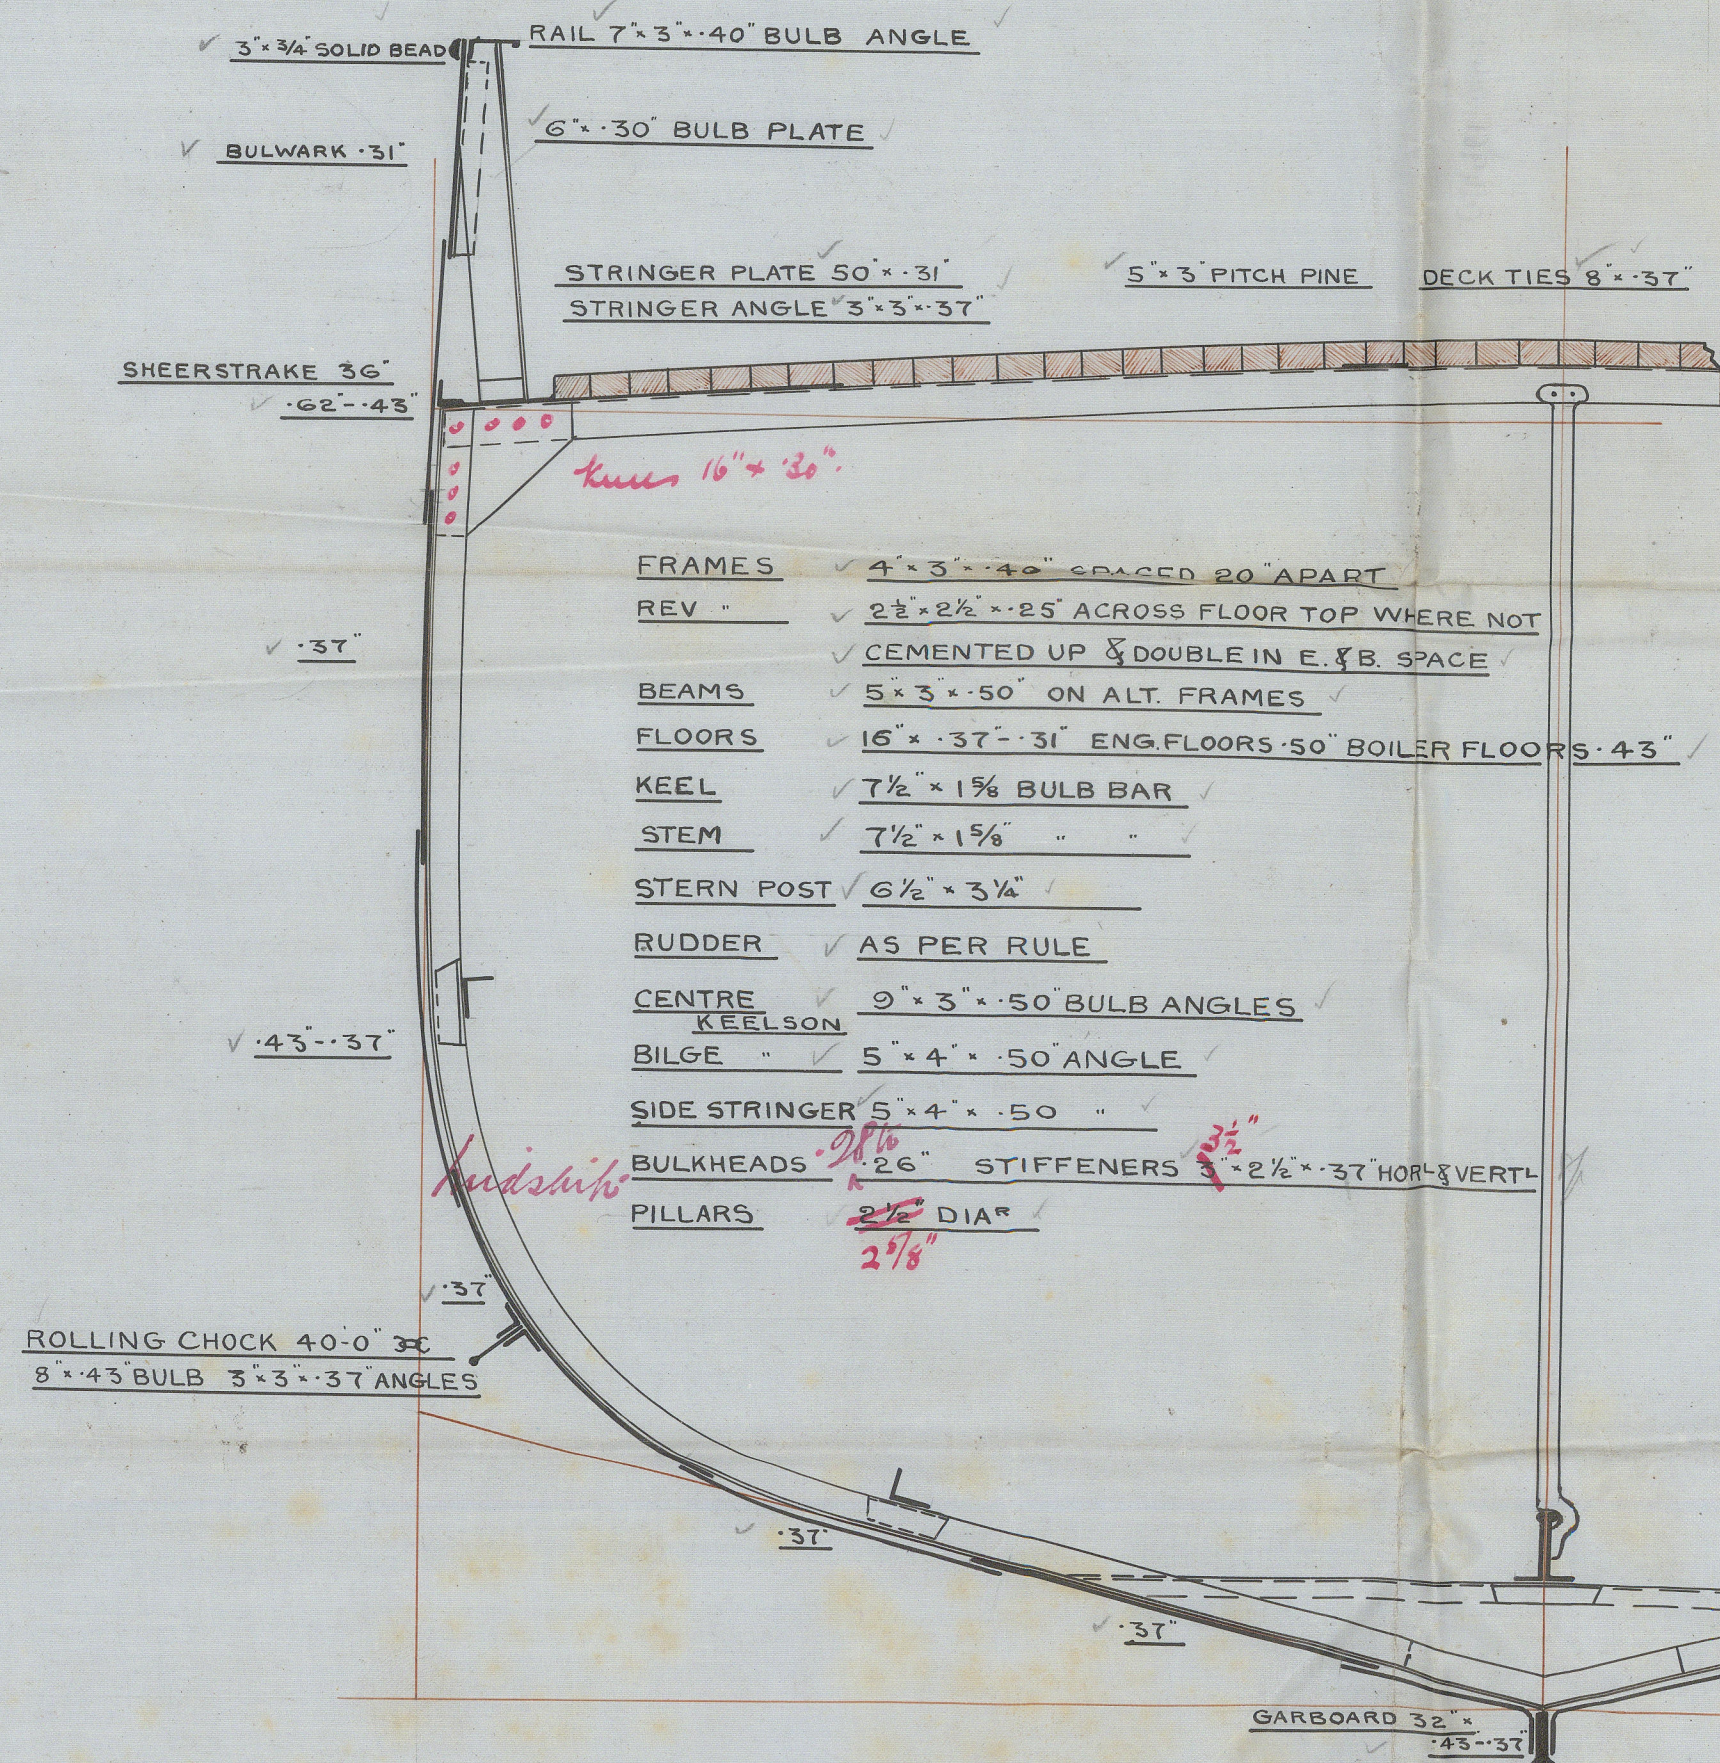

NUMERALS

B+D ——— 36.88
L x (B+D) ——— 4794.40

PROPORTIONS

Dr ——— 9.62
Br ——— 5.56

EQUIPMENT

✓ 1ST BOWER ANCHOR 6 CWTs EX STOCK
✓ 2ND " " 5 1/2 " " "
✓ KEDGE " 3 " " "
✓ 120 FATHOMS 1 1/16" STUD LINK CABLE
✓ 60 " 6" HAWSER
✓ 60 " 5" WARP

RIVETING

✓ BUTTS OF SHELL PLATING TO BE LAPPED & DOUBLE
✓ RIVETED EXCEPT GARBOARD & SHEERSTRAKE
✓ WHICH ARE TO BE STRAPPED & DOUBLE RIVETED
✓ LANDINGS DOUBLE RIVETED BULWARKS SINGLE RIVETED



C.F.
10/6/13

Cochrane & Sons
No 579.

Midship Section.

Dimensions

130-0' x 23-38' x 13-5'

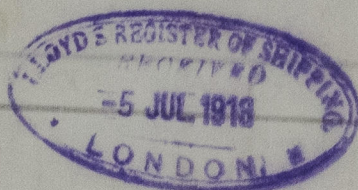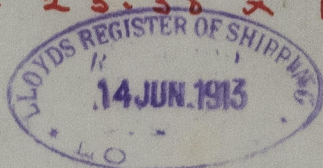

$\frac{1}{5}$ Clotilde,

Hull Rpt No: 27004

PROPORTIONS
B 22
D 22
L 1








© 2021

Lloyd's Register
Foundation