

6 AUG 1924

# MIDSHIP SECTION.

T.S. PASSENGER & CARGO STEAMER.

DIMENSIONS: 220'0" B.P. - 28'6" - 16'3" MLD

TO CLASS. B.S. \* (WITH FREEBOARD)

SCALE: 1/2" = 1 FOOT.

121 - 122

C.N. 22/10/44

$$\frac{220 \times 28.5 + 16.25 \times 1.75}{100} = 76.4$$


$$\frac{185 \times 15.5 + 7.5 \times 1.50}{100} = 49$$

$$\frac{37 \times 27.5 + 7.5 \times 1.50}{100} = 38$$

$$\frac{857}{100}$$



5 AUG 1924

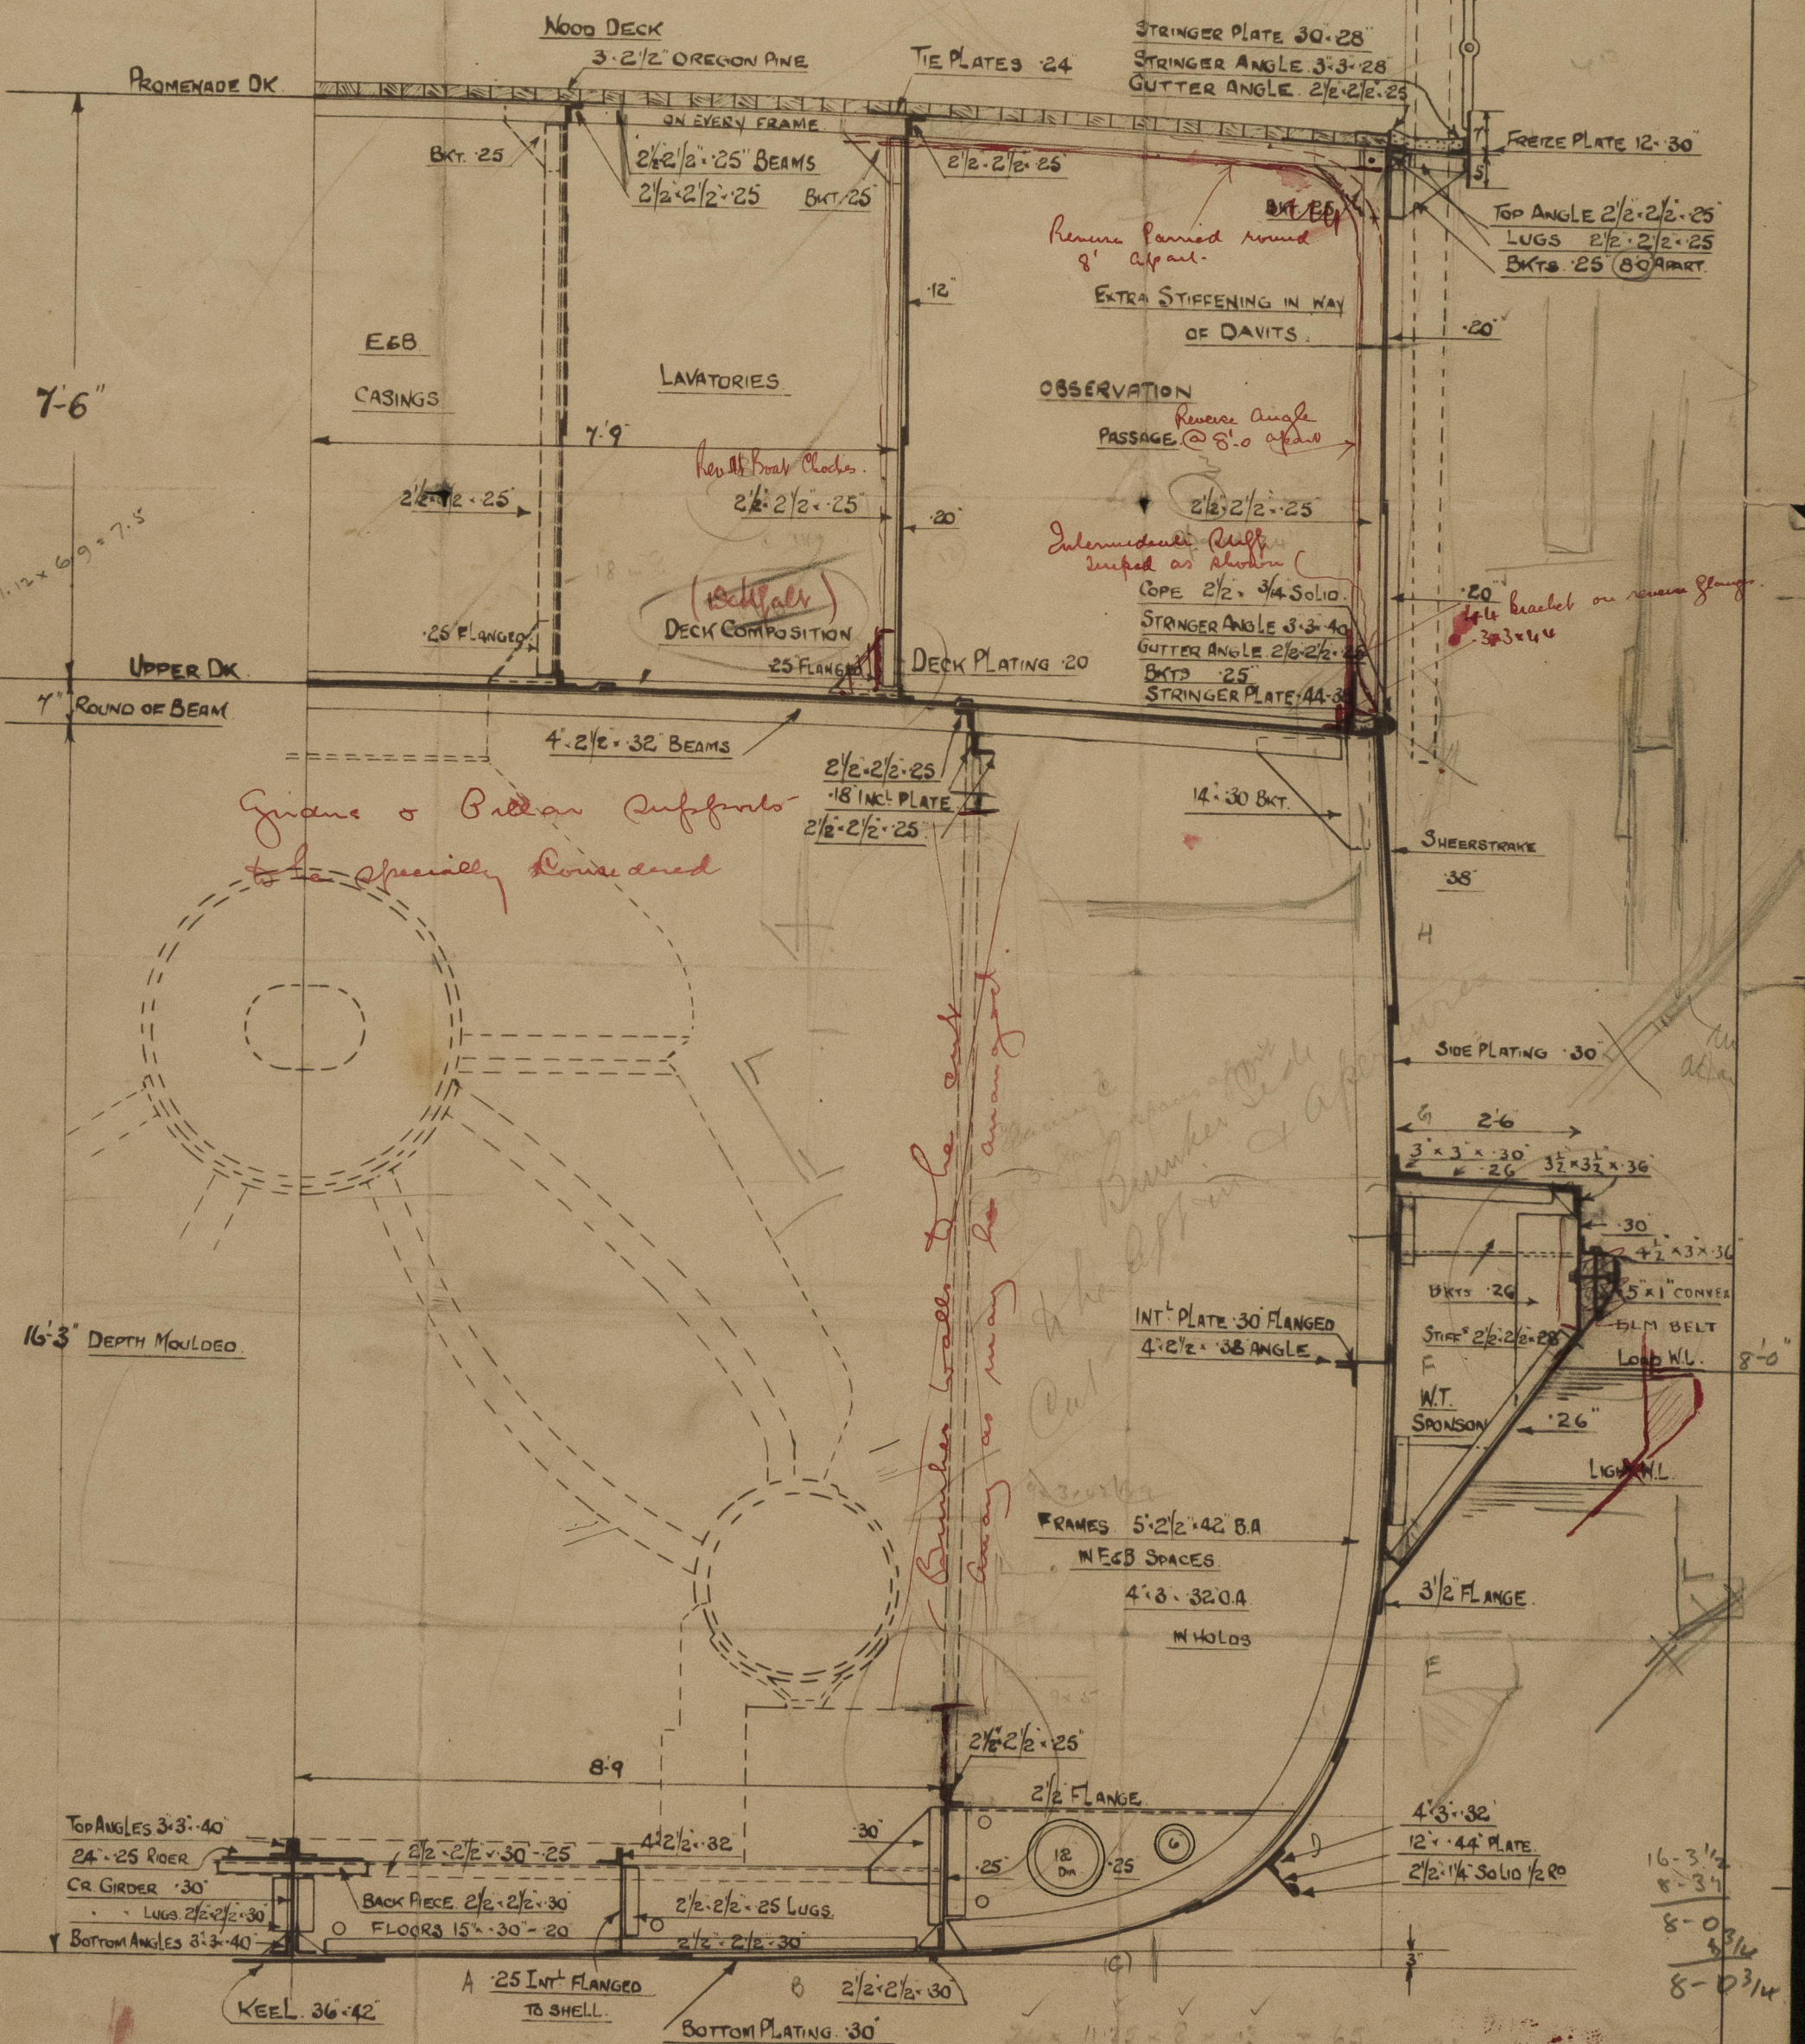



Coaster Canst<sup>ns</sup>

Nov 12/14/152

Mia. Section

Bag.

Lady Cecilia

Lady Cynthia

Coaster Canst<sup>ns</sup> Co.

12/14/2

Mia. Section

8.8.21

1



© 2021

Lloyd's Register  
Foundation

014961-014975-0111