

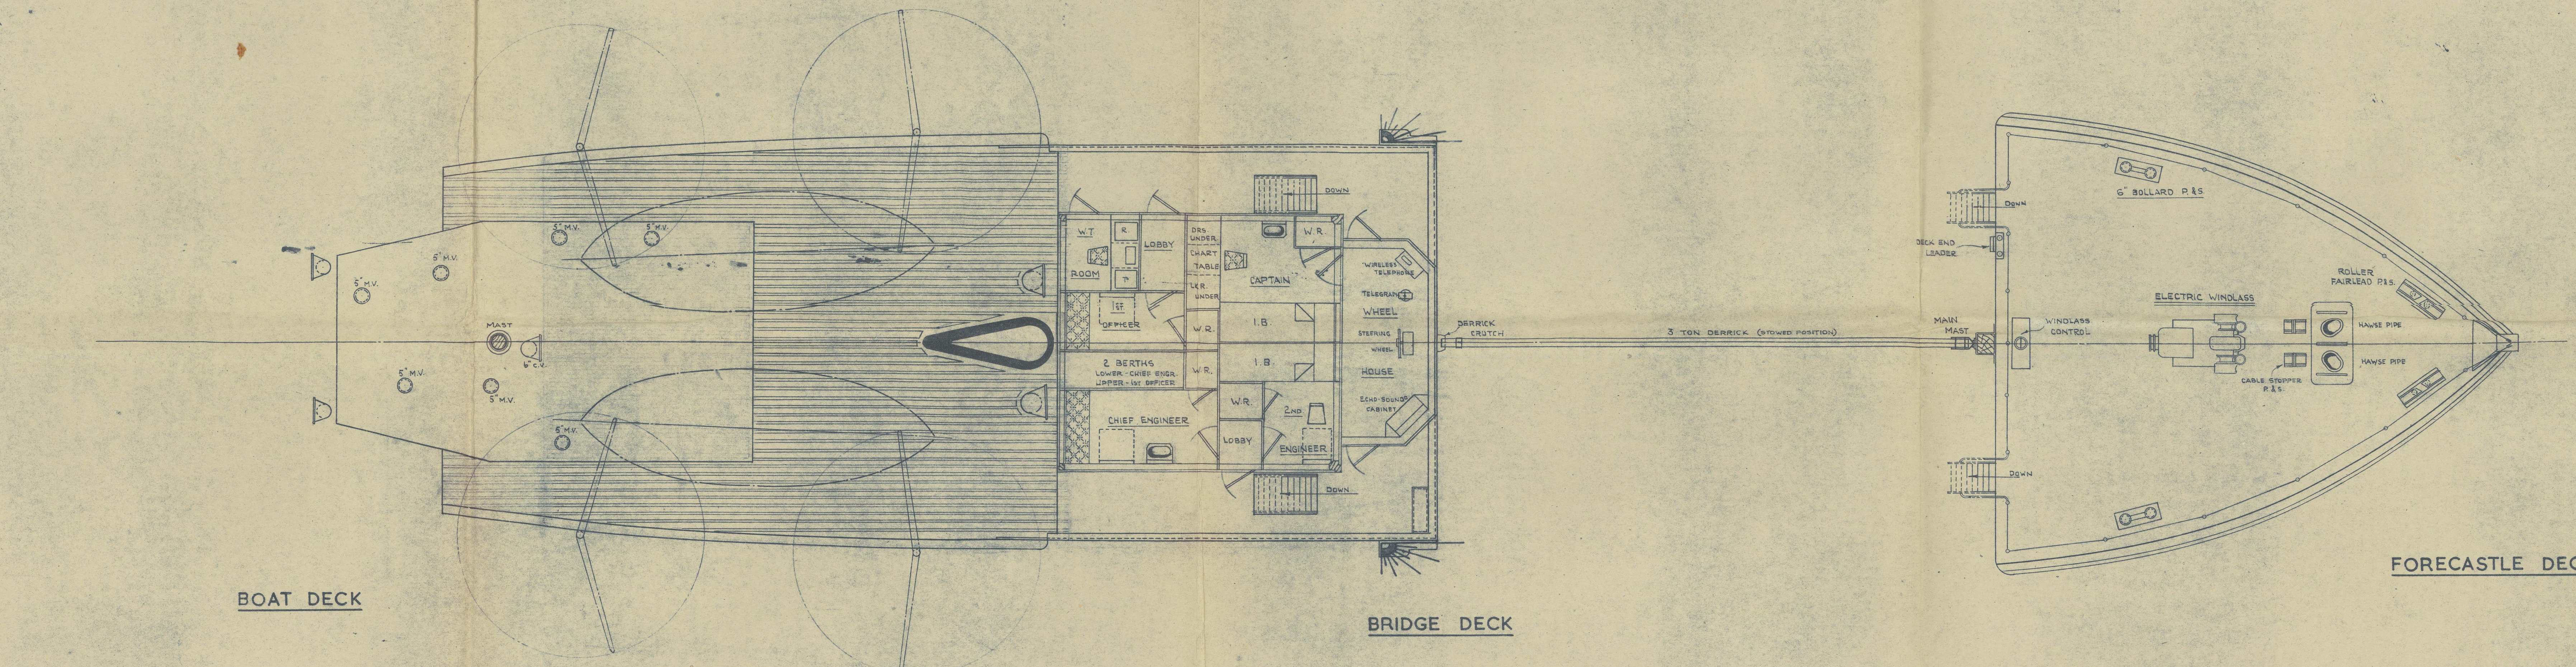


No 483  
M.V. "ADMIRAL GORDON"  
GENERAL ARRANGEMENT  
SCALE 1/4" = 1'-0"  
W.A. PHILLIPS ANDERSON & CO. LTD. LONDON W.I.

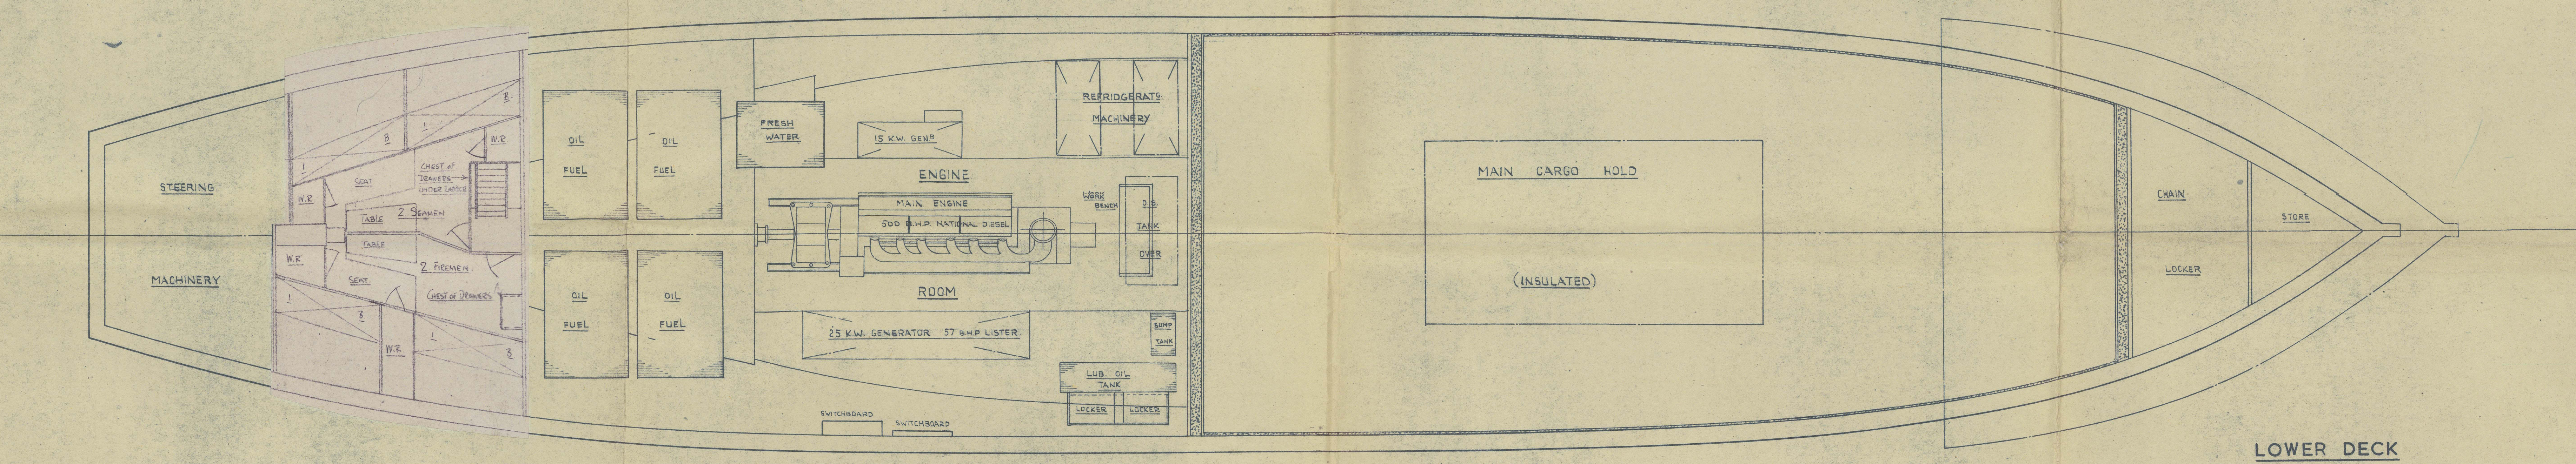


FORECASTLE DECK

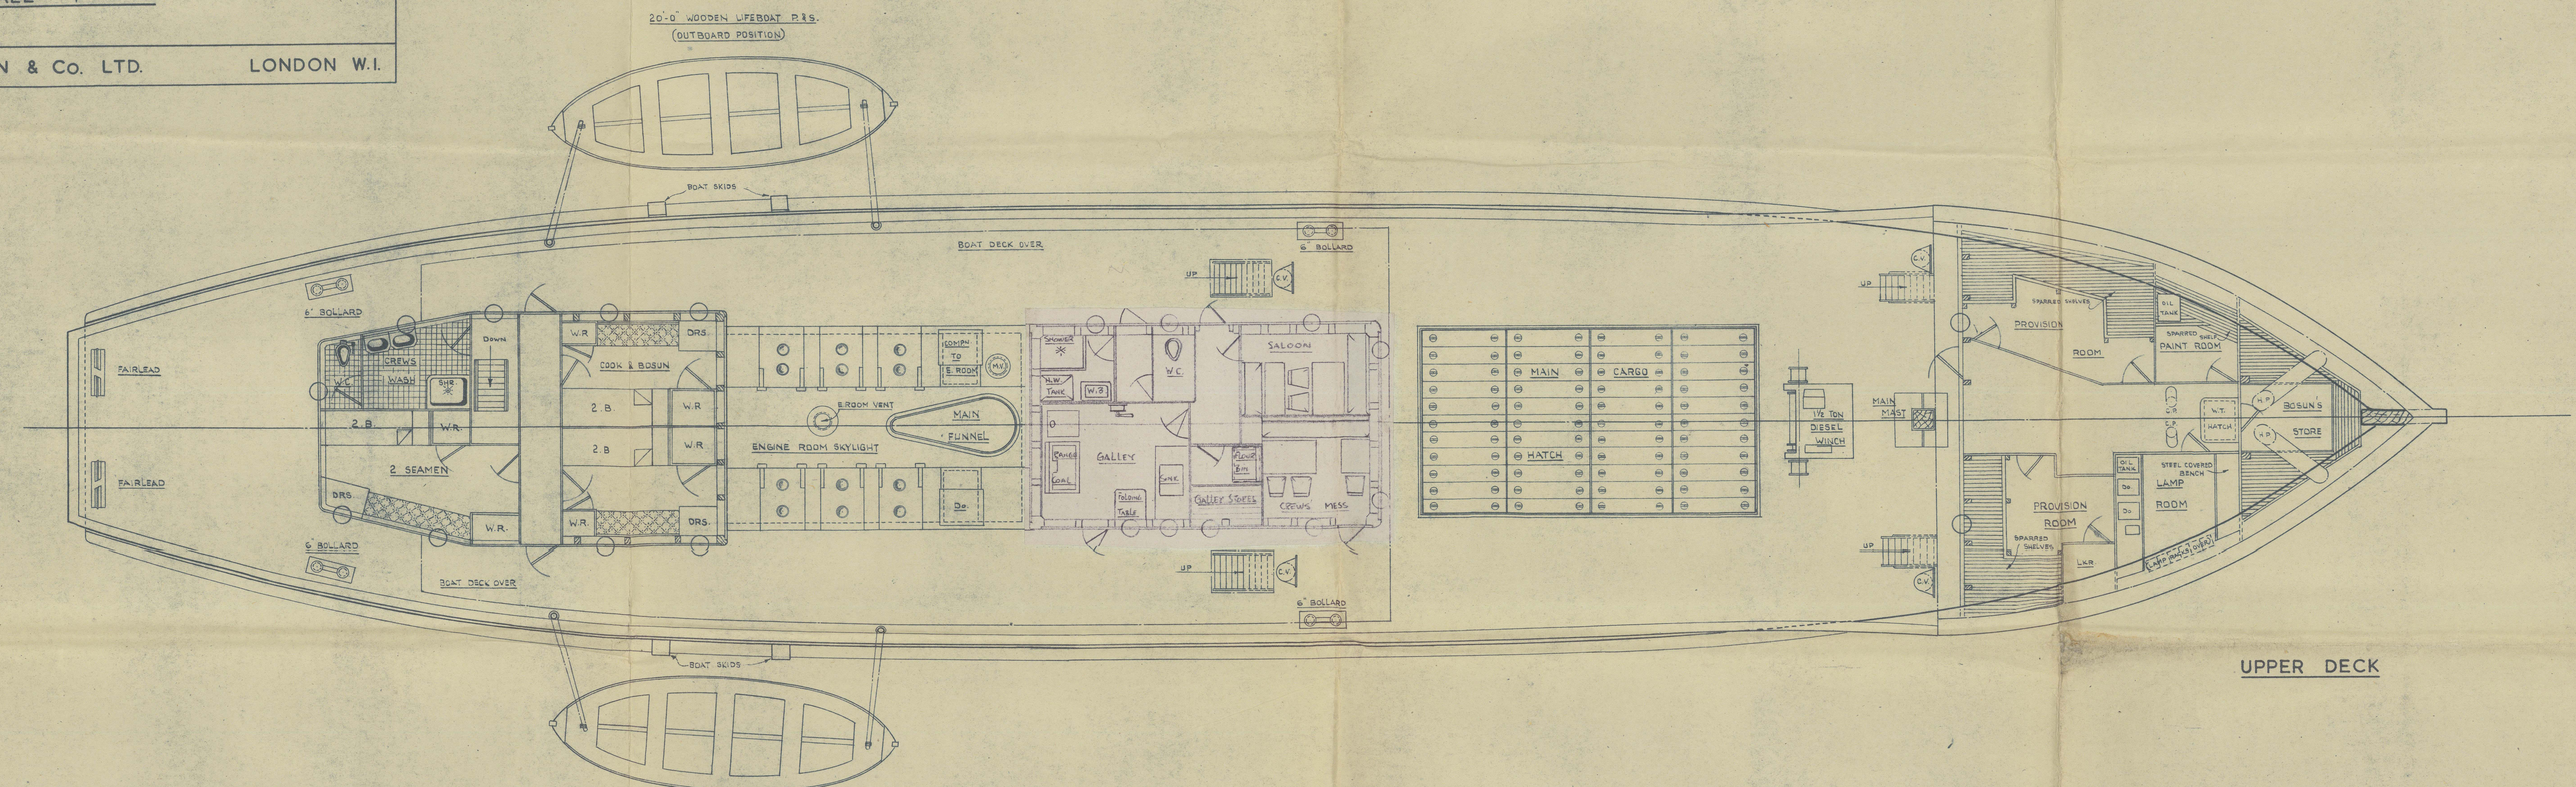

" ADMIRAL "  
GRENVILLE ★  
TORQUAY Rm 7908

GENERAL ARRANGEMENT

RECORDS DEPT.,  
LONDON

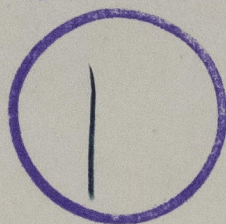

LOCKER



© 2021

Lloyd's Register  
Foundation

014984-014995-0028