

# T.S.S. MARELLA


## MIDSHIP SECTION.

SCALE - 1/2" = 1'00"

17 12 20

WORTH & ENGINEERING CO. LTD.  
11-5-21

11-5-21

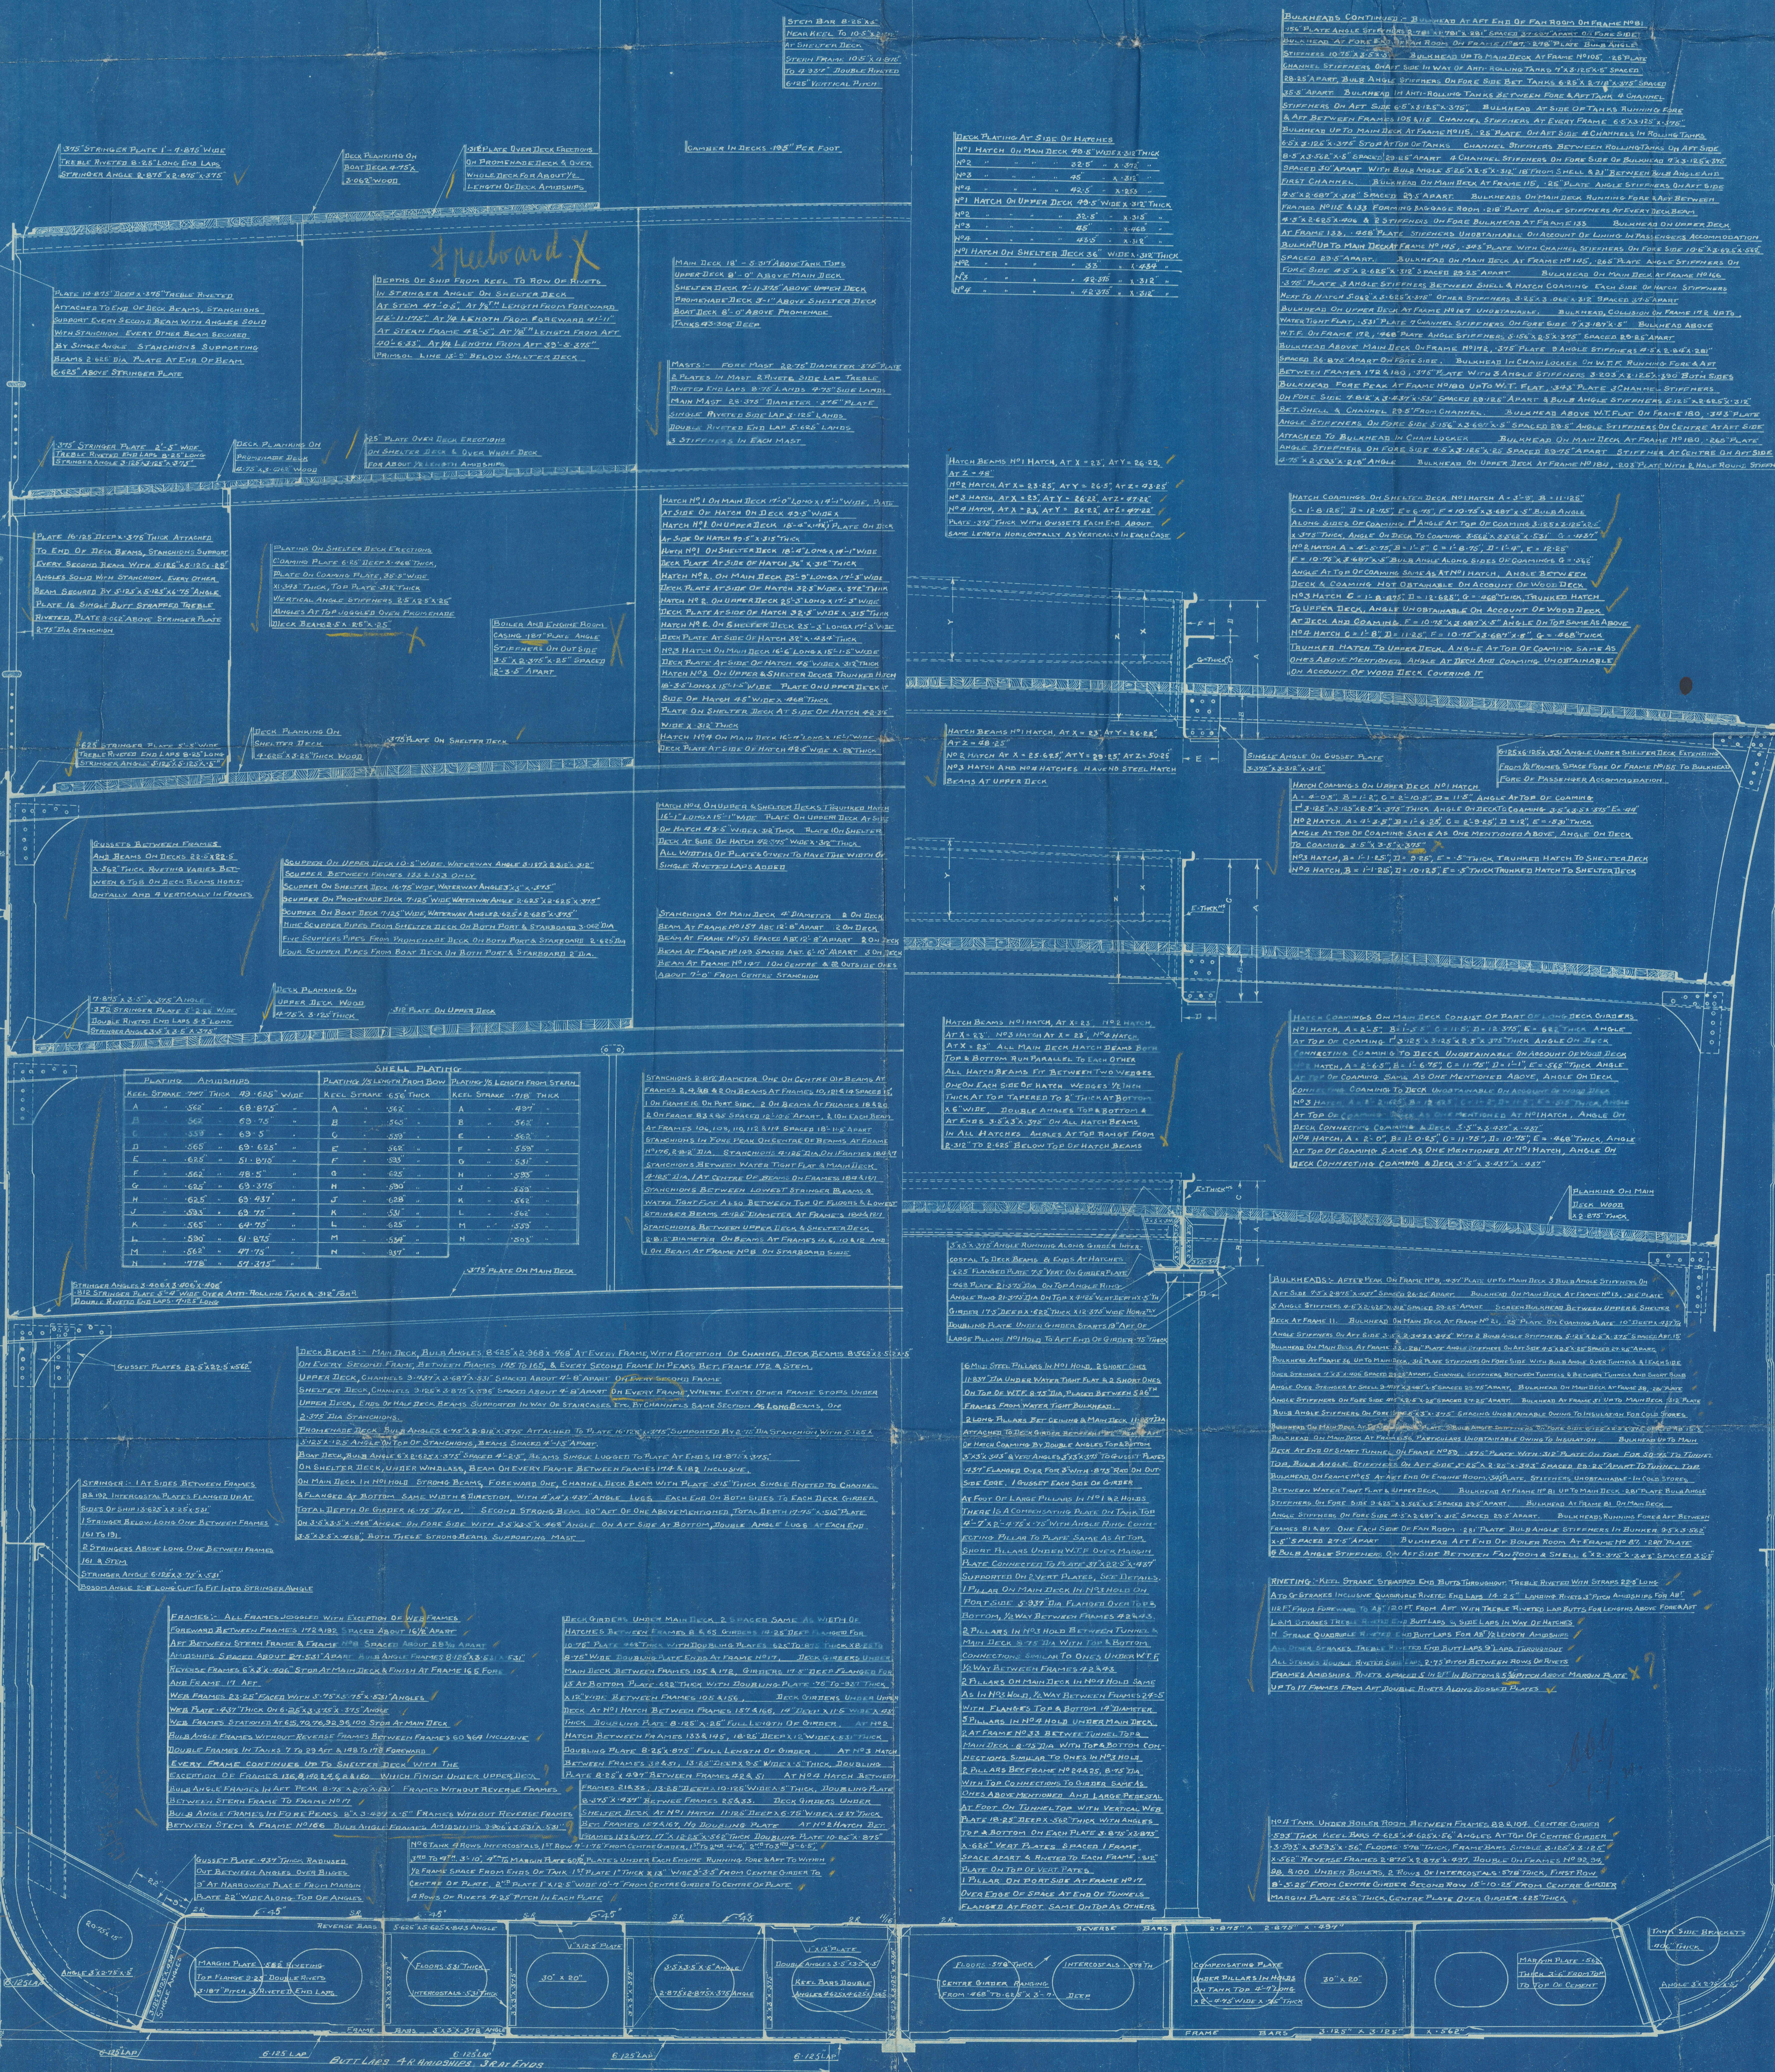

MOULDED DEPTH TAKEN IN THE PRESENCE OF A CURRENT  
BY LEAD SURVEY 39' 0 3/4"


DEPTH FROM TOP OF SHUTTER DECK BEAMS  
MIDSHIP TO CE STRAKE OF TACKLE TOP RAILING 35' 4 1/2"

"MARELLA

EX "WAHEHE".

Sydney 6908.

MIDSHIP. SECTION.

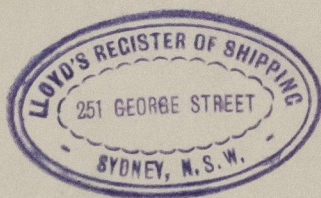

© 2021

Lloyd's Register  
Foundation

015004-016219-2027