



ENCLOSURE
361

SHIP No 1373.

STRUCTURAL SECTIONS.

EQUIPMENT.

1 STOCKLESS BOWER ANCHOR 4 CWTs.

60 FATHOMS $\frac{3}{4}$ " STUD LINK CABLE.

60 " 5" MANILLA HAWSER

60 " 22" " WARP.

DIMNS. 80'-0" B.P. x 21'-6" MLD. x 10'-9" MLD.

TO CLASS A.I. (FOR TOWING SERVICES ON THE RIVER THAMES.)

STEEL SCREW MOTOR TUG.

— SCALE - $\frac{1}{2}$ IN. = 1 FT. —

RIVETING.

ALL SHELL LANDINGS TO BE SINGLE RIVETED EXCEPT SHEERSTRAKE WHICH IS TO BE DOUBLE RIVETED.

ALL SHELL BUTTS TO HAVE DOUBLE RIVETED STRAPS.

ALL BULWARK BUTTS TO HAVE SINGLE RIVETED STRAPS.

DECK SEAMS TO BE LAPPED & SINGLE RIVETED.

BUTTS OF STRINGER PLATE TO HAVE DOUBLE RIVETED STRAPS.

SHELL, DECK & BULKHEADS $\frac{3}{4}$ " DIA. RIVETS.


KEEL, STEM & STERNFRAME 1" " "

CASING & DECKHOUSES $\frac{5}{8}$ " " "


ENGINE SEATING $\frac{3}{4}$ " & $\frac{7}{8}$ " DIA. RIVETS (SEE SEPARATE PLAN)

SHELL FLANGE OF GUNWALE BAR $\frac{7}{8}$ " DIA. RIVETS,

ALTERNATE RIVETS THROUGH BEADING.

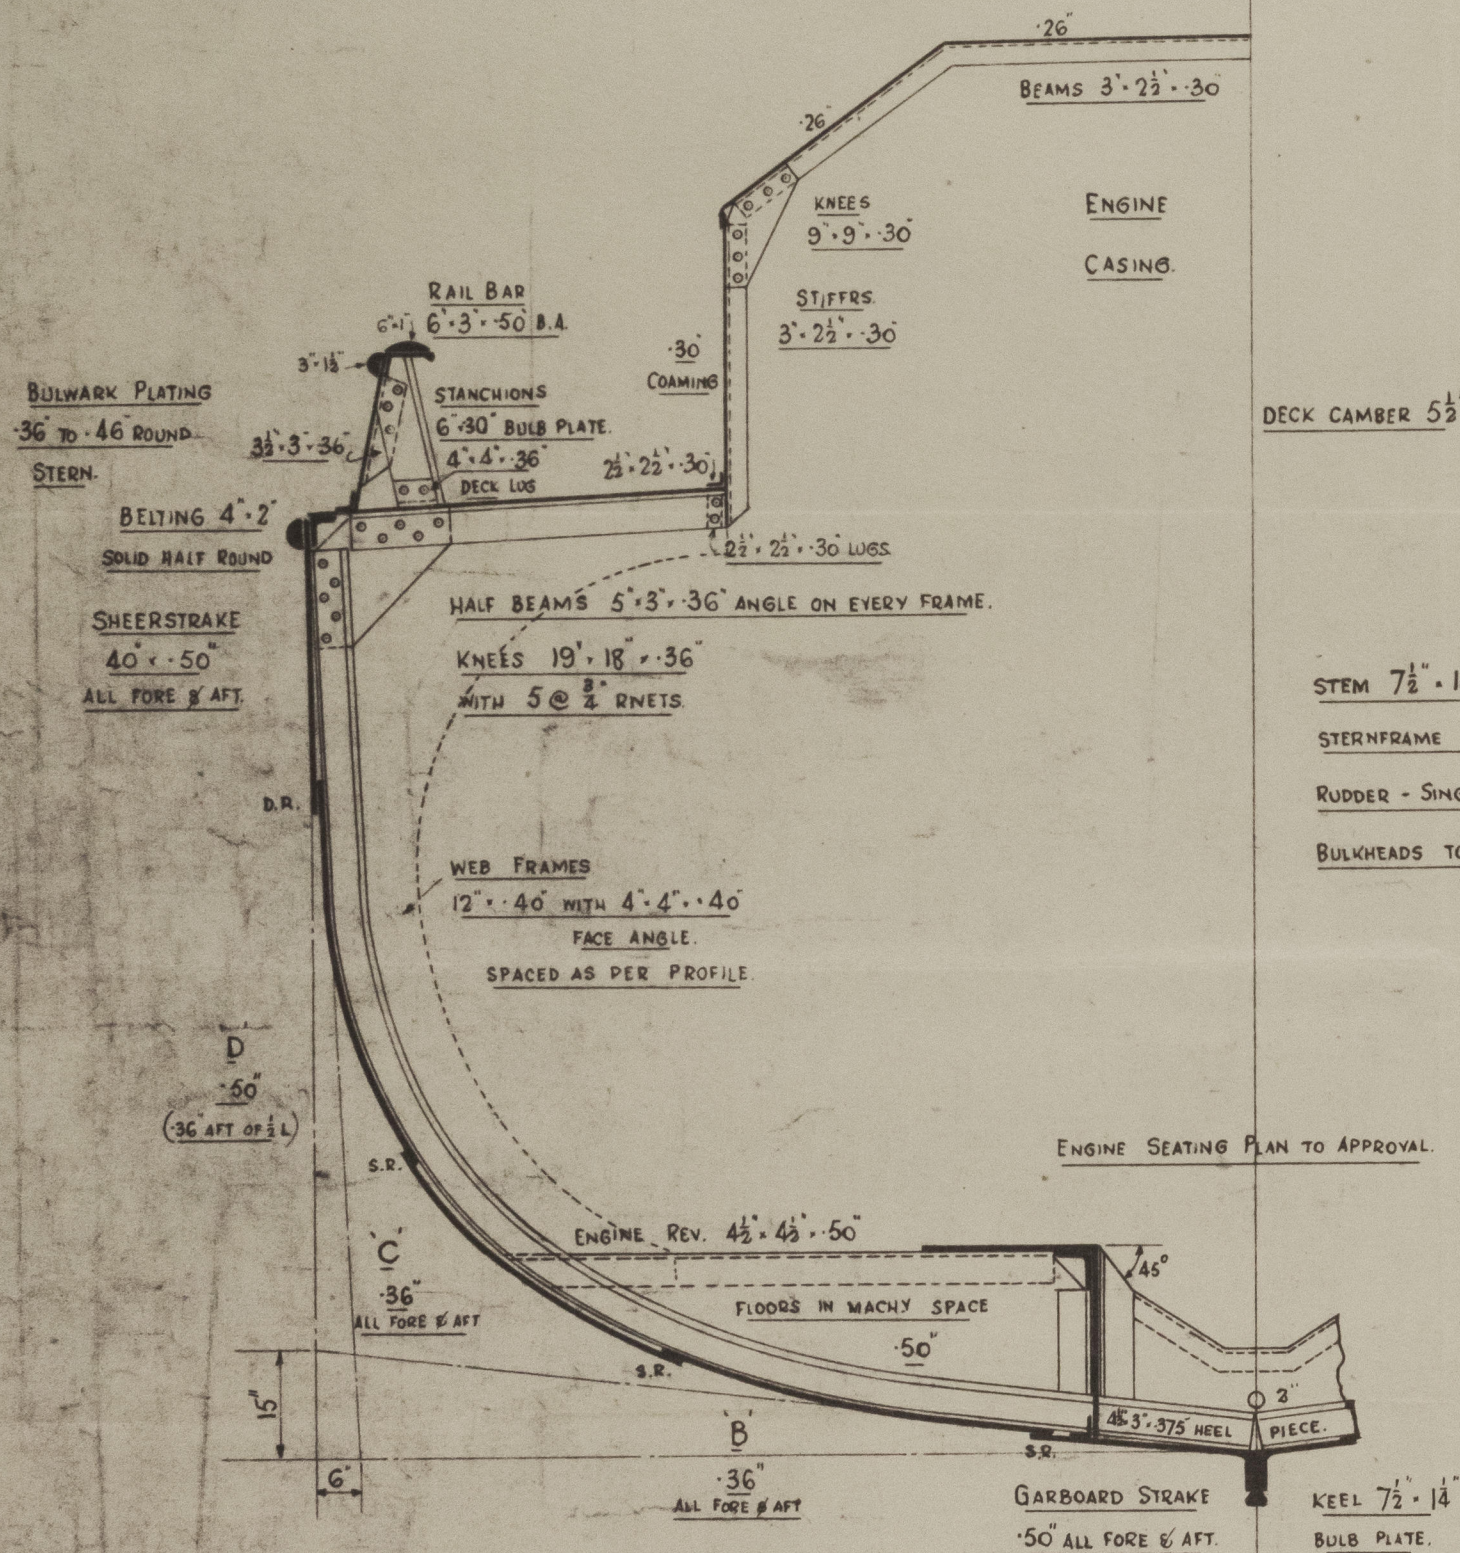

SECTION IN MACHINERY SPACE.

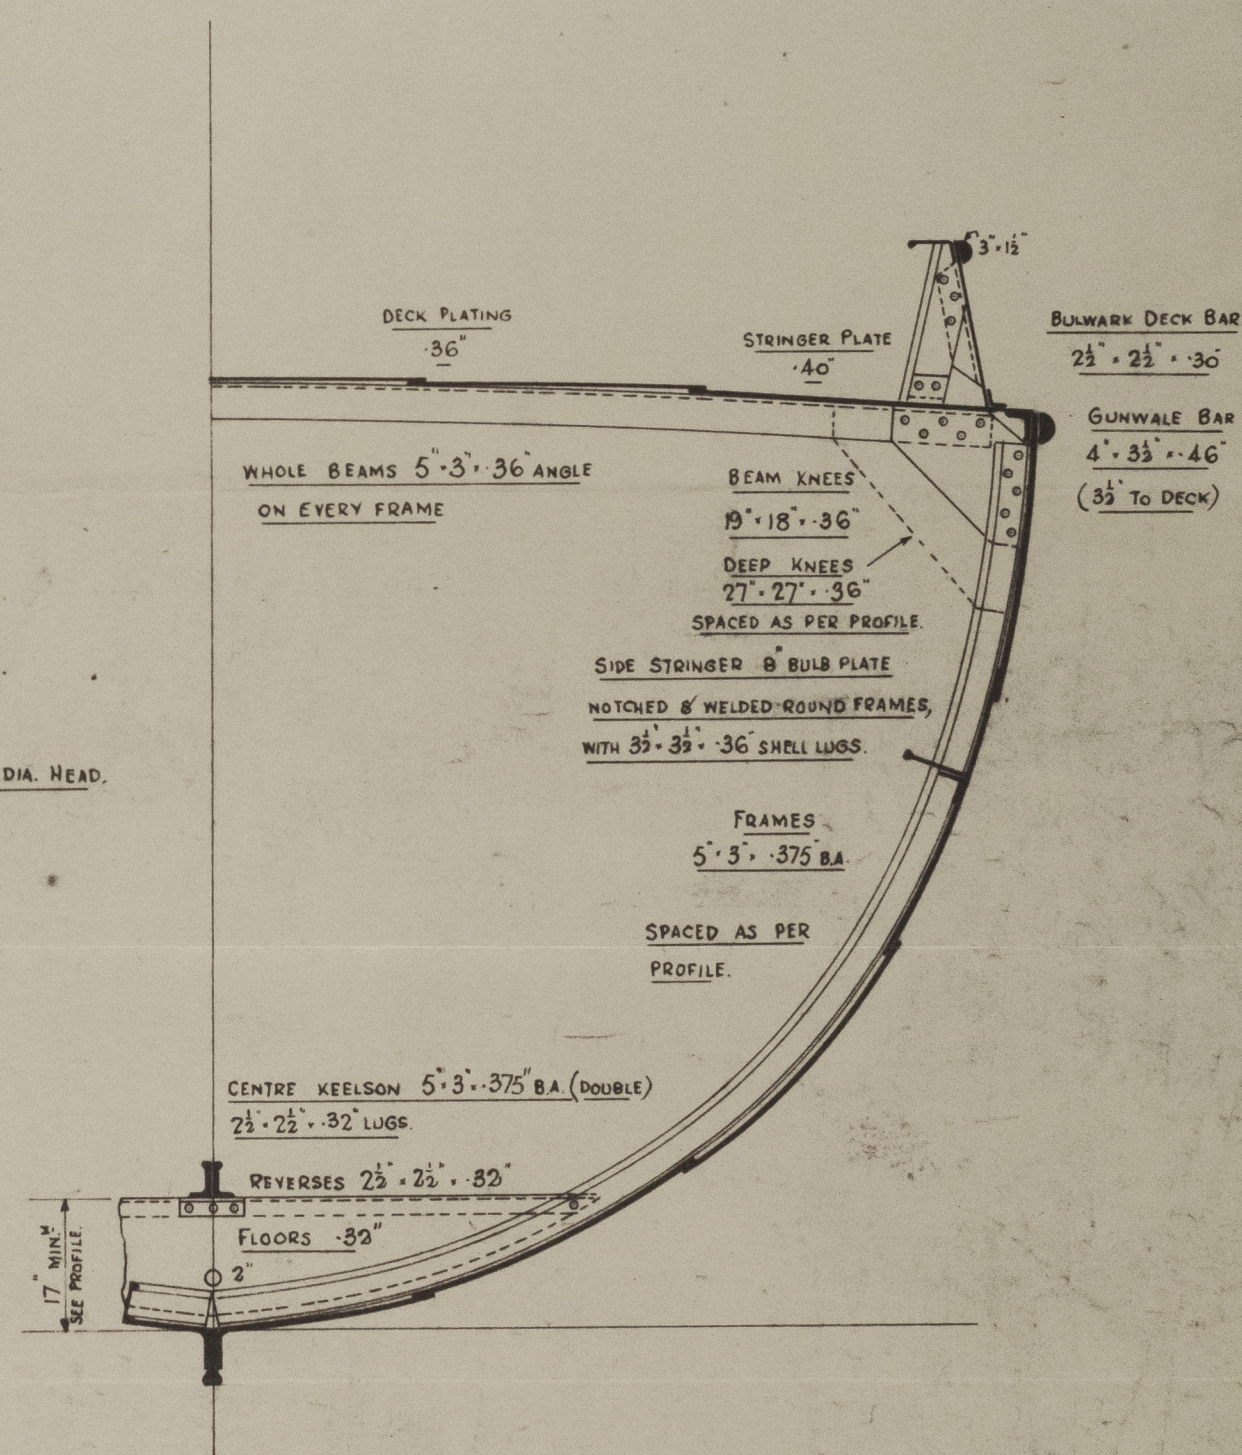

SECTION FOR'D OF MACHINERY SPACE.




© 2021

Lloyd's Register
Foundation

015 004-015 004-0110

Yug "RANA" ★

Cochrane & Sons, Ltd.,
Yard No. 1373.

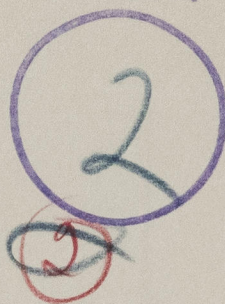

HULL let Pat. Ret. No. 58041

STRUCTURAL SECTIONS. (as built)



© 2021

Lloyd's Register
Foundation

015009-015019-0110