


SHIP No 1373.

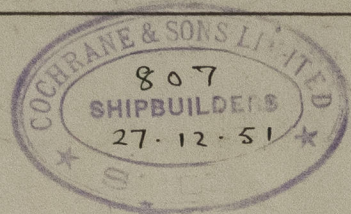


PROFILE & DECK.

STEEL SCREW MOTOR TUG.

DIMNS. 80'-0" B.P. x 21'-6" MLD. x 10'-9" MLD.

TO CLASS A.1. (FOR TOWING SERVICES ON THE RIVER THAMES)

SCALE - $\frac{1}{4}$ IN. = 1 FT.

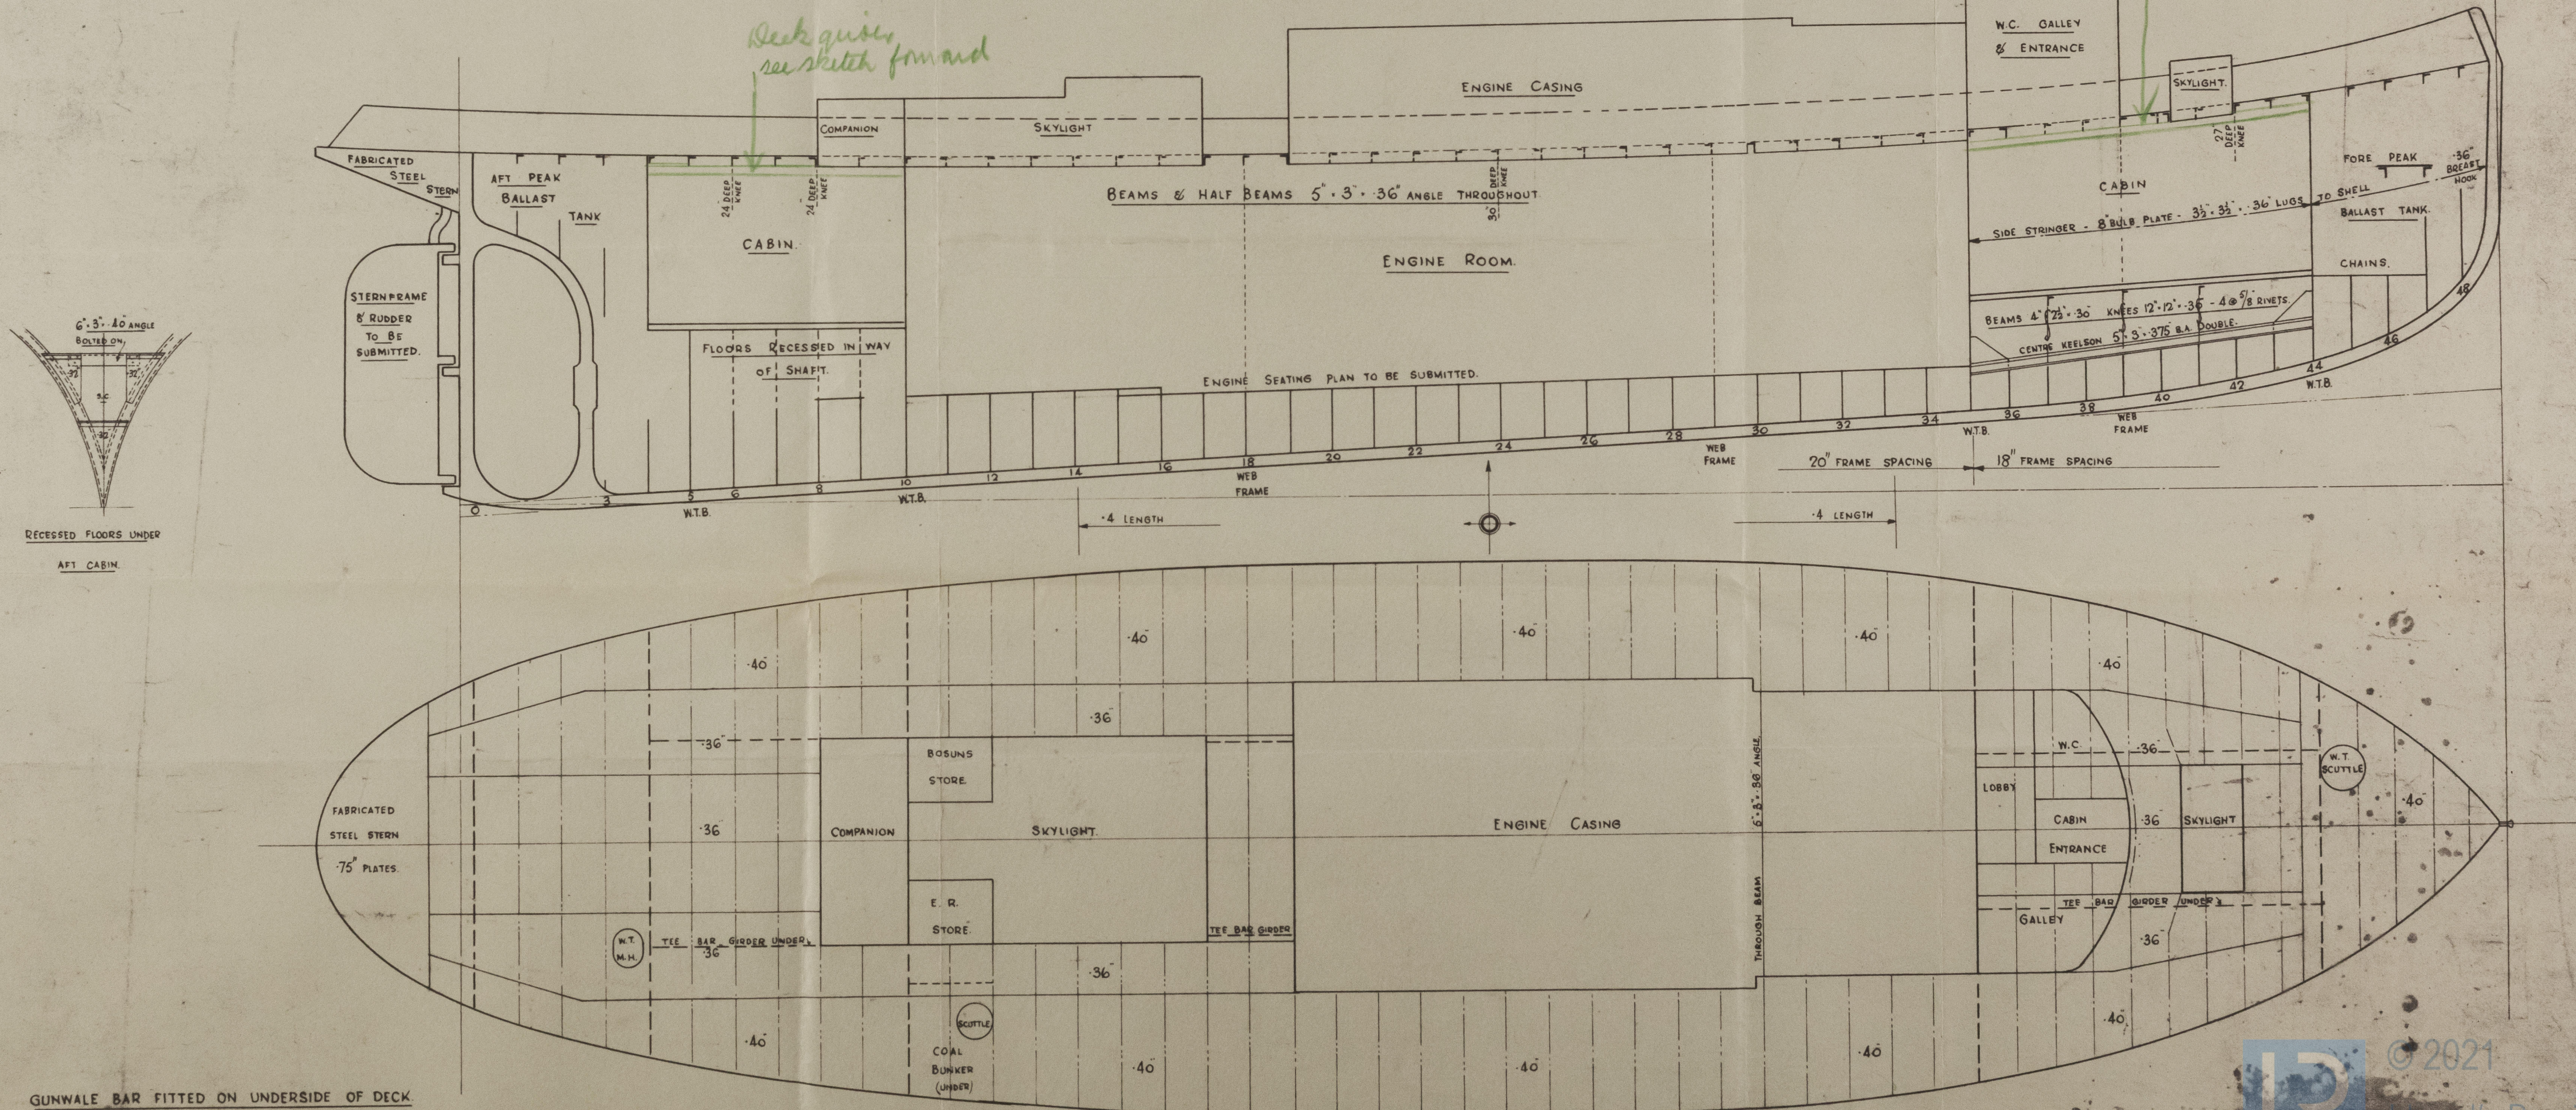

GUNWALE BAR FITTED ON UNDERSIDE OF DECK.

FRAMES & BEAMS CUT SHORT - SEE STRUCTURAL SECTIONS.


015004-015014-0112

RECORDS DEPT.,
LONDON

Tug "RANA"



Cochrane & Sons, Ltd.,
Yard No. 1373.

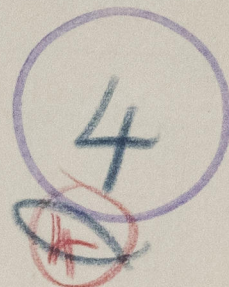

HULL 1st Int. Rpt. No. 58041

PROFILE & DECK (as built)



© 2021

Lloyd's Register
Foundation

015004-014019-012