


17 JAN 1951

# No 1373 STERNFRAME & RUDDER. 1" = 1 FOOT

FORGED STEEL  
TO LLOYDS TESTS

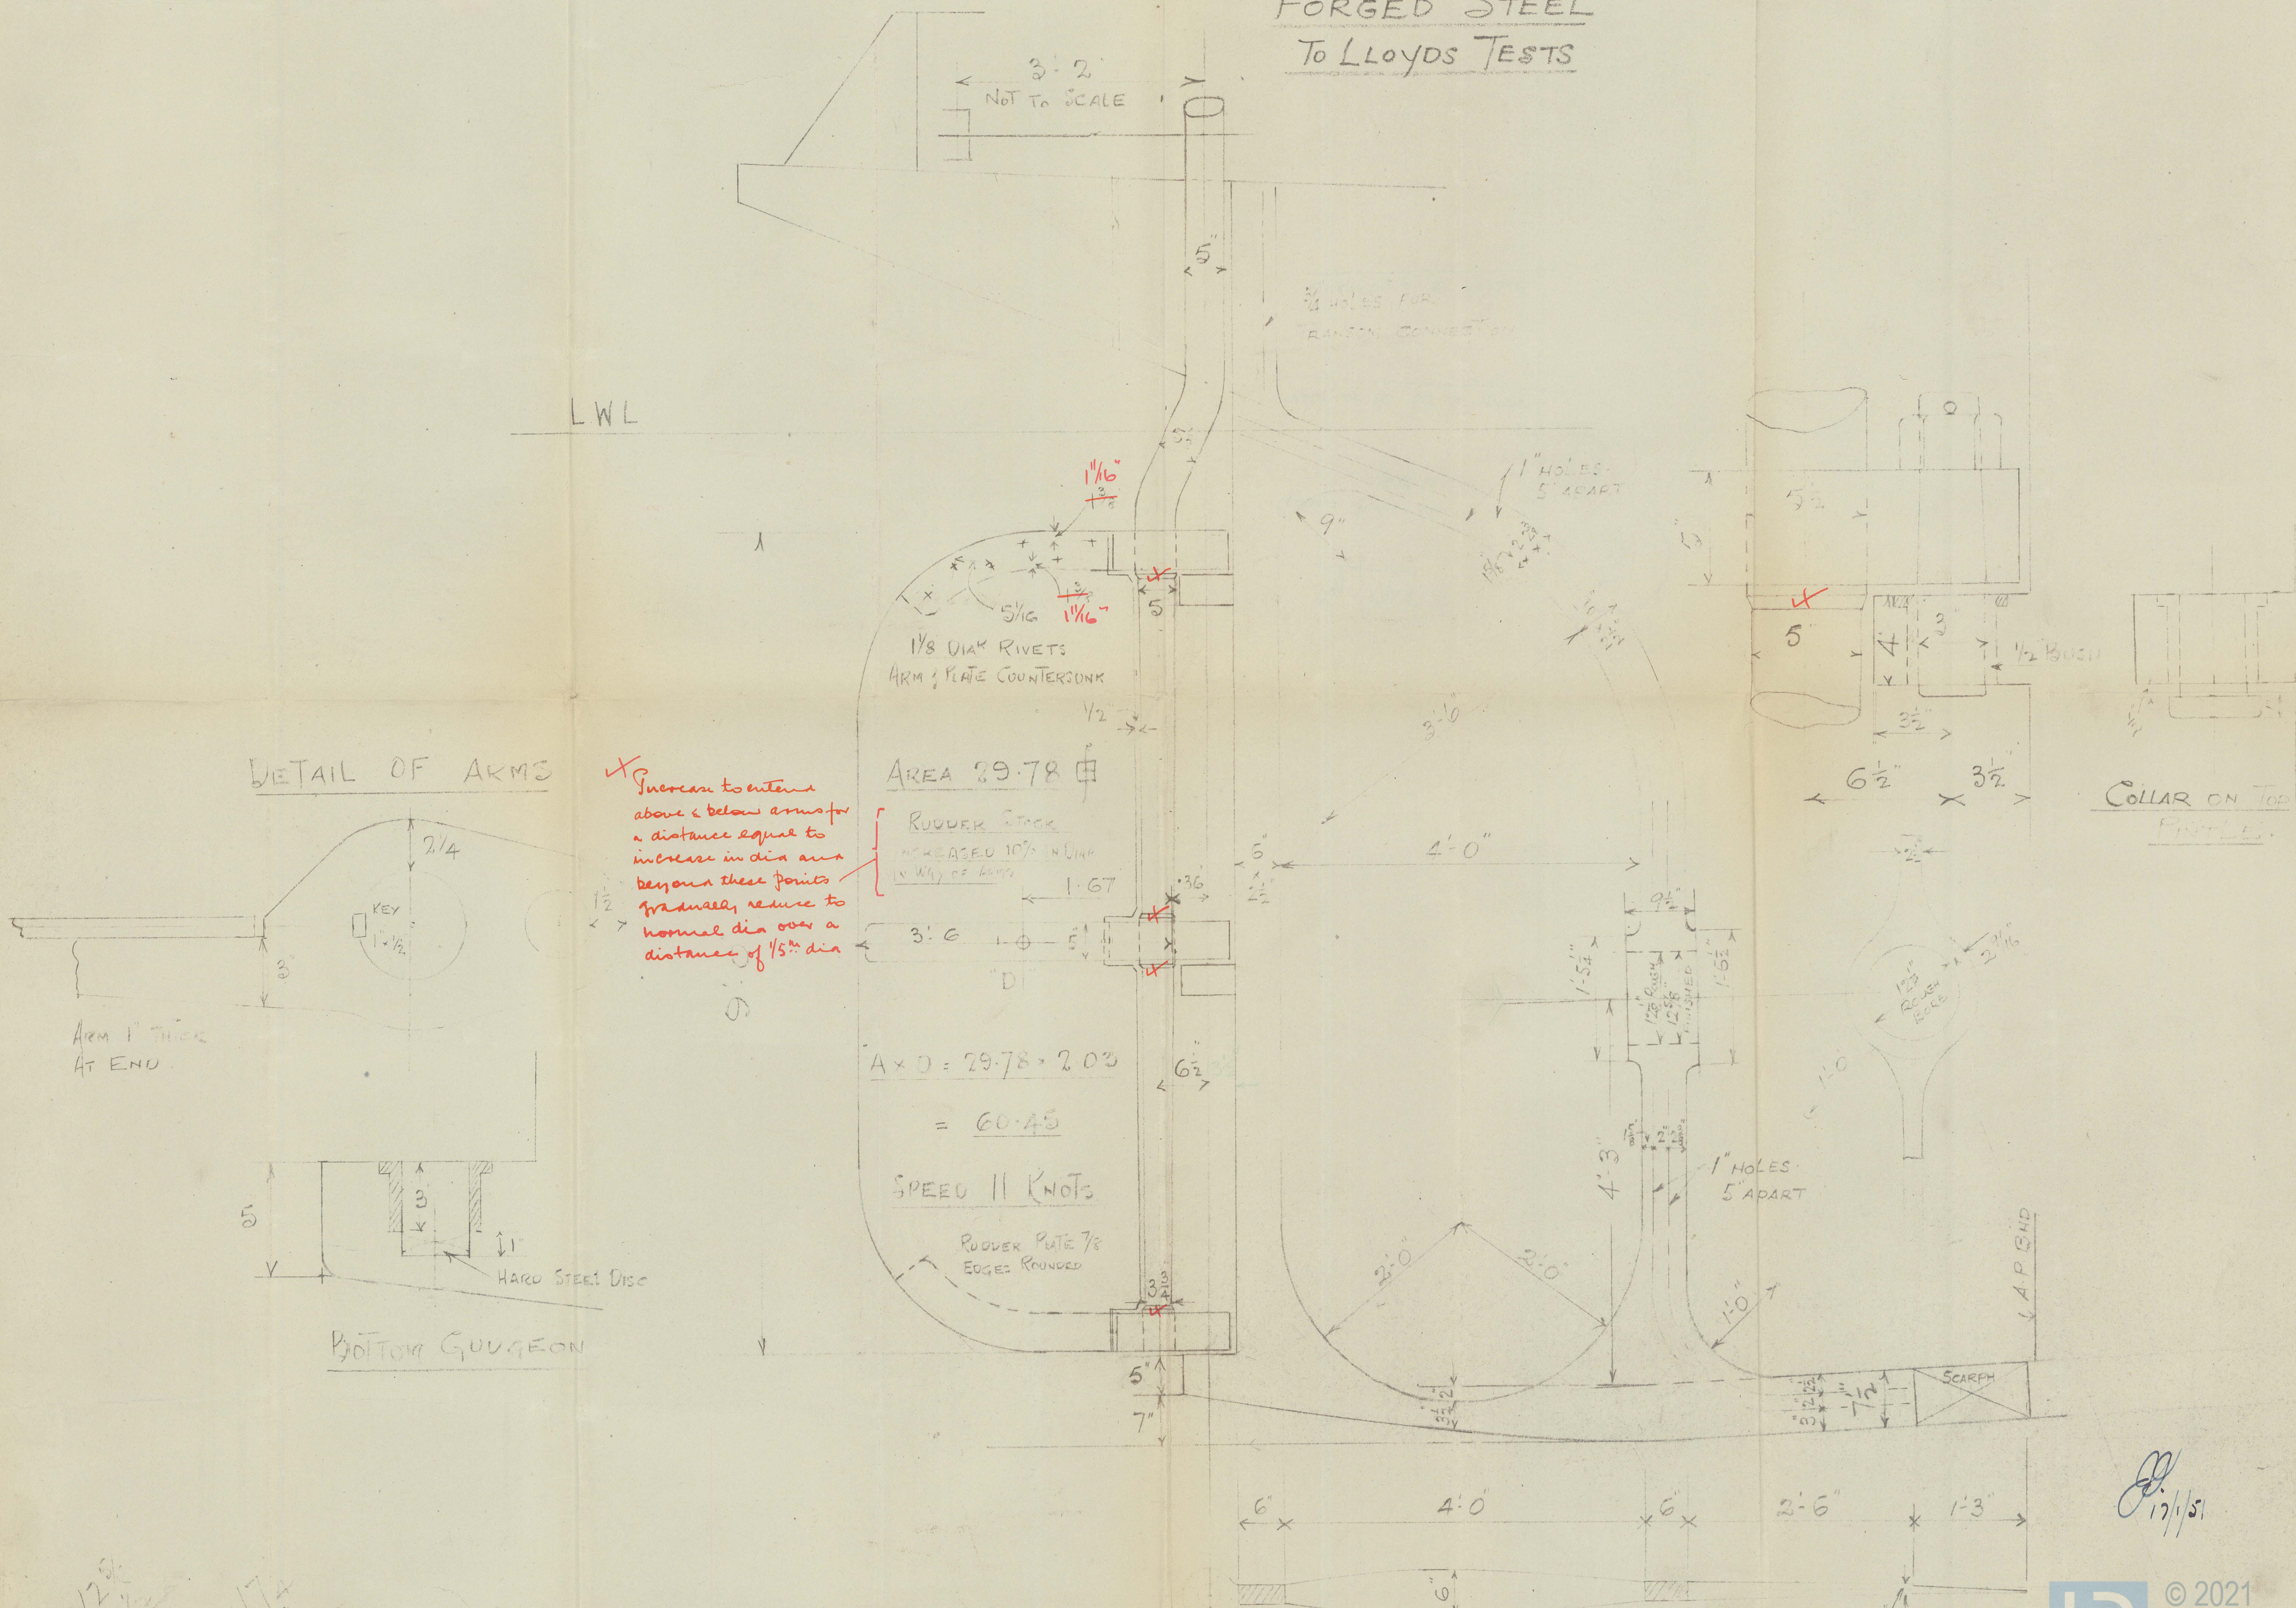

17/1/51



RECORDS DEPT.:  
LONDON

Yug "RANA"

5

Cochrane & Sons, Ltd.  
Yard No. 1373.

5

HULL wt Ent. Rpt. No. 58041

STERNFRAME & RODDER.




© 2021

Lloyd's Register  
Foundation

015004-01514-013



0113

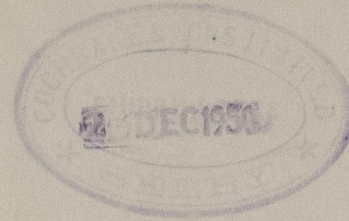

© 2021

Lloyd's Register  
Foundation



0113



© 2021

Lloyd's Register  
Foundation