


PRINCIPAL PARTICULARS	
LOA	82.300
LEP	37.000
BOW	13.200
DC	7.000
LC	6.000
GT	2,244.85
NT	1,224.17
SW	3,554.49

MAIN ENGINE 二重螺旋桨式 15
 BOILER 三層式水管式 26
 B.H.P. 1400 馬力
 SPEED 13.32 節
 (試運転時)

NO. OF CREW		
DECK	ENGINE	BUS
CAPTAIN	CHIEF ENG	PURSER
CHIEF OFF	1 ST ENG	CHIEF OPE
2 ND OFF	2 ND ENG	2 ND OPE
3 RD OFF	3 RD ENG	3 RD OPE
APP	APP	CLERK
BOAT	NO. OILER	CHIEF STEW
CARDS	S-K	NO. COOK
S-K	OILER	2 ND STEW
Q.M.	DONKEY	COOK
SAILOR	FIRE MEN	BOY
TOTAL	18	26

CREW TOTAL 50
 STATE ROOM 2

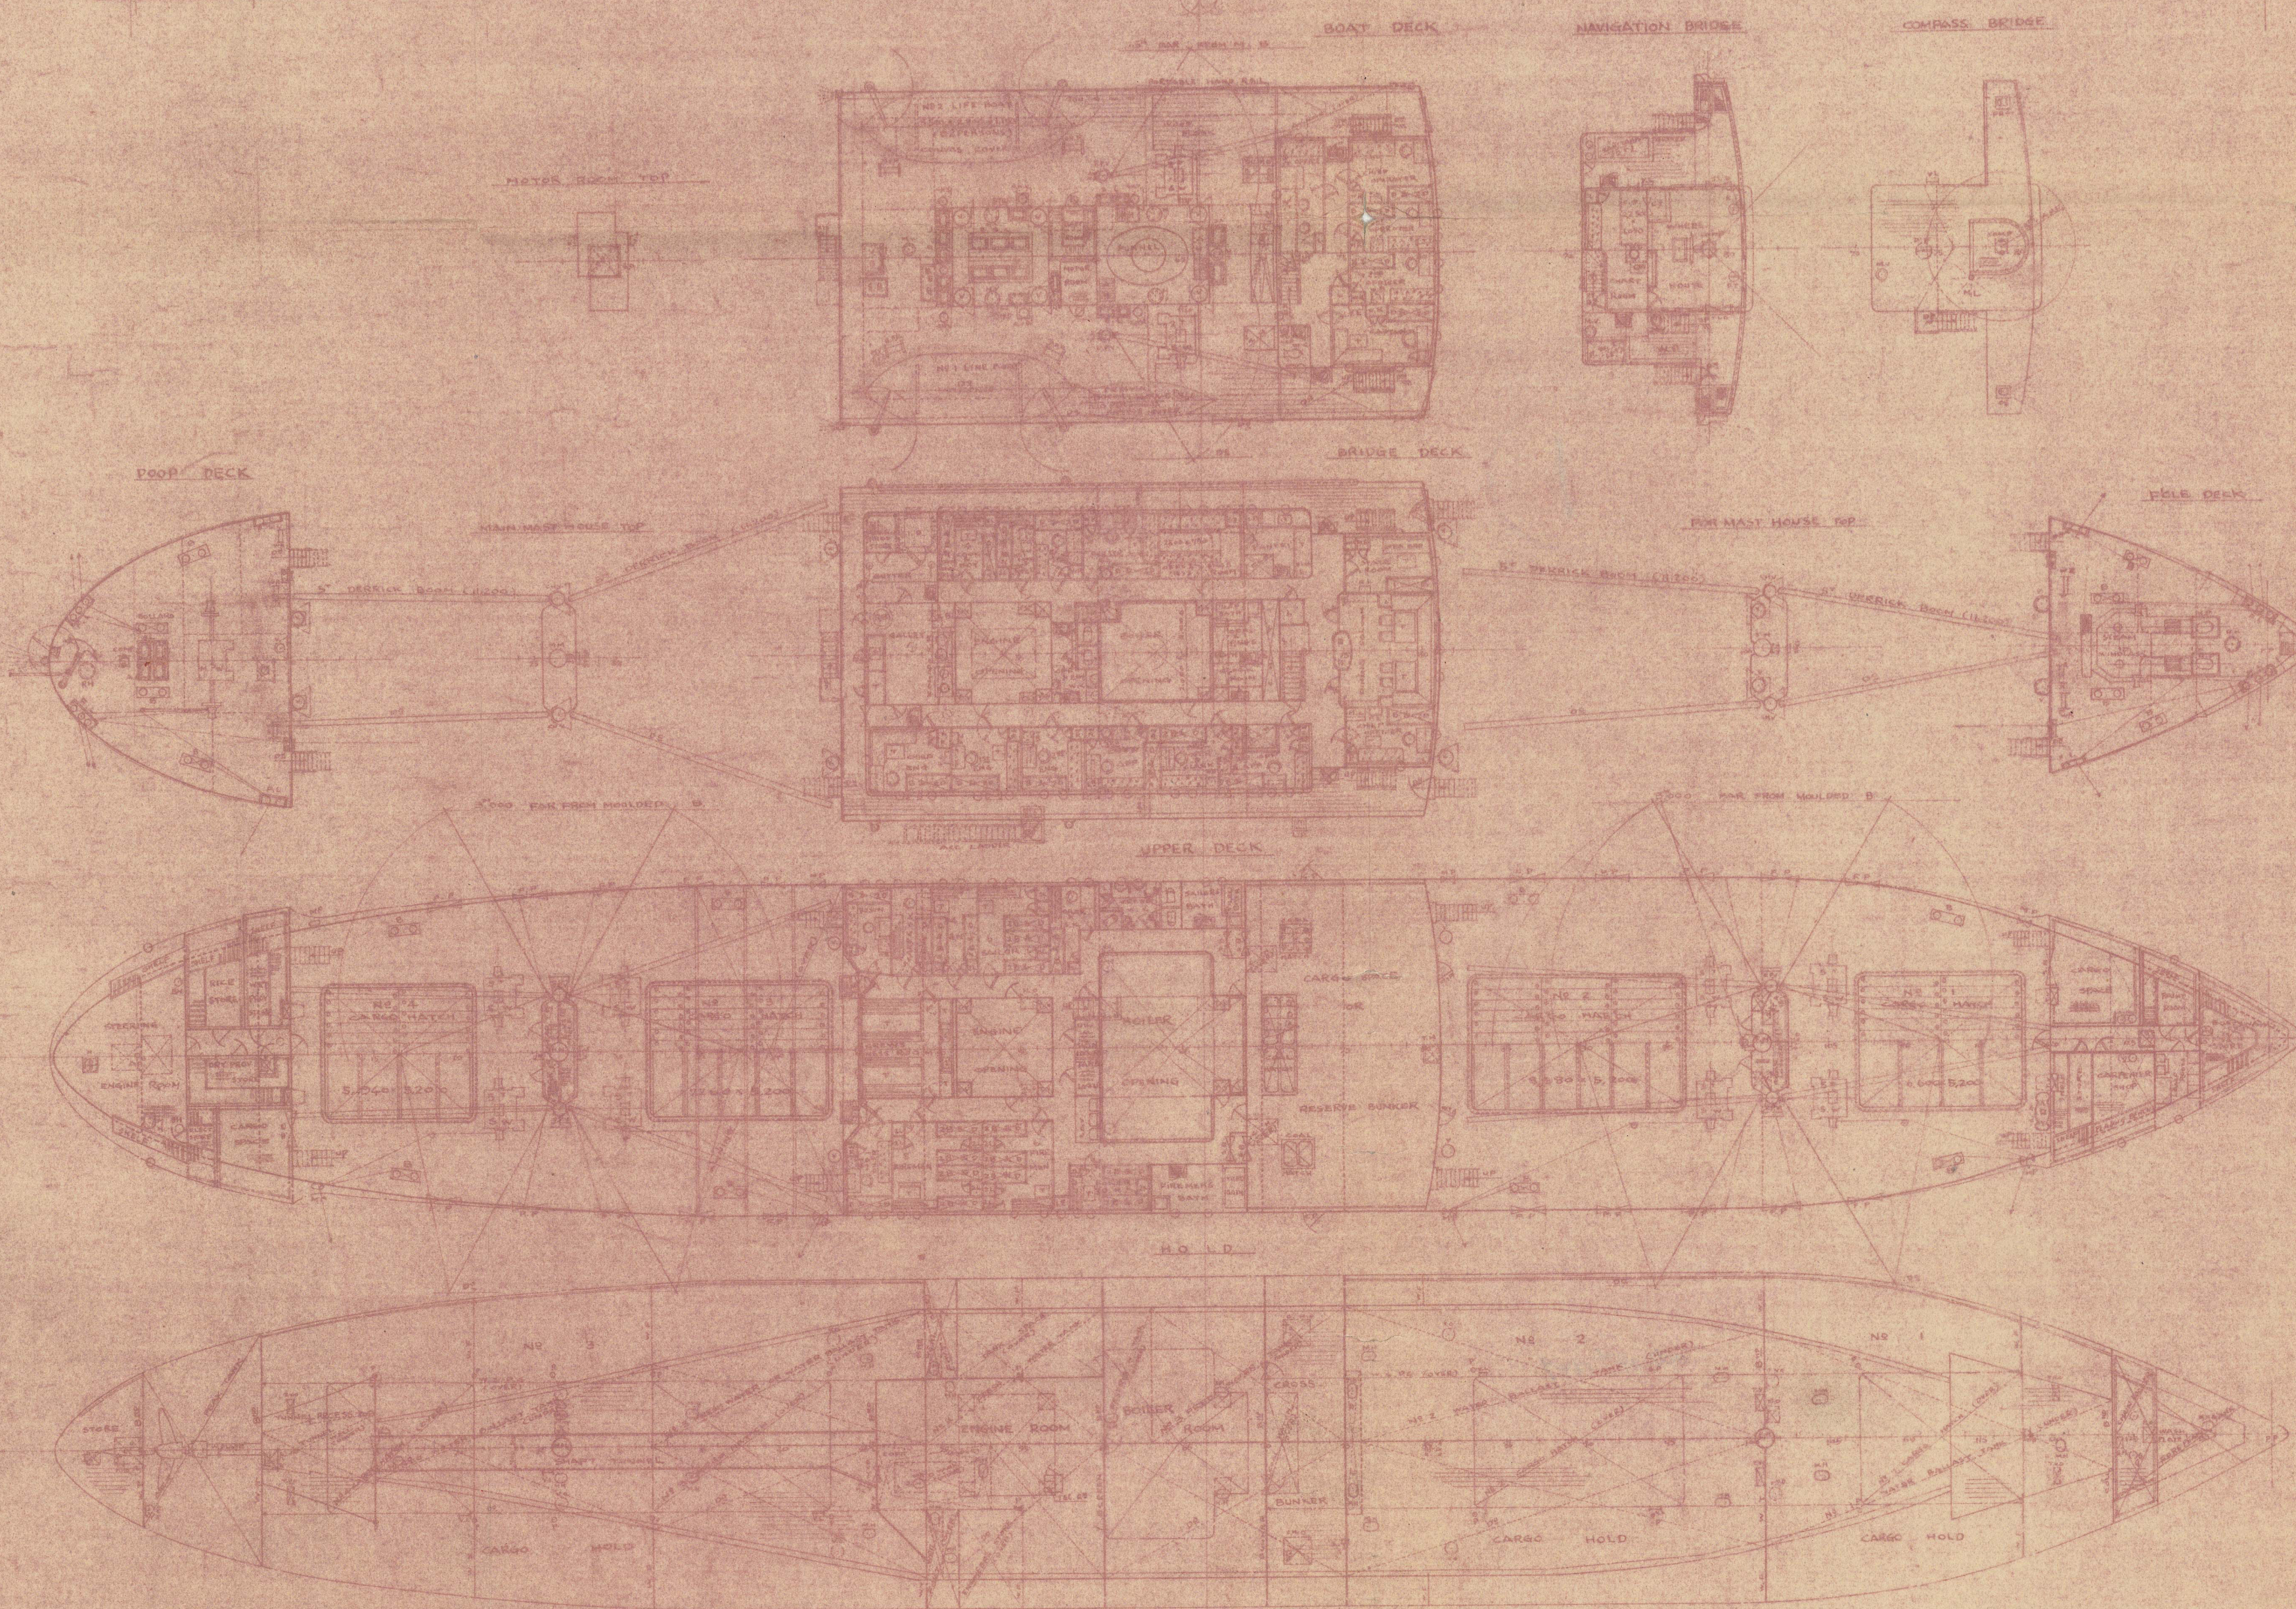

いくしま丸
 海根D. 8N 1408
 S.S. IKUSHIMA MARU

一般艙装圖
 完成
 GENERAL ARRANGEMENT

尺度 1:200
 重量法 87% 13.2% 7%



いししま丸

根D型 SN^o 1408

★ S.S. IKUSHIMA MARU

一般艀装圖

GENERAL ARRANGEMENT

完成

尺度 1: 200

重要寸法 87⁵/₁₆ - 132⁵/₁₆ 7⁵/₁₆










015004 345214 0245

RECORDS DEPT.
LONDON

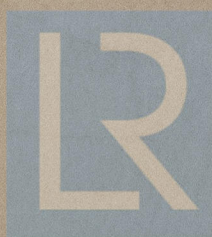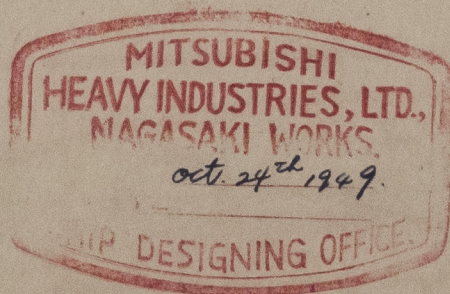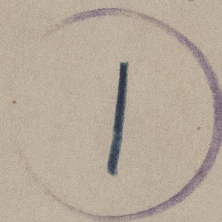

© 2021

Lloyd's Register
Foundation