

WM. CHALMERS & COY.  
LIMITED  
LIGHT DRAFT SHIPBUILDERS  
- RUTHERGLEN NEAR GLASGOW -  
12<sup>th</sup> MARCH 1912

30 MAR 1912

Approved ST  
for [signature]

N<sup>o</sup> 164-5.  
STERN FRAME & RUDDER.  
CAST STEEL.



SCALE 1" = ONE FOOT

TO BRITISH CORPORATION TESTS.

RIEVTS IN STERN FRAME 1/8" DIA SPACED 4" C.T.C. BELOW & 4 1/8" ABOVE BOSS.

ALL HOLES TO BE DRILLED AT FORGE BEFORE LEAVING.

POST & CENTRE LINE OF STOCK TO BE SQUARE TO BASE  
& TO BE A STRAIGHT LINE.

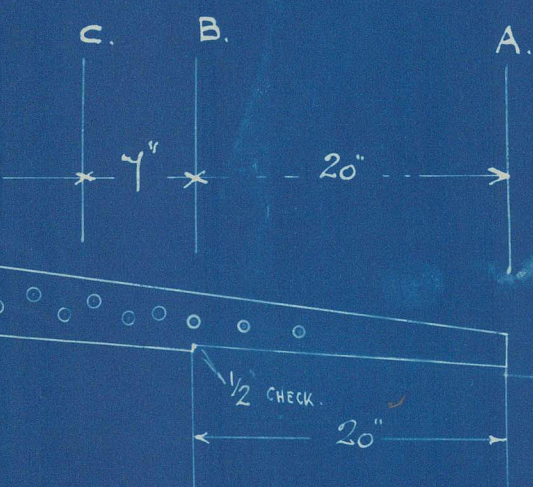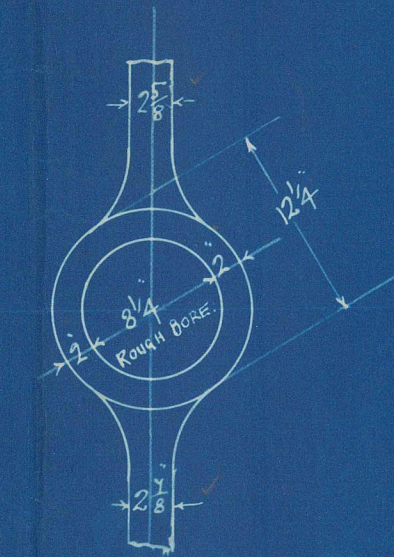

CUTS BASE AT 18' 5"

Checked & signed  
13<sup>th</sup> March 1912  
[signature]



W<sup>m</sup> Chalmers & Co  
No 164-5

Stern Frame & Rudder

$\frac{S}{S}$  Innes Lannon  
*now Strutton Croft.*

$\frac{S}{S}$  Innes Strathall

(14)



© 2021

Lloyd's Register  
Foundation

06010-015025-0002