

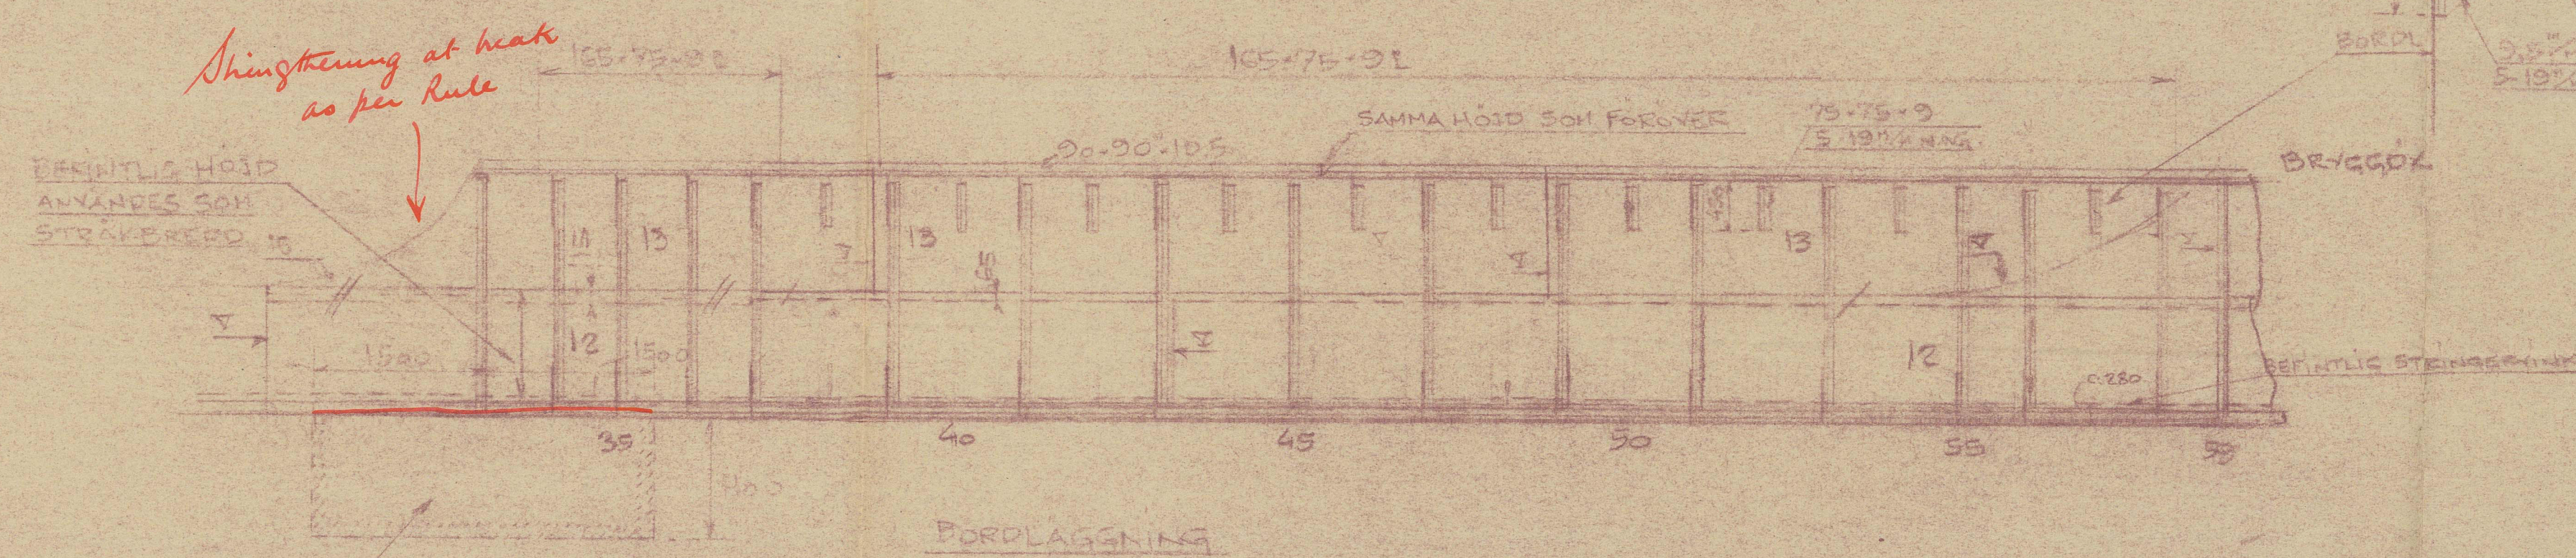


[illegible]


for Upper deck
Stringer.

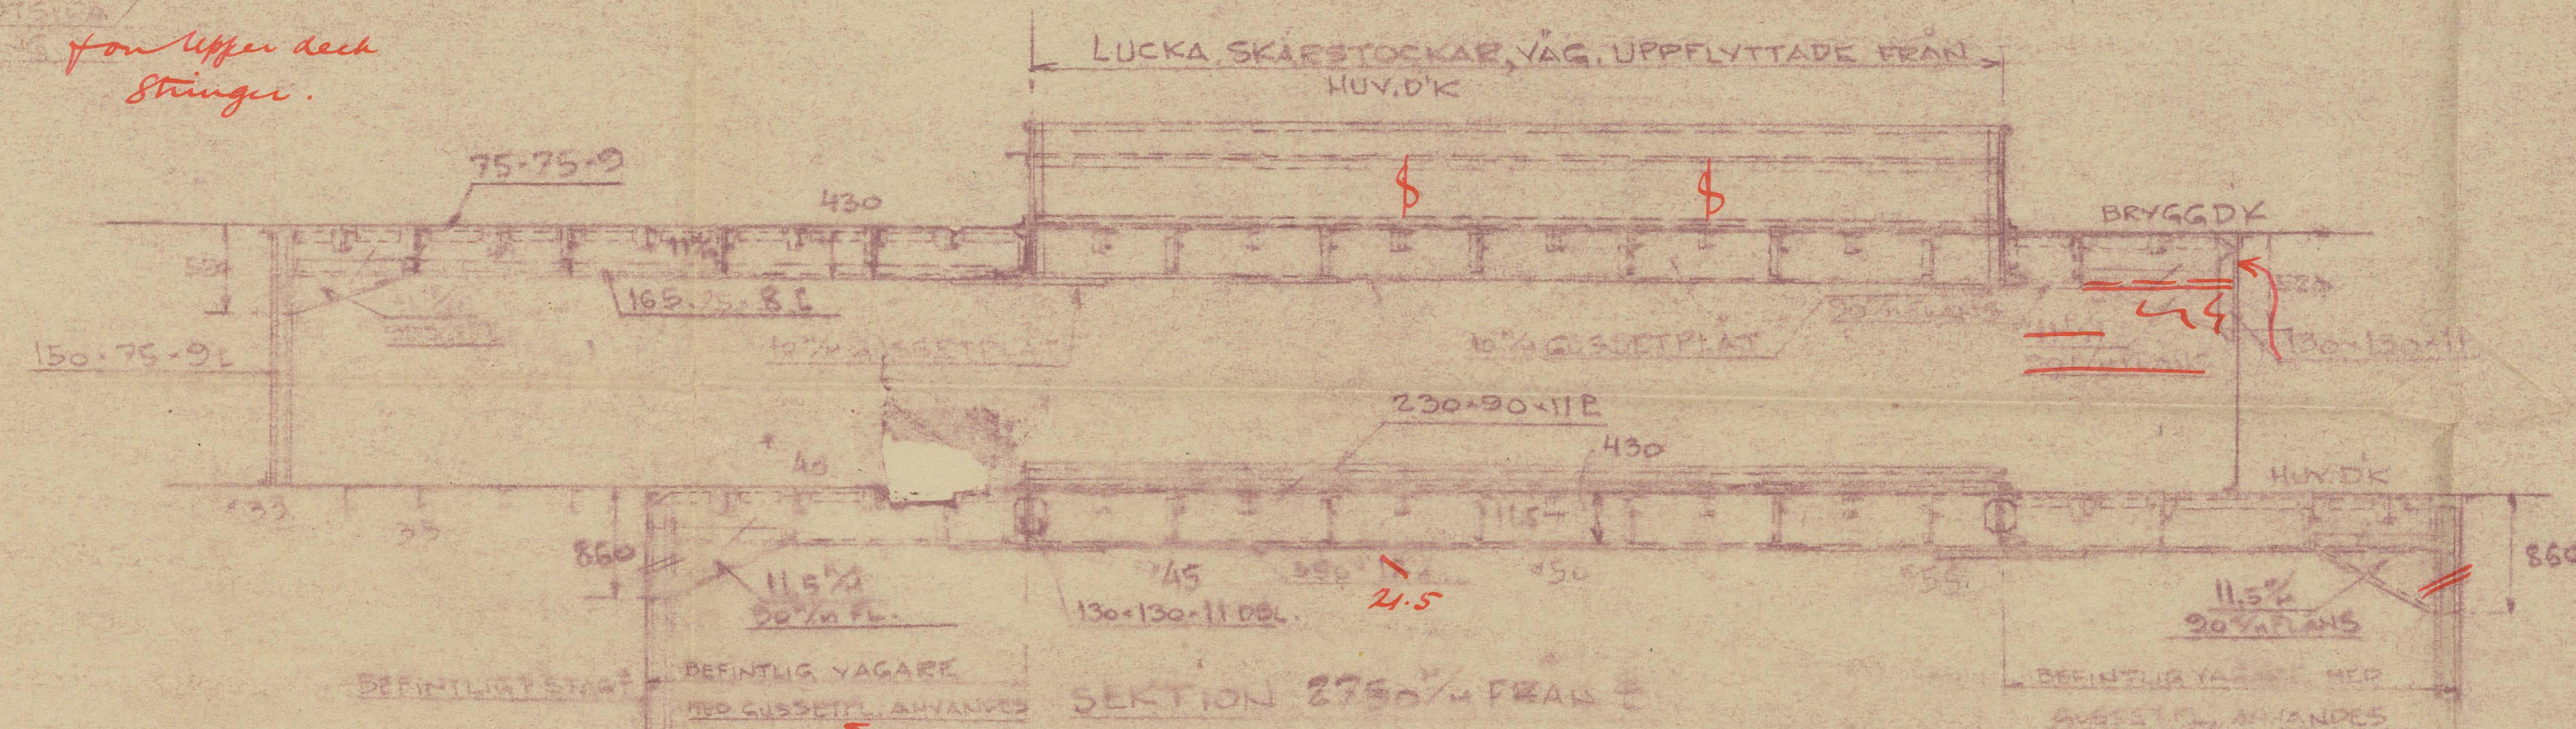


See notes p. 18

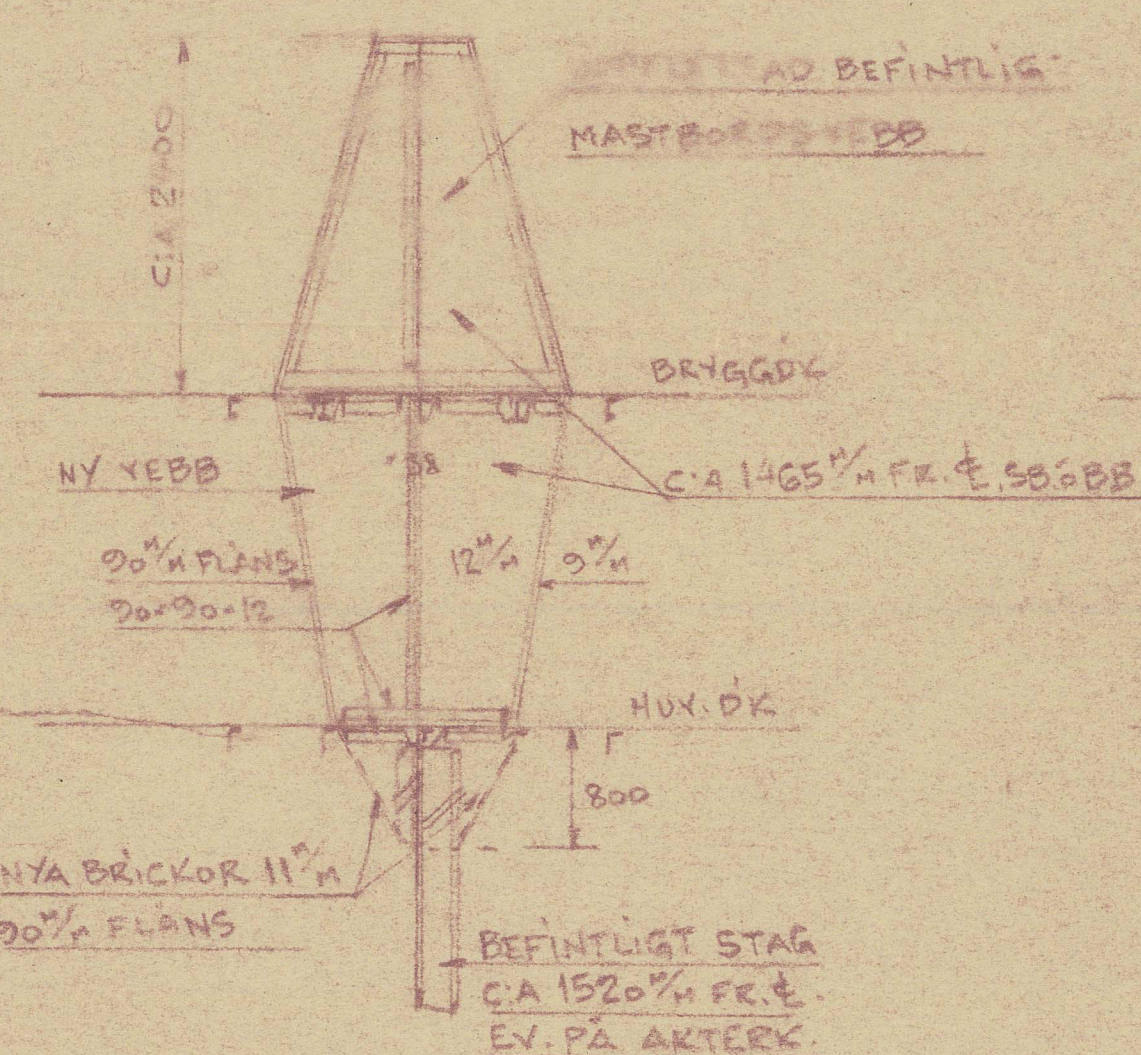


OBS! MELLANLIGGANDE VEBBAR
C/A 440% FR. 2.58.08 INGEN
EXTRA UPPSTÖTTNING

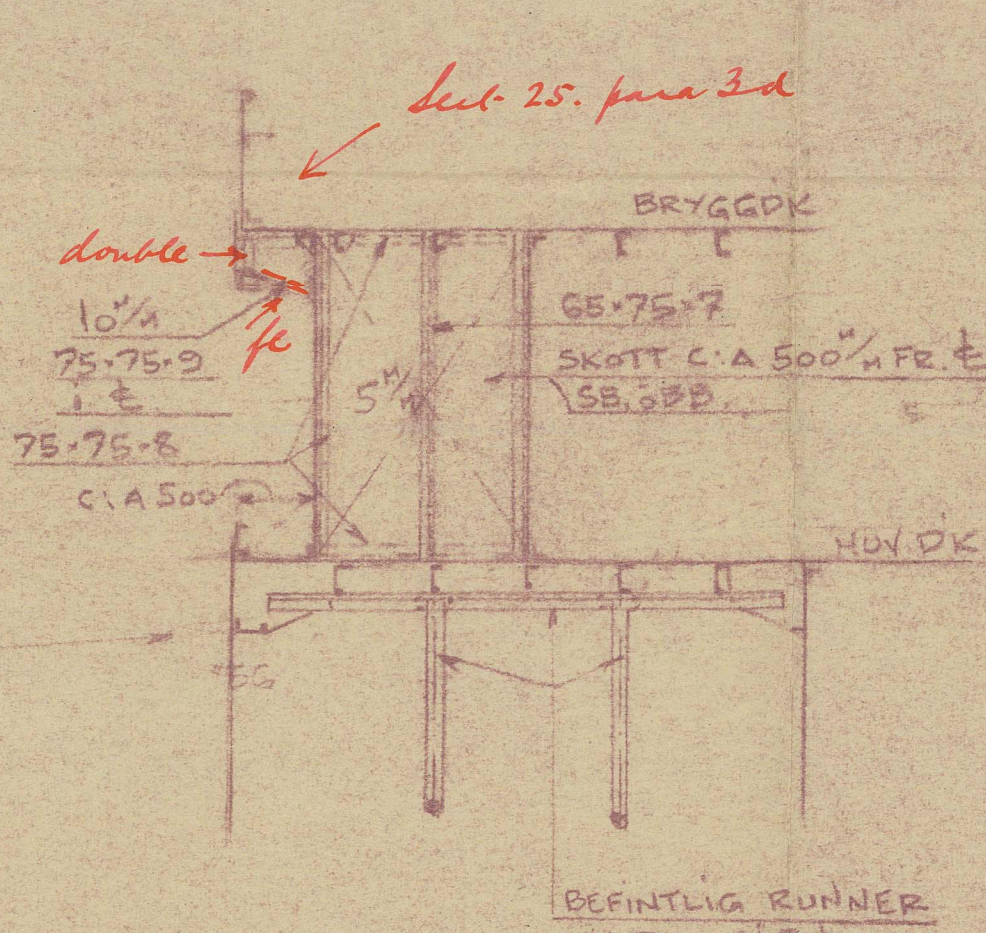

BEFINTLIG RUNNER

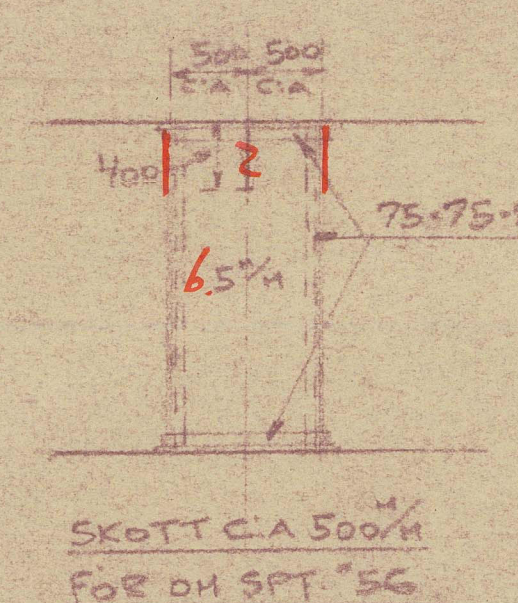

SKOTT C. A 500^M
FOR DM SPT. "50

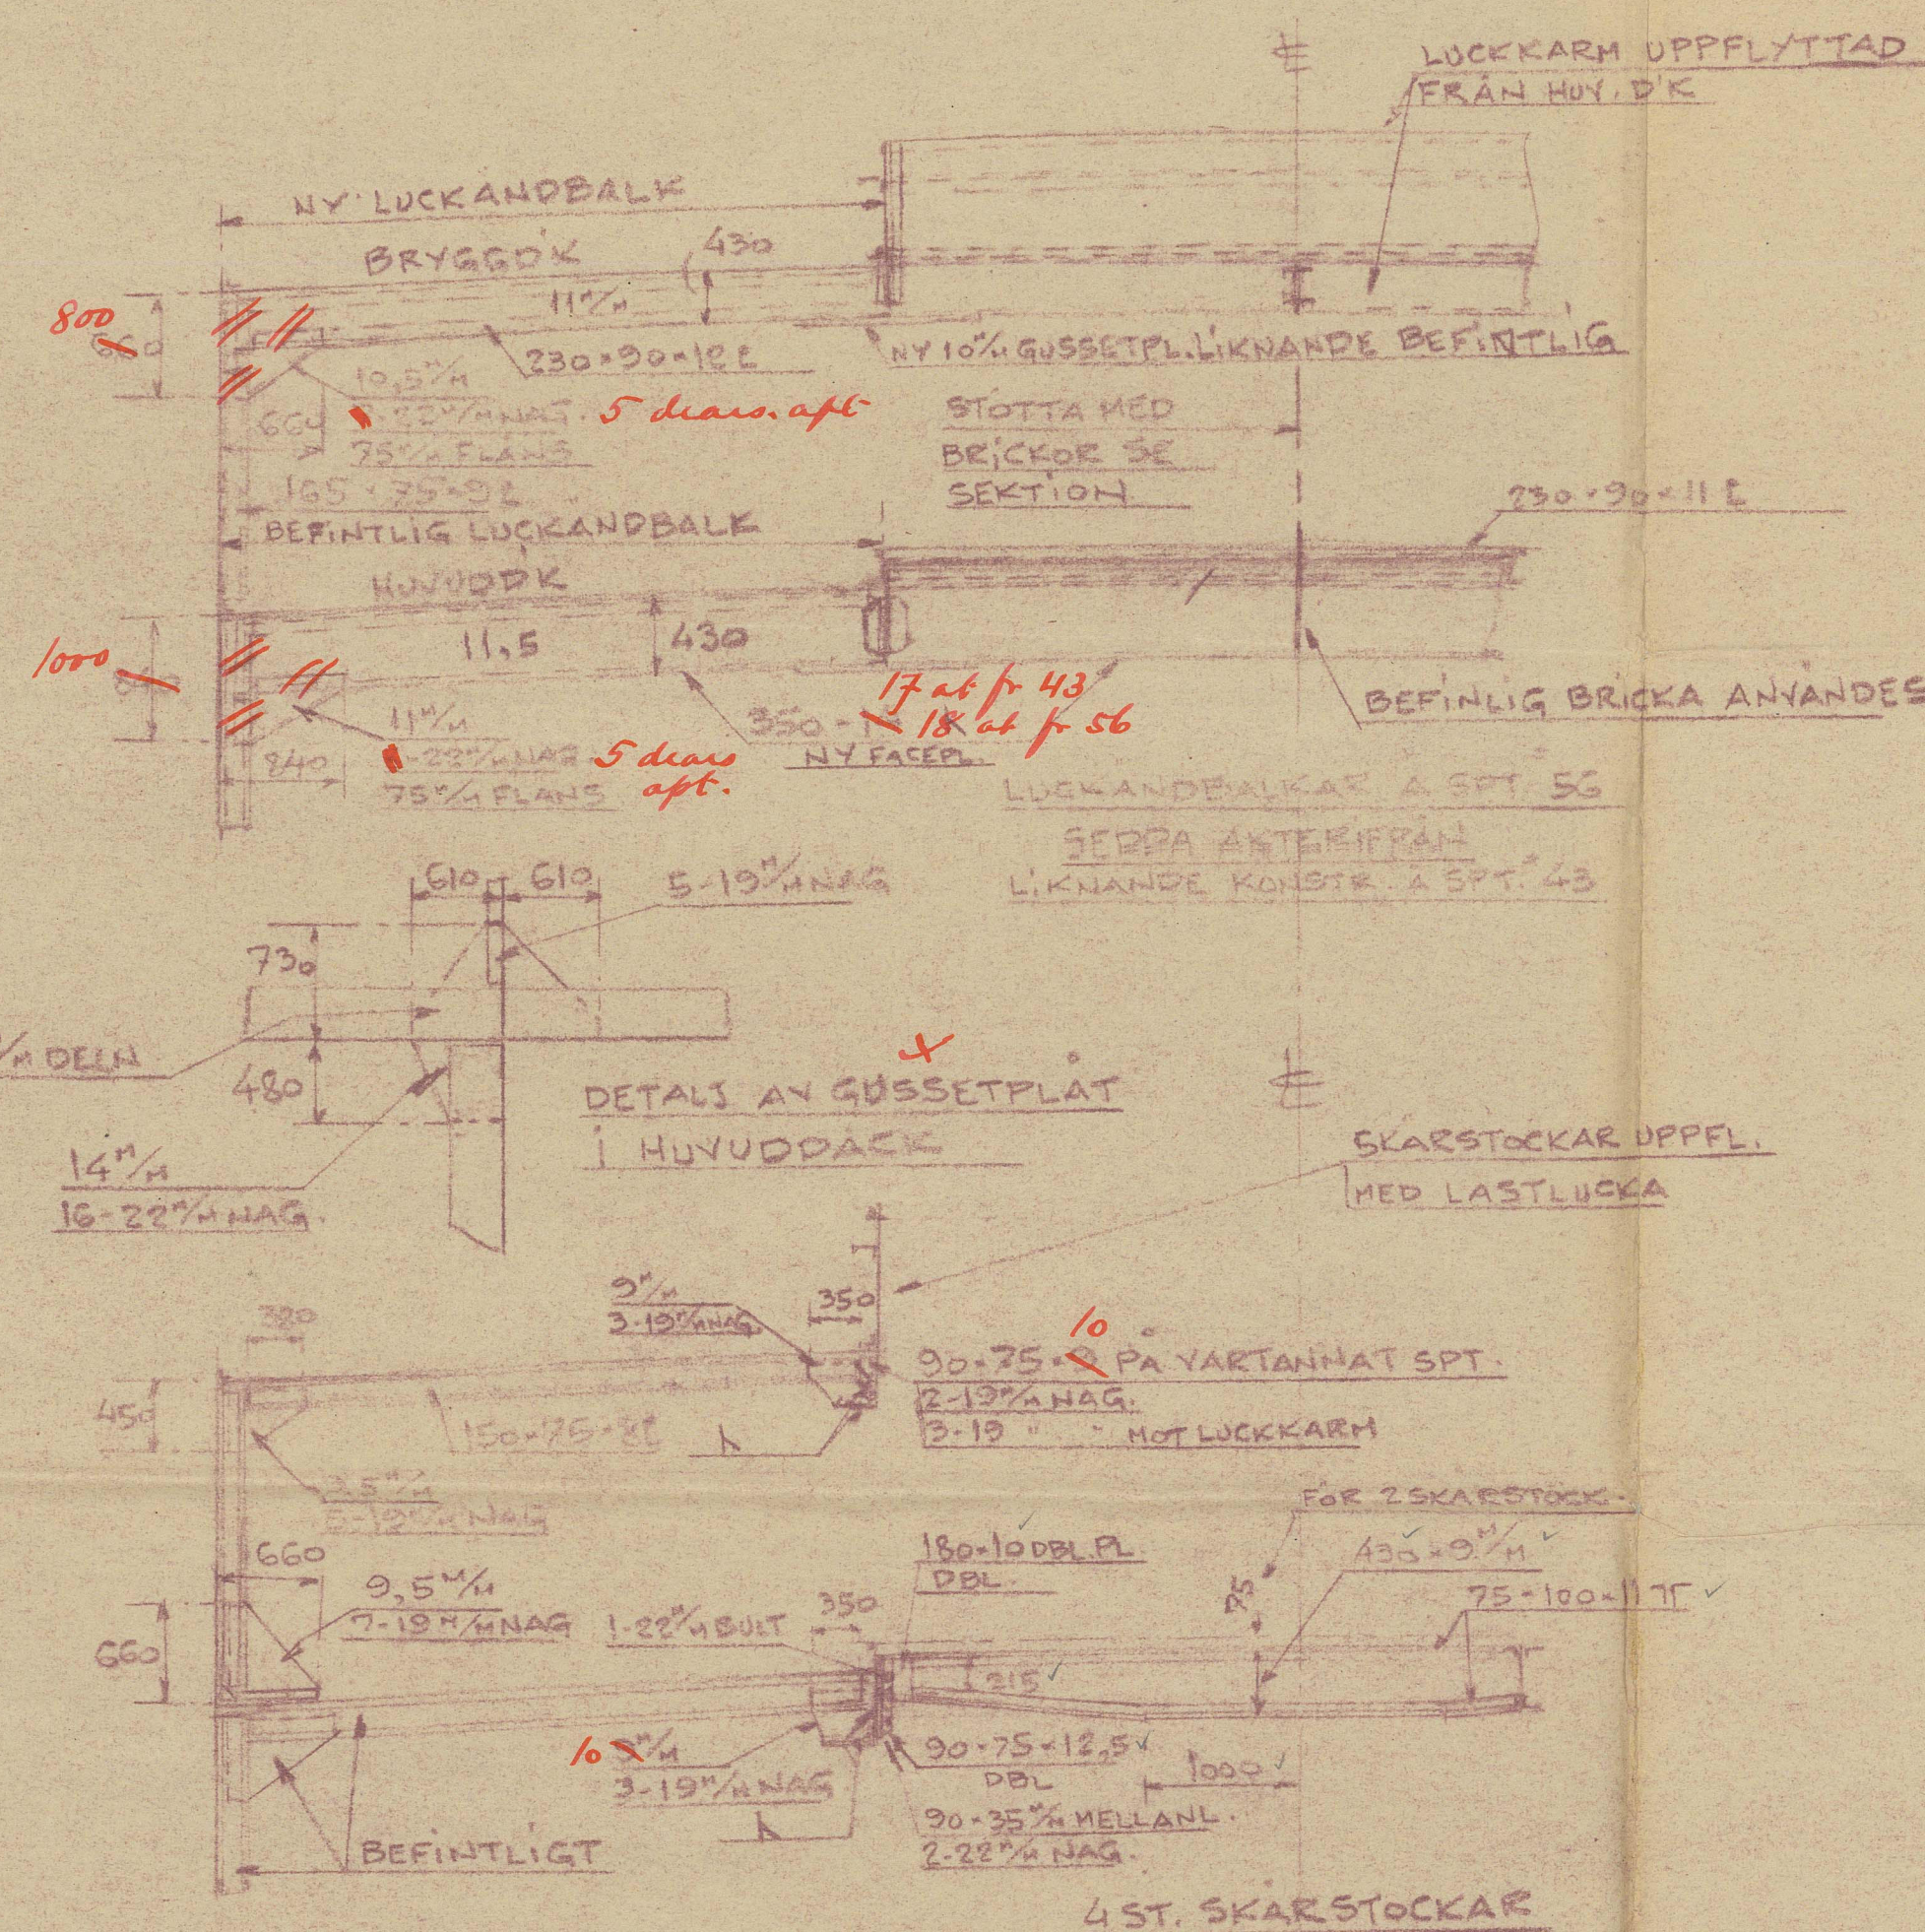

Lloyd's Register
015039 - 015053 - 02877