

$$24 \times 15.5 \times 11.5 = 37.6$$

By 2nd I a % stated at 50 ft.

$$26 \times 15.5 \times 7.5 = 288$$



$$400 \times 11 \times 12.5 = 5500$$

$$275 \times 11 \times 12.5 = 3750$$

$$71 \times 36 \times 15.5 \times 7.5 = 690$$



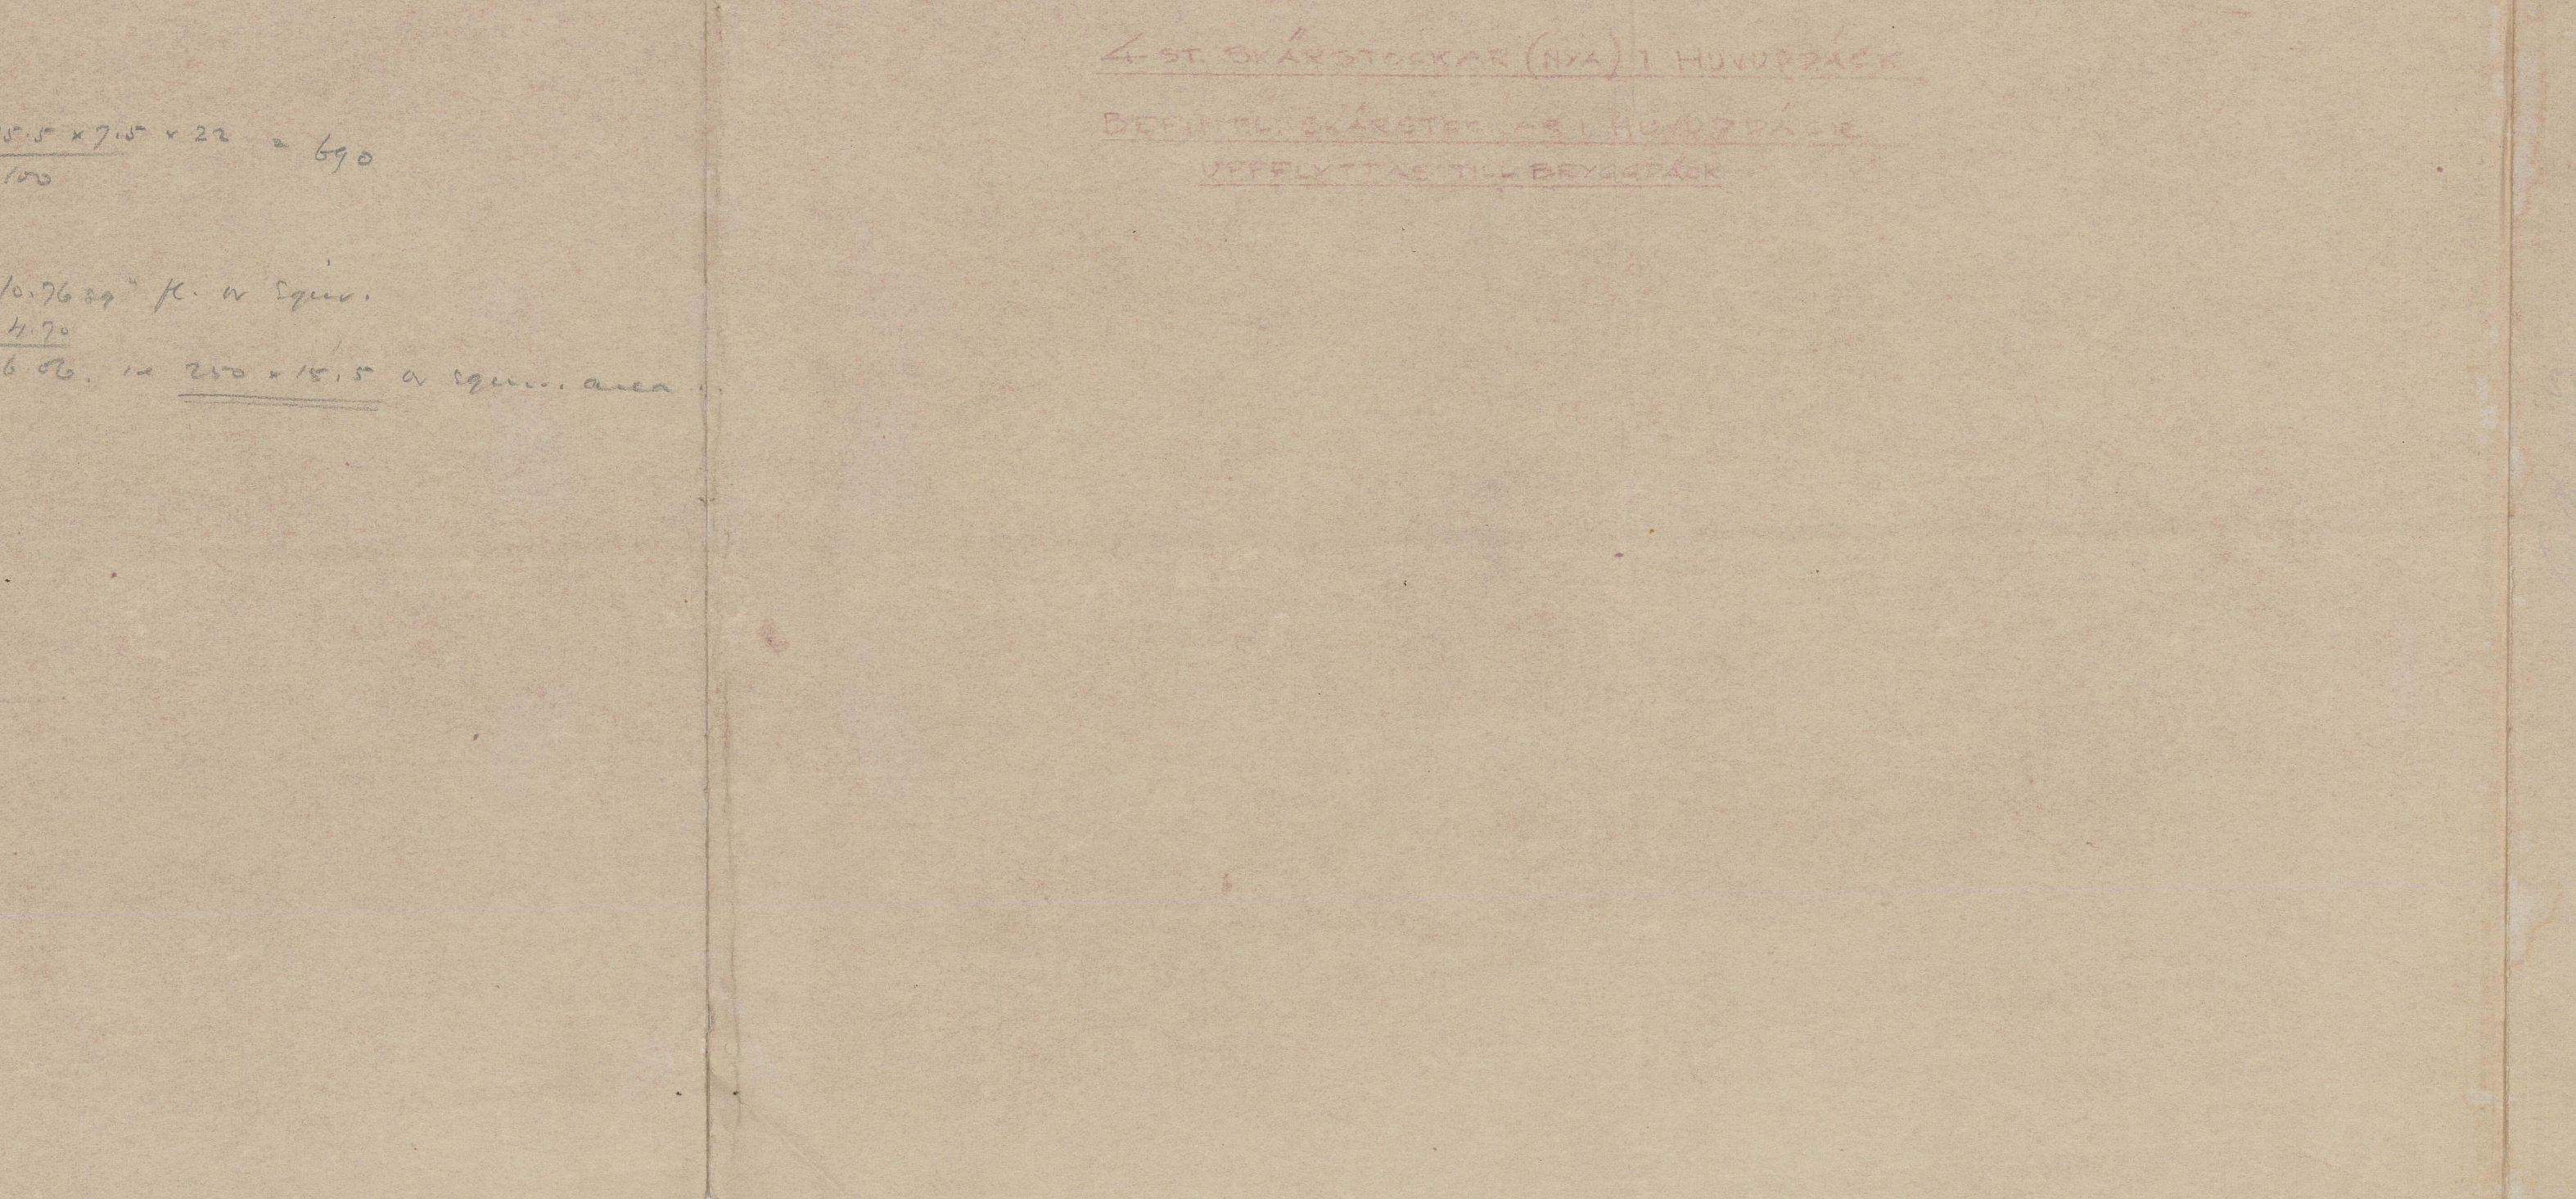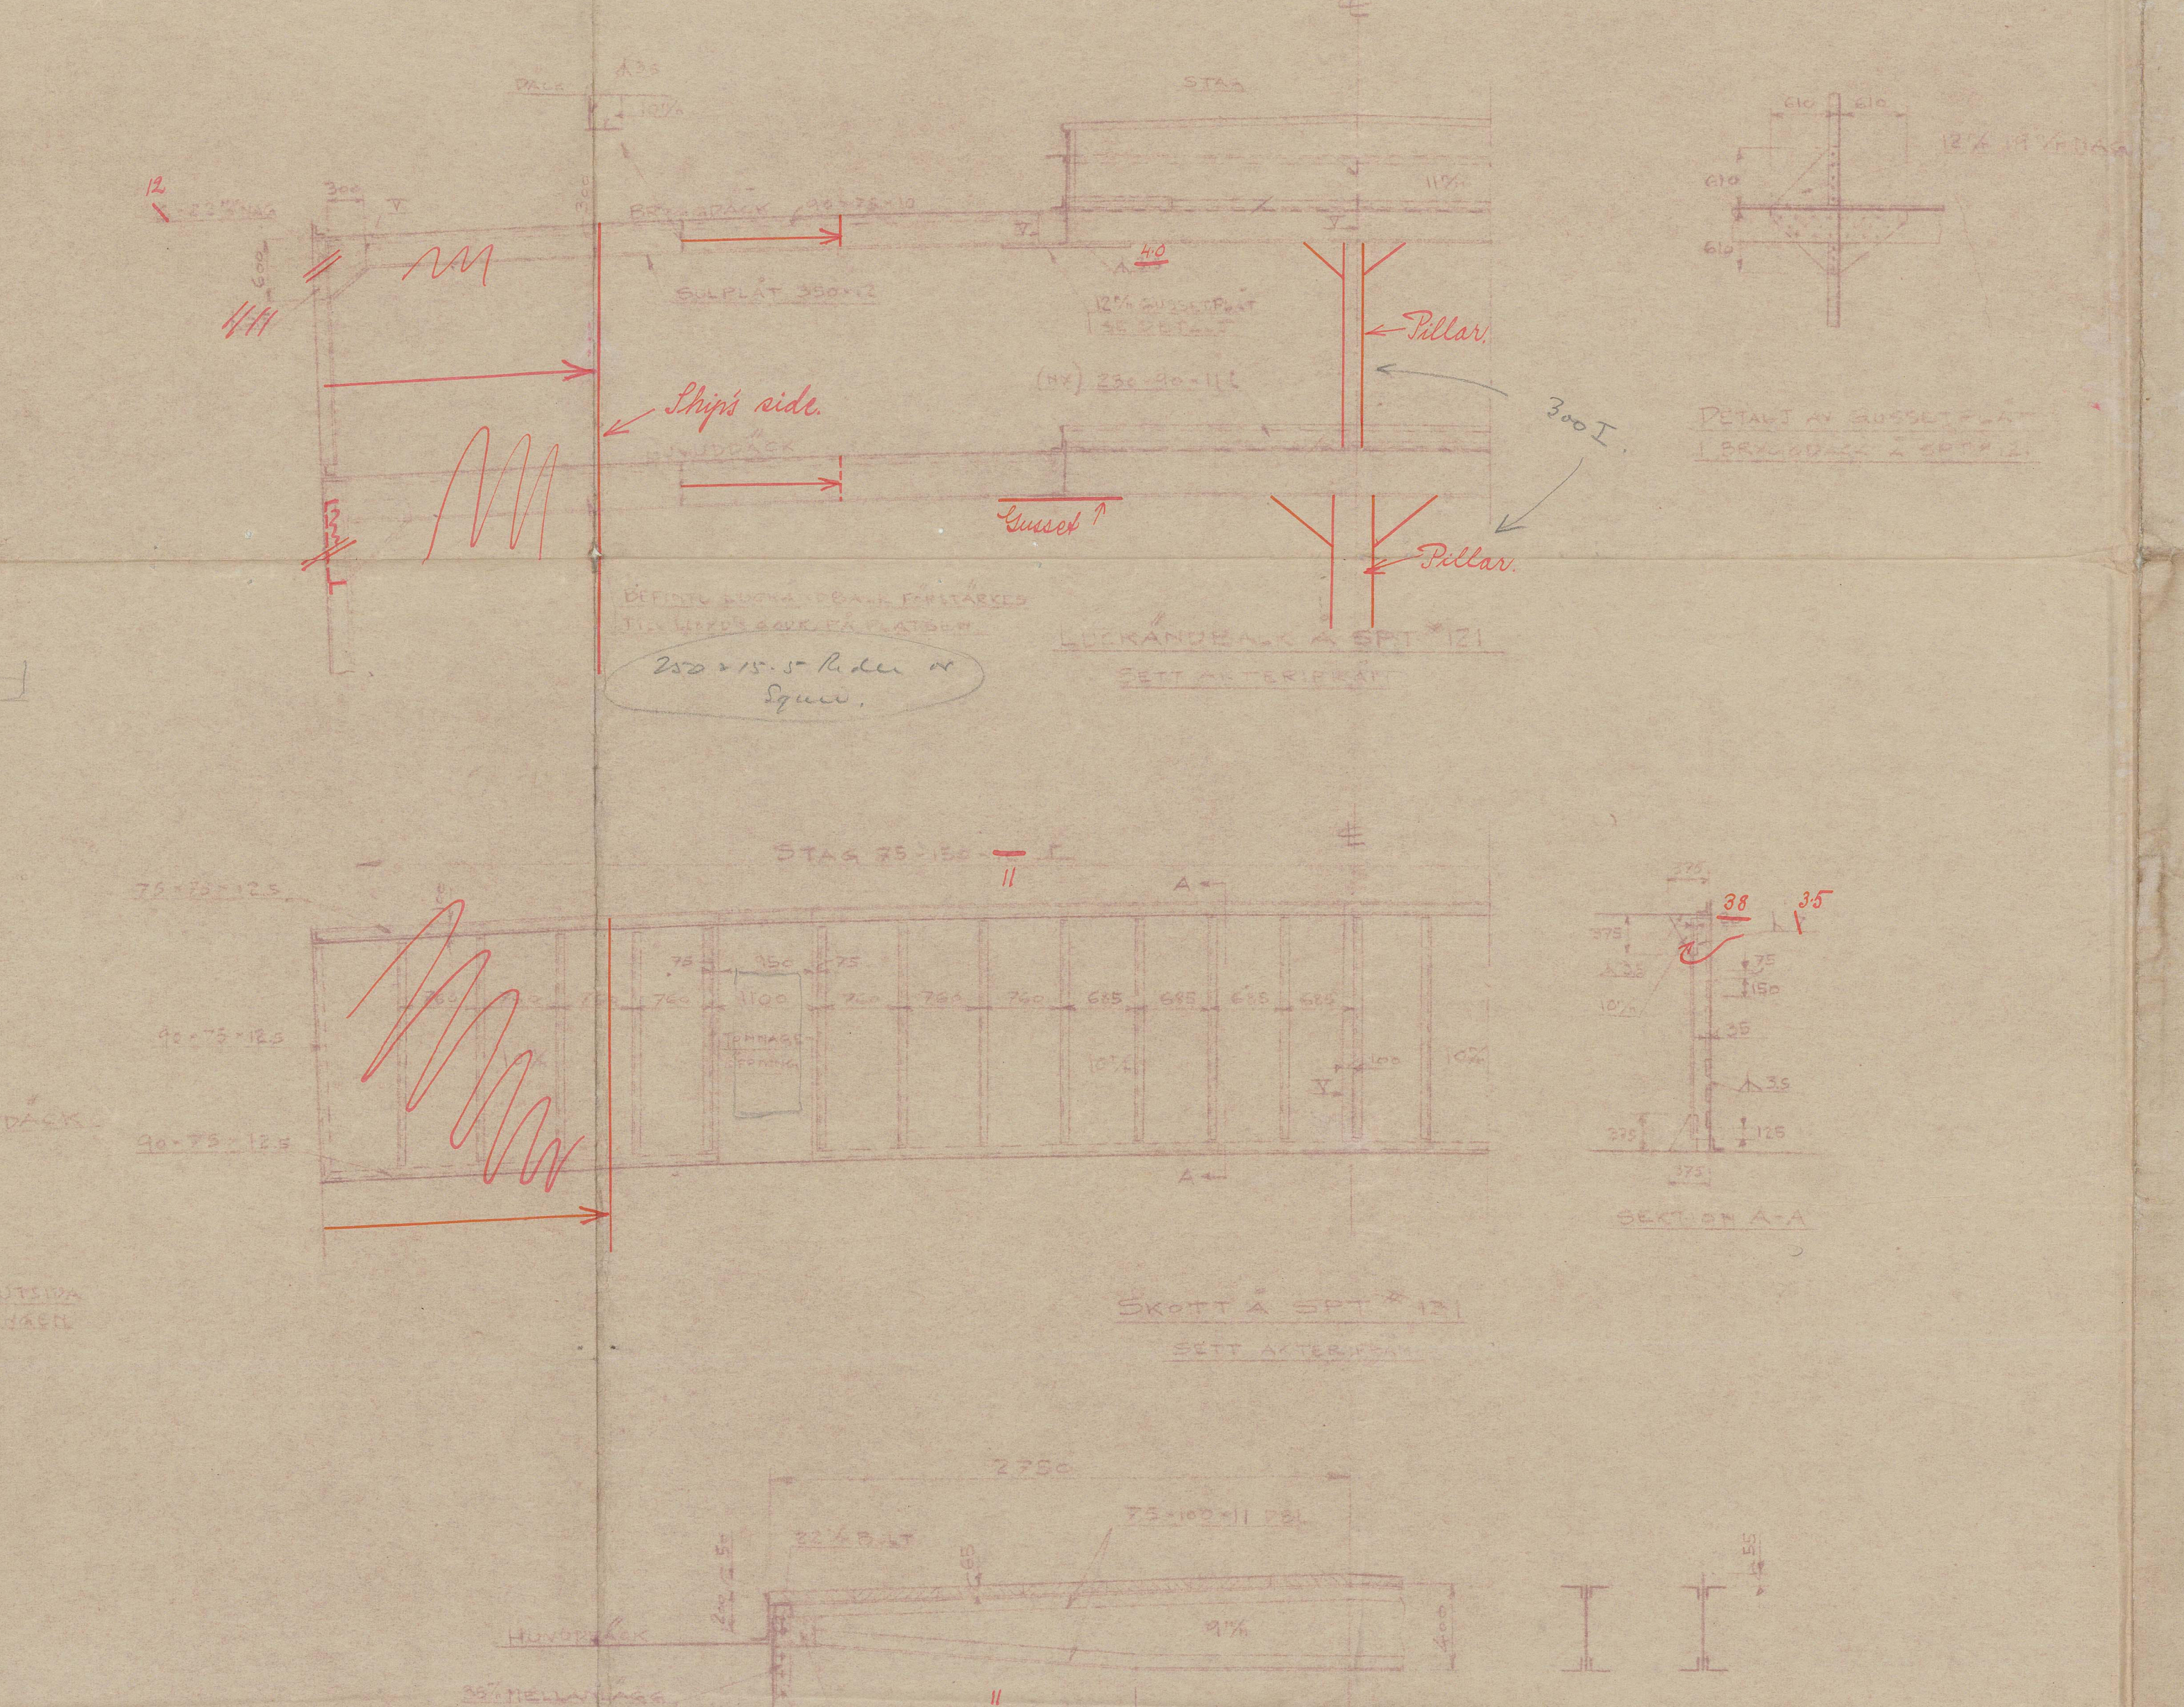

BUILDING SHEET	
NO.	DATE
436	2347
437	2


S.P. John

Got. rept. No. 13592.

Alterations (extension of
bridge)

Got. rept. No. 13592.

GOETTERBURG REPORT NO. 13592

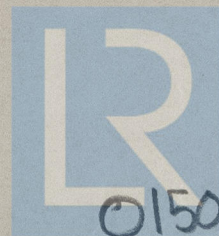

© 2021

Lloyd's Register

015039-015053-0288