

STEEL SCREW MOTOR TUG

# PROFILE & DECK PLAN

## SHIP No. 1374



DIMNS 70'-0" B.P. x 18'-0" M<sup>LD</sup> x 8'-6" M<sup>LD</sup>

TO CLASS  $\frac{1}{2}$  A.I. FOR TOWING SERVICE ON THE RIVER THAMES.

SCALE  $\frac{3}{8}$  IN. = 1 FT.



PILLARING THROUGHOUT TO SURVEYOR'S SATISFACTION  
BULKHEADS STIFFENED TO SURVEYOR'S SATISFACTION

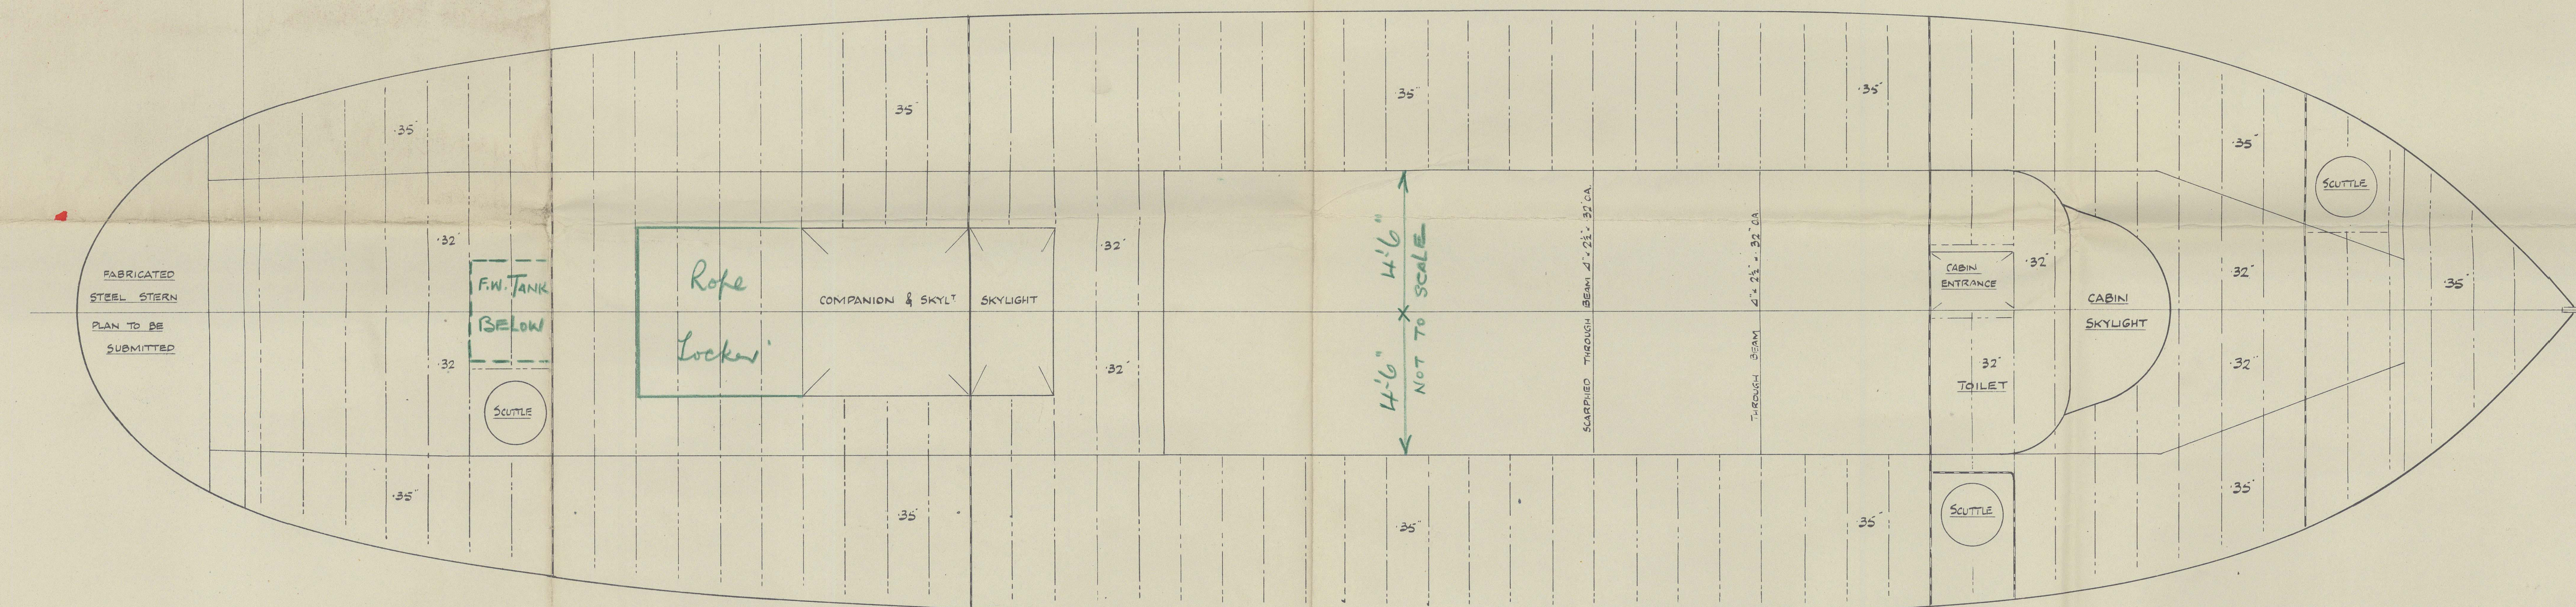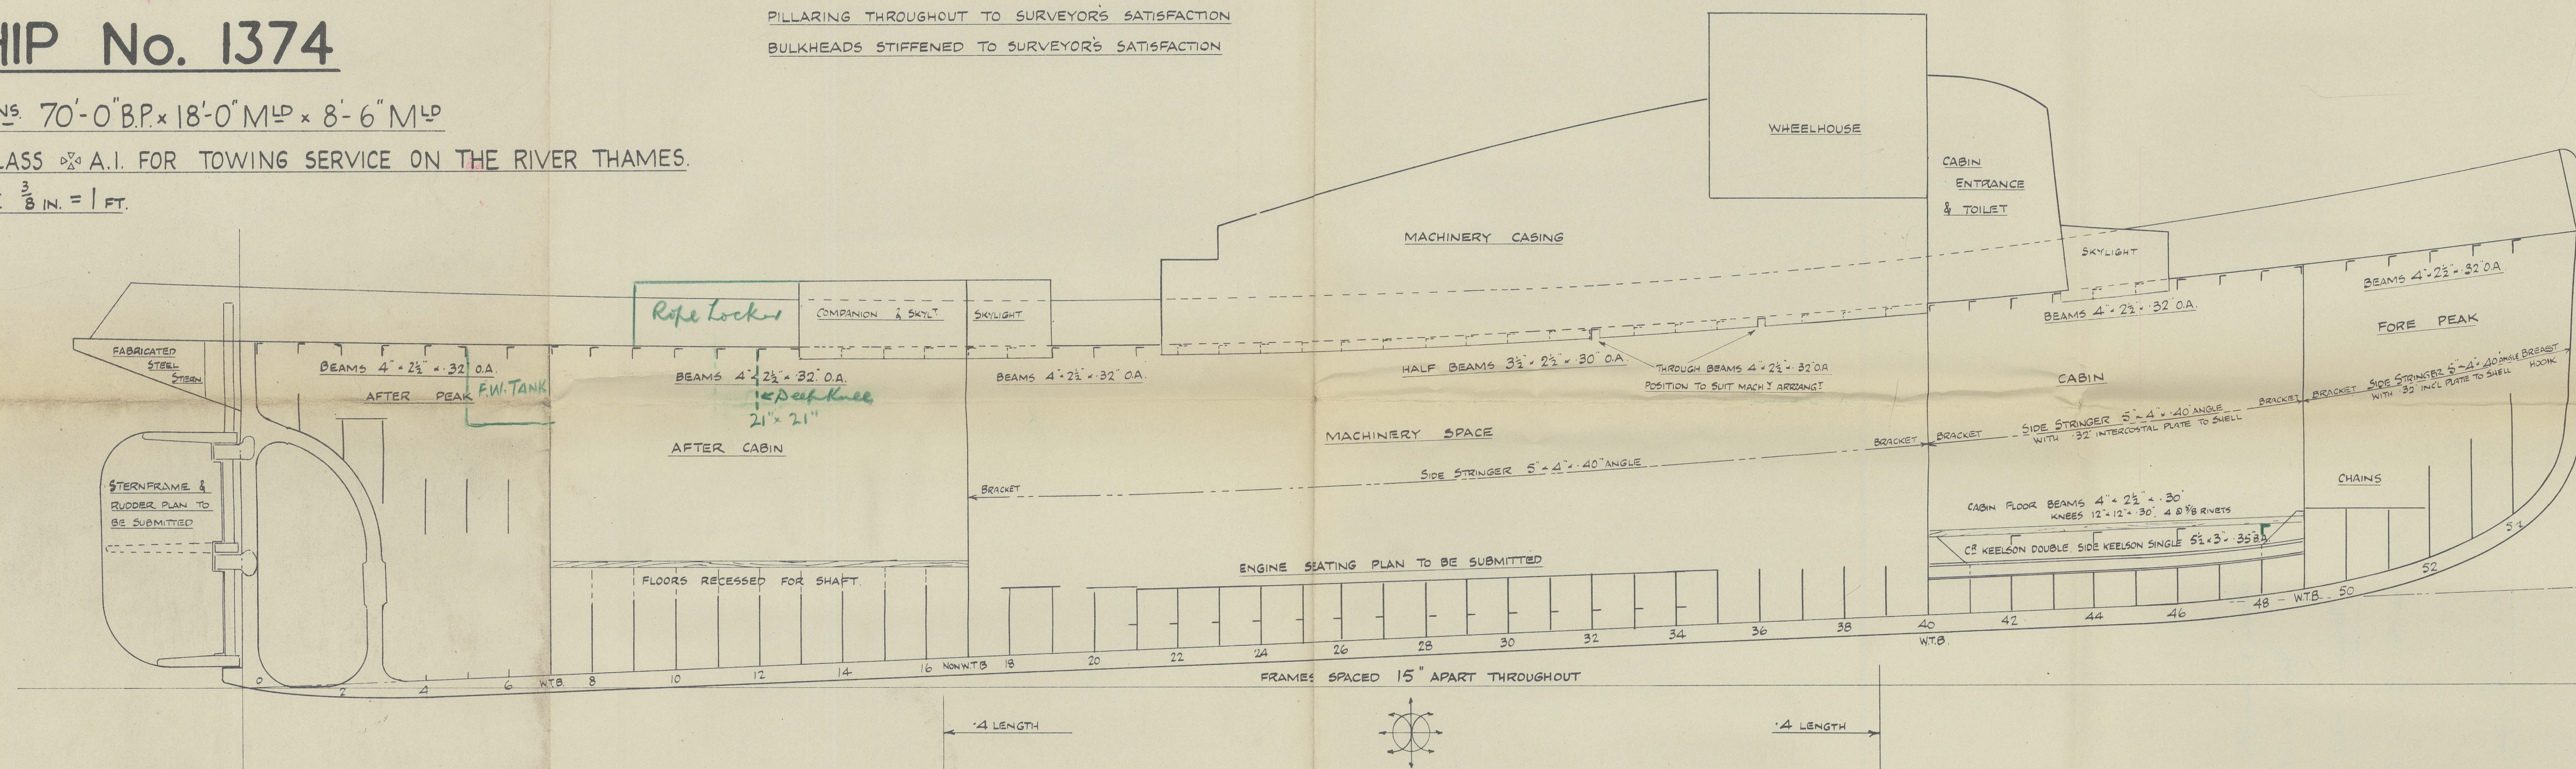

GUNWALE BAR FITTED ON UNDERSIDE OF DECK, FRAMES  
AND BEAMS CUT SHORT - SEE STRUCTURAL SECTIONS

Ad  
27.3.51




Cochrane & Sons, Ltd.,  
Yard No. 1374.

"Margaret Locket" ★


Hull Int. Rpt. No. 58189.

PROFILE & DECK.

RECORDS DEPT.  
LONDON

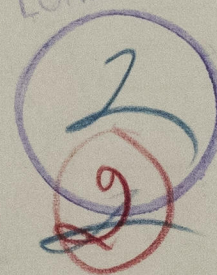

05134-015154-0297

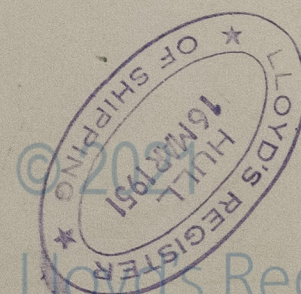

Lloyd's Register  
Foundation