











# DRAWING N°3 PROFILE & DECKS.

## SHIP N° 766


DIMENSIONS 133'-6" B.P. 25'-6" B.MLD. 13'-6" MLD

CLASS 100 A.I. DIESEL TRAWLER

SCALE 1/4" TO 1 FT.

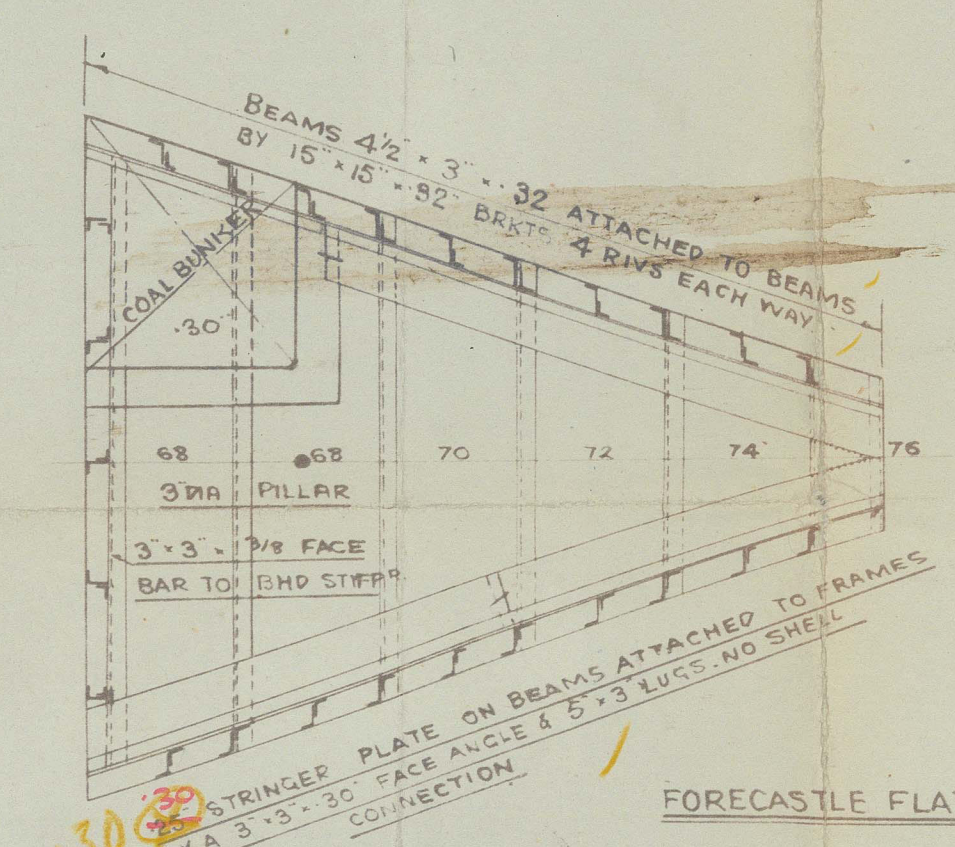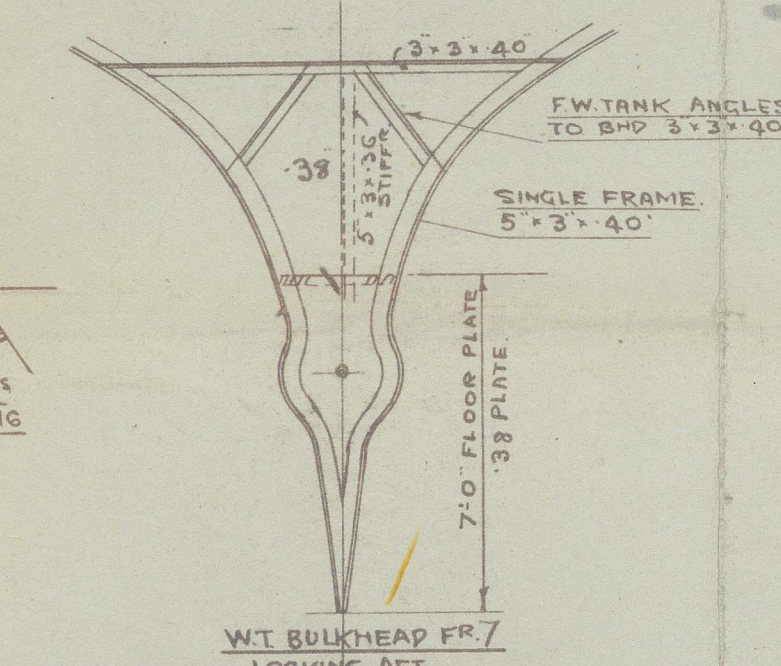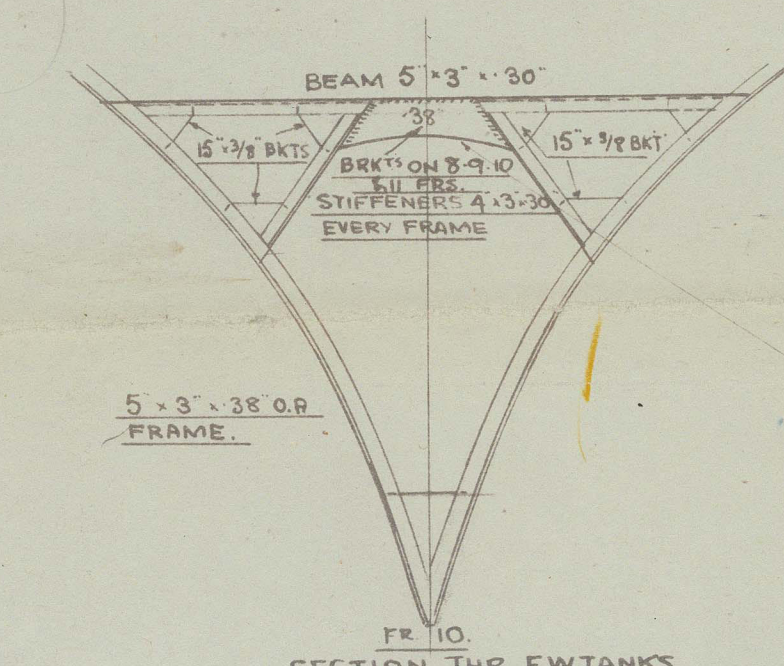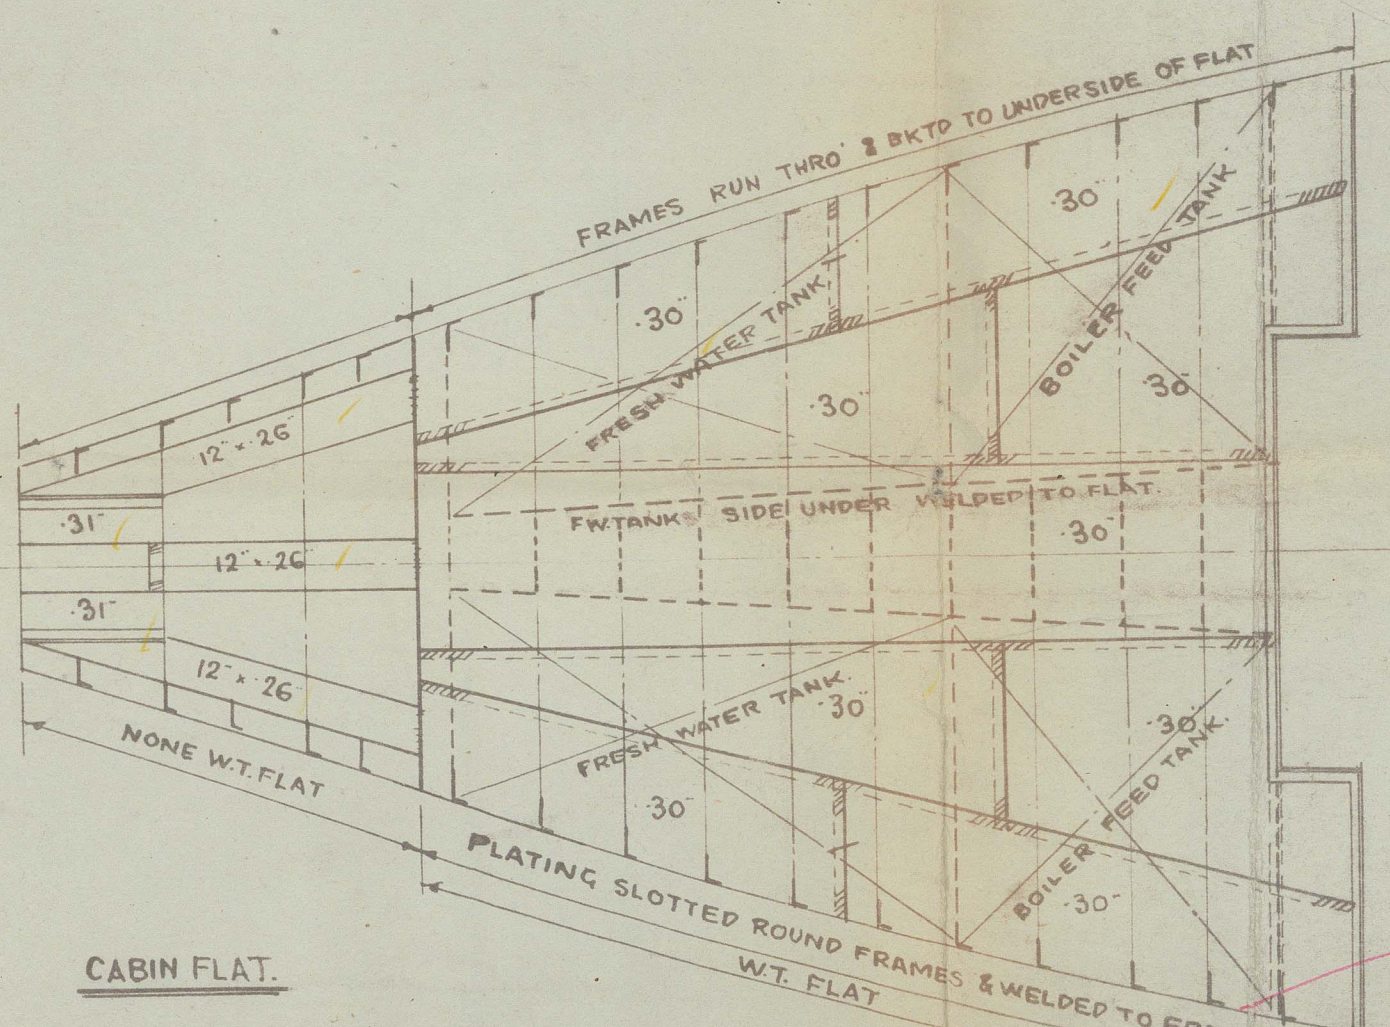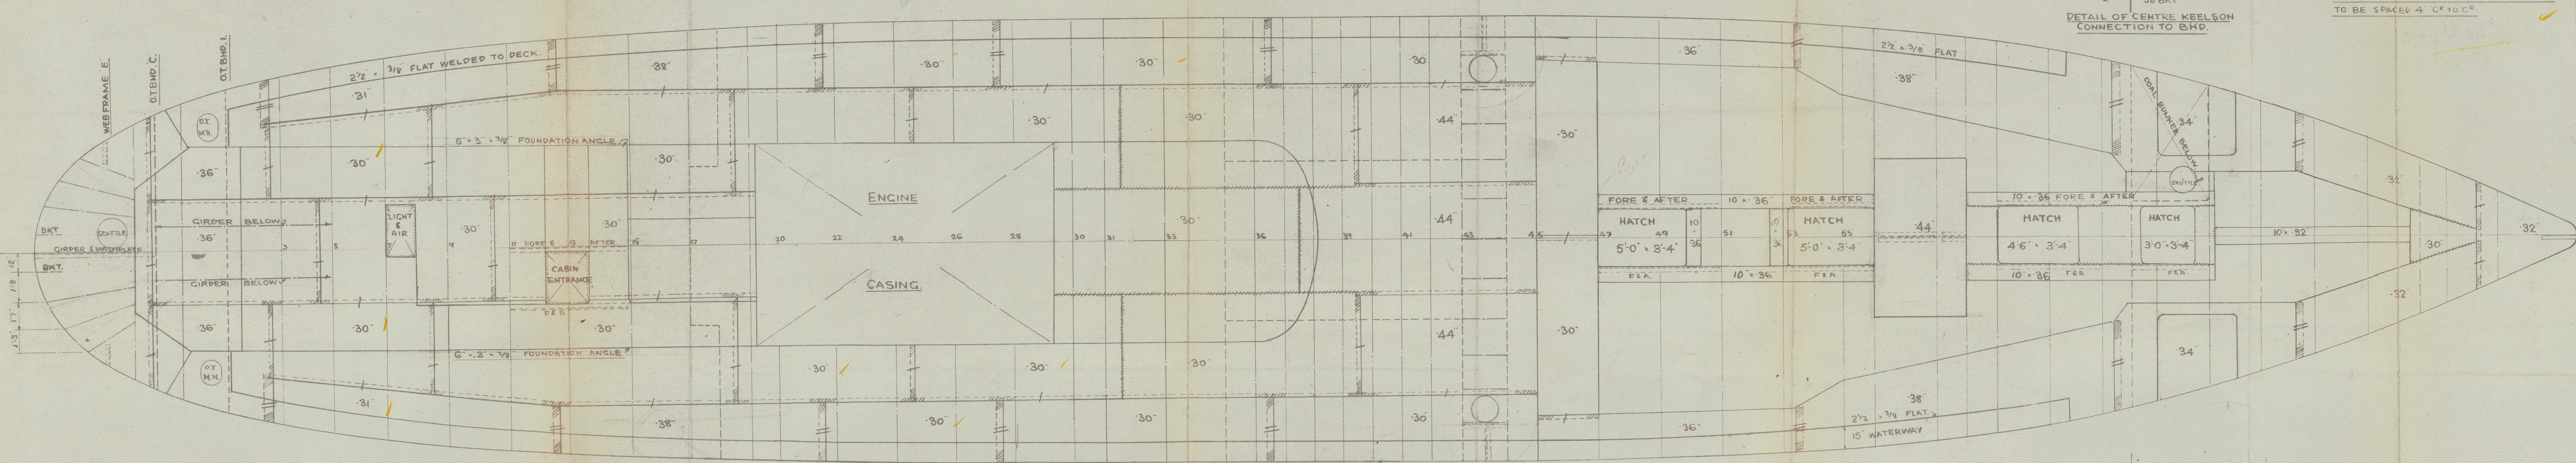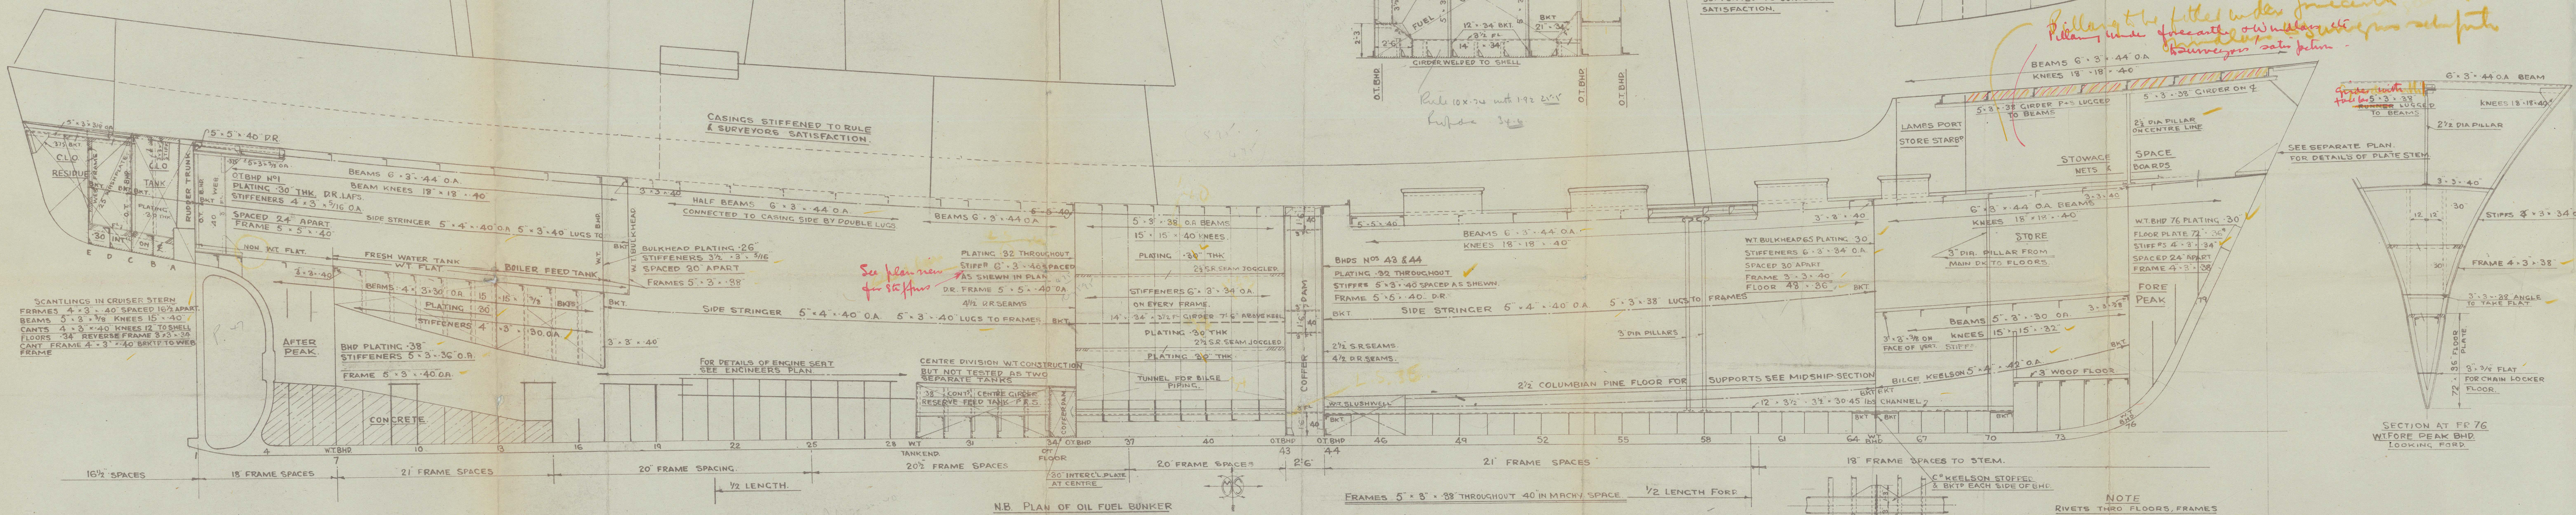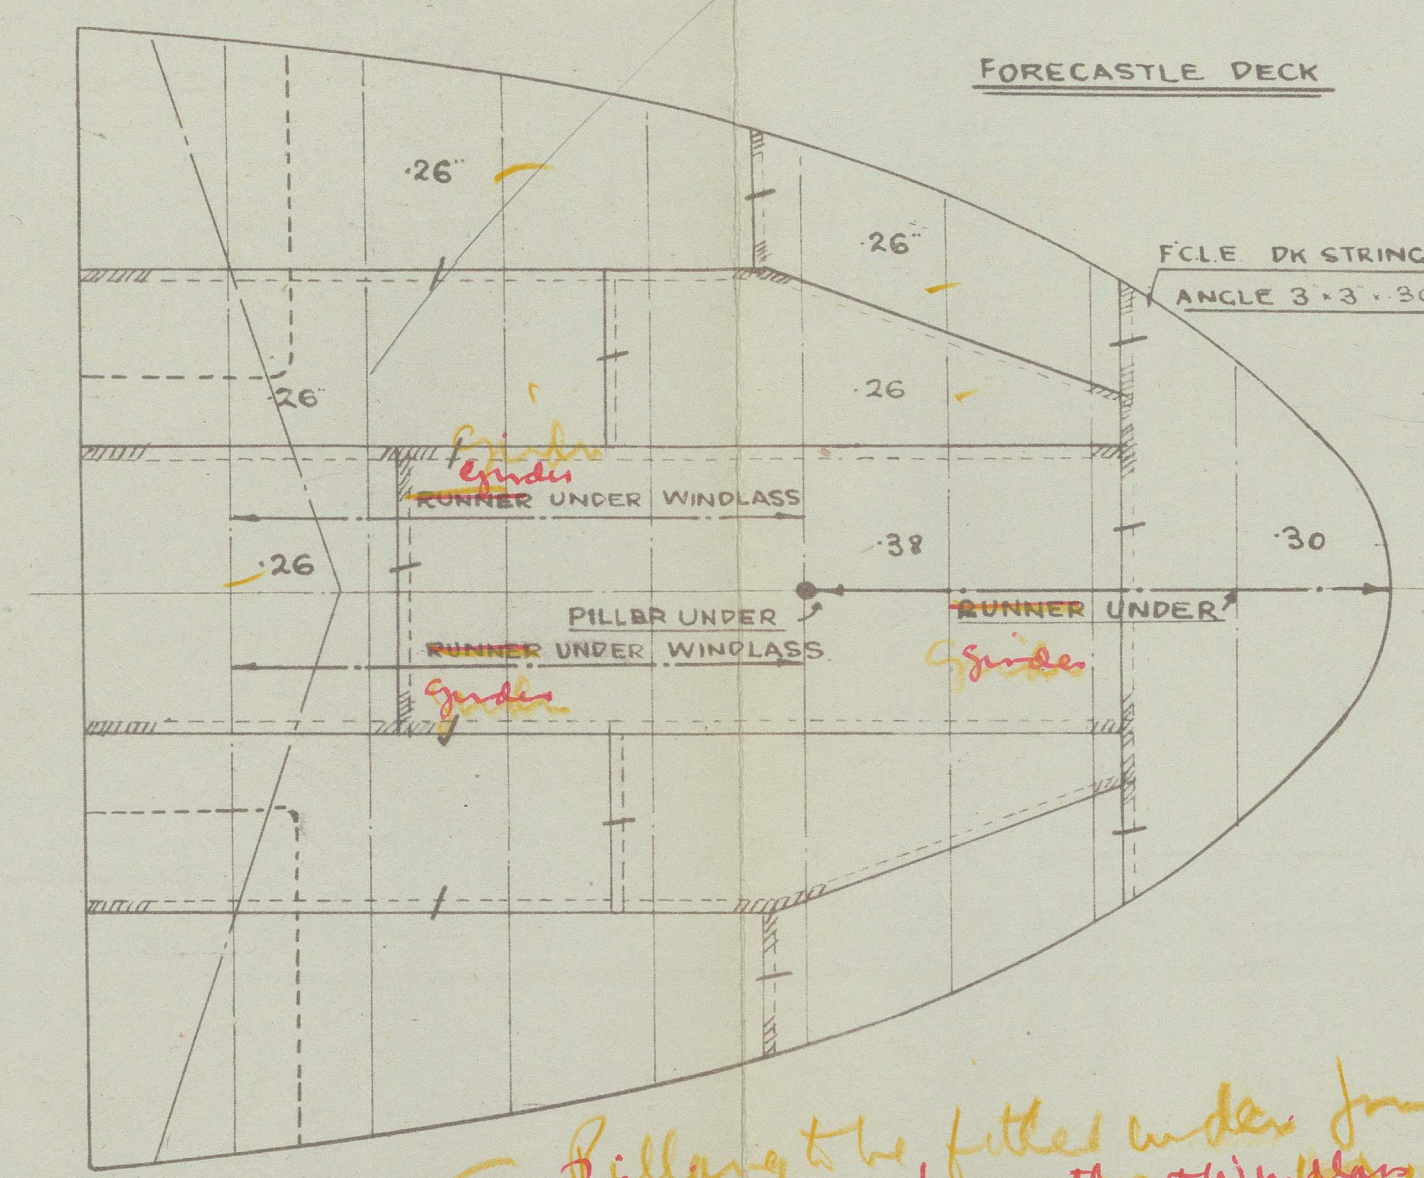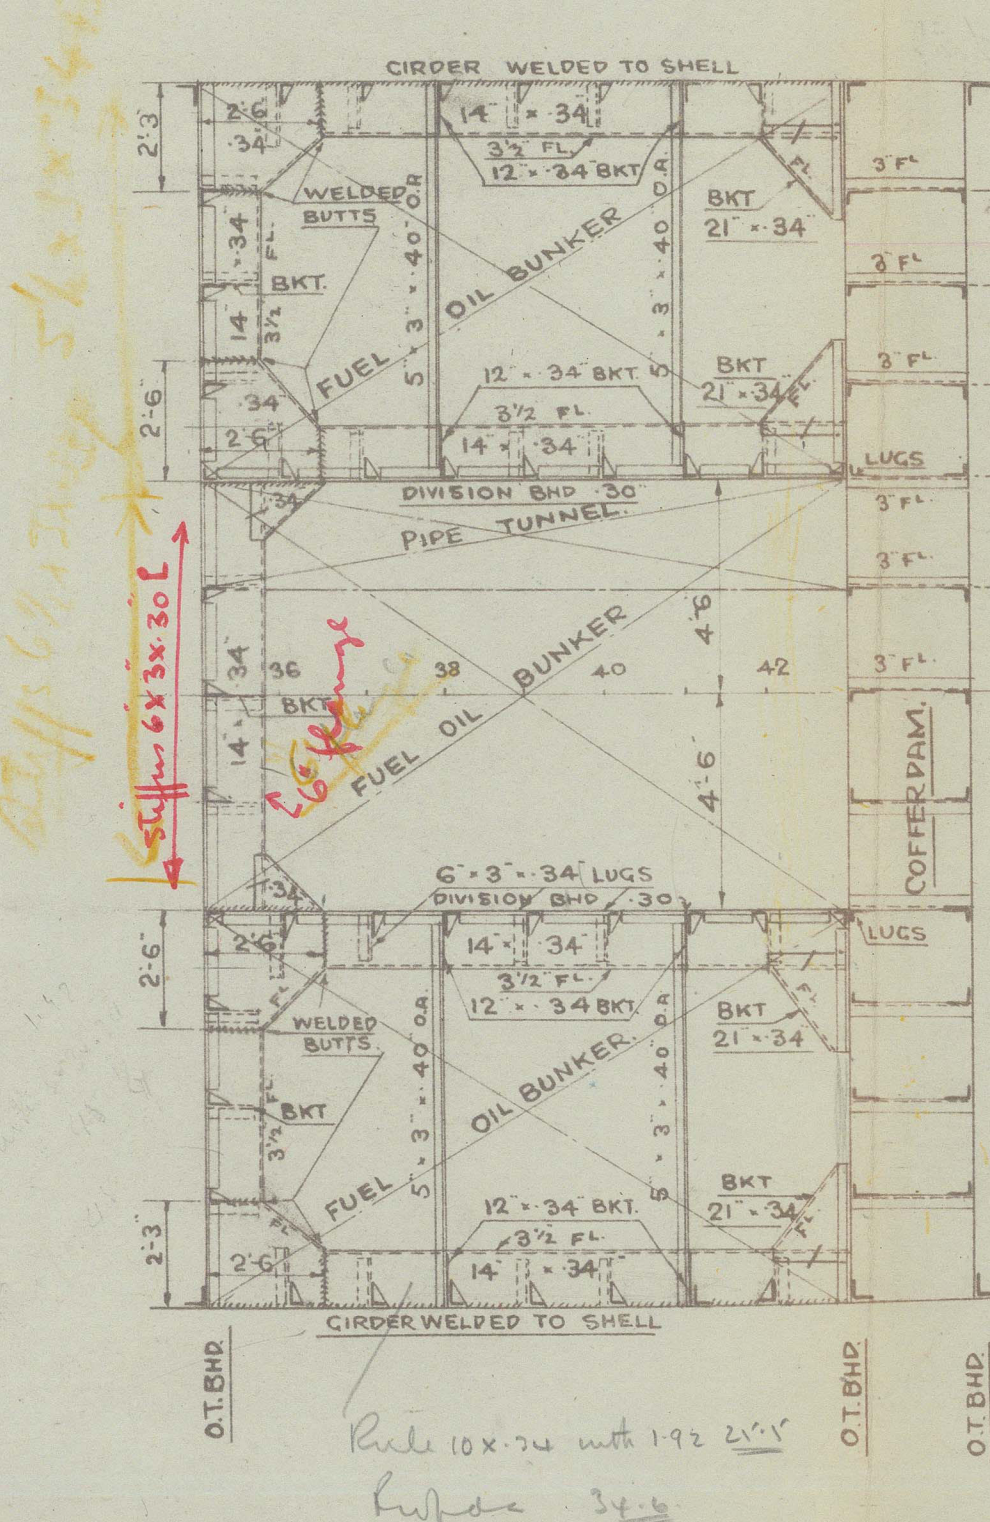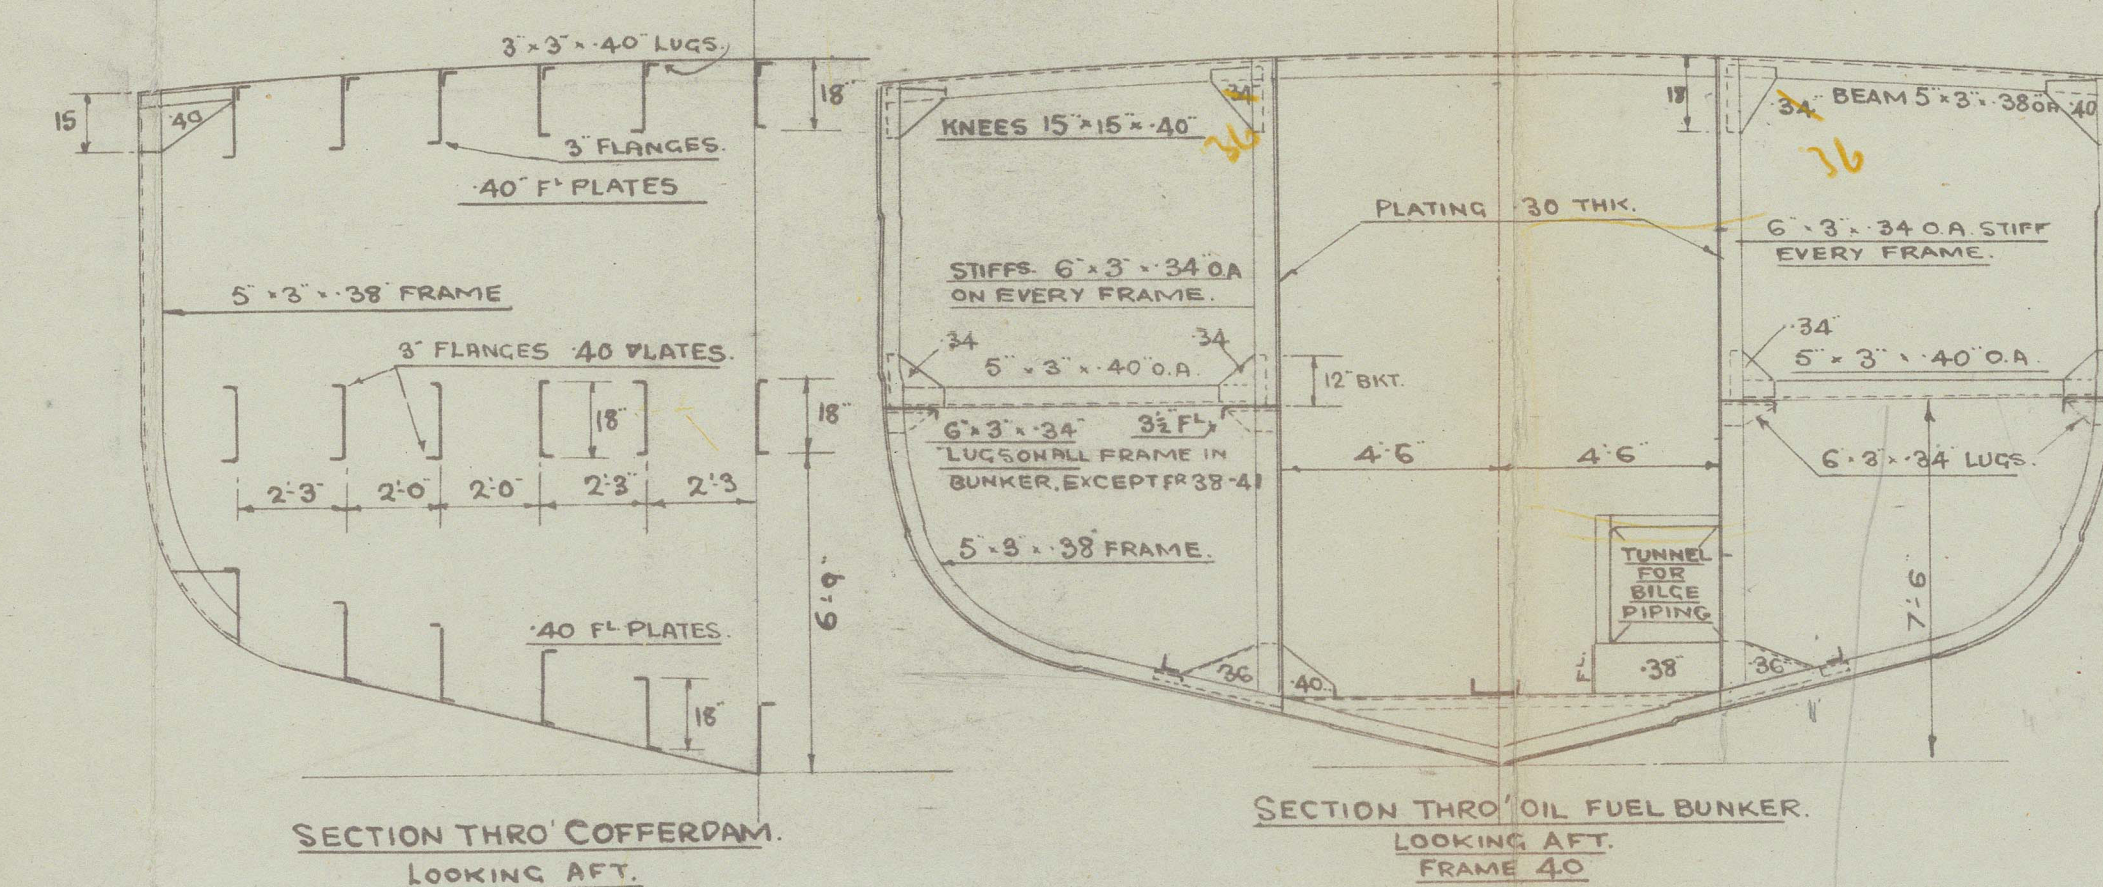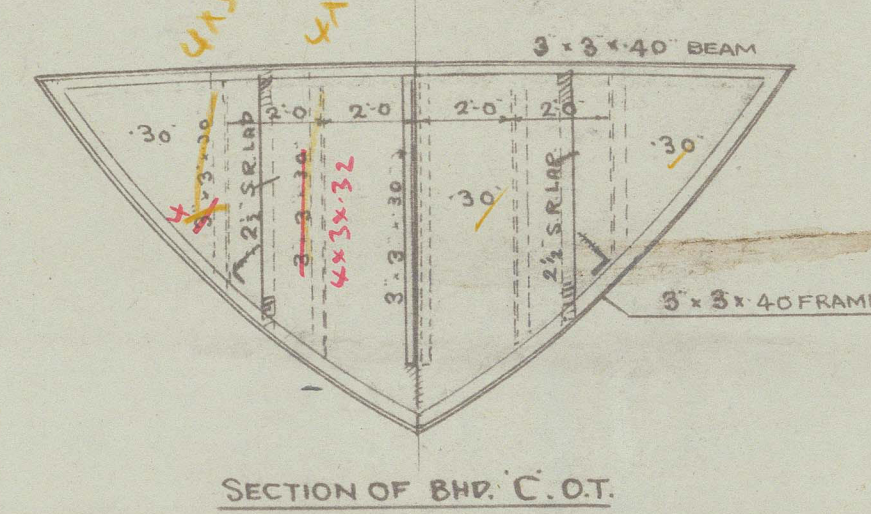



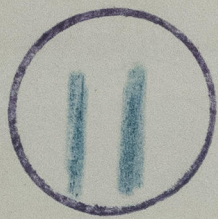

COOK, WELTON & GEMMELL  
YARD NO 766


PROFILE & DECKS

"THORINA" \*

015134-015154-0178

used. Has been  
to unweathered

FORECASTLE DECK

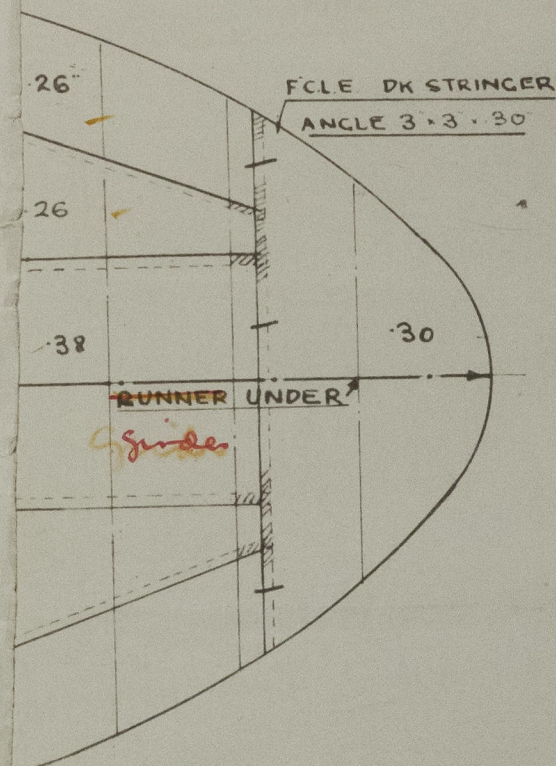


86.5 x 172

117


40

0178

The fitted under forecastle  
is forecastle own millage  
Barrington's satisfaction

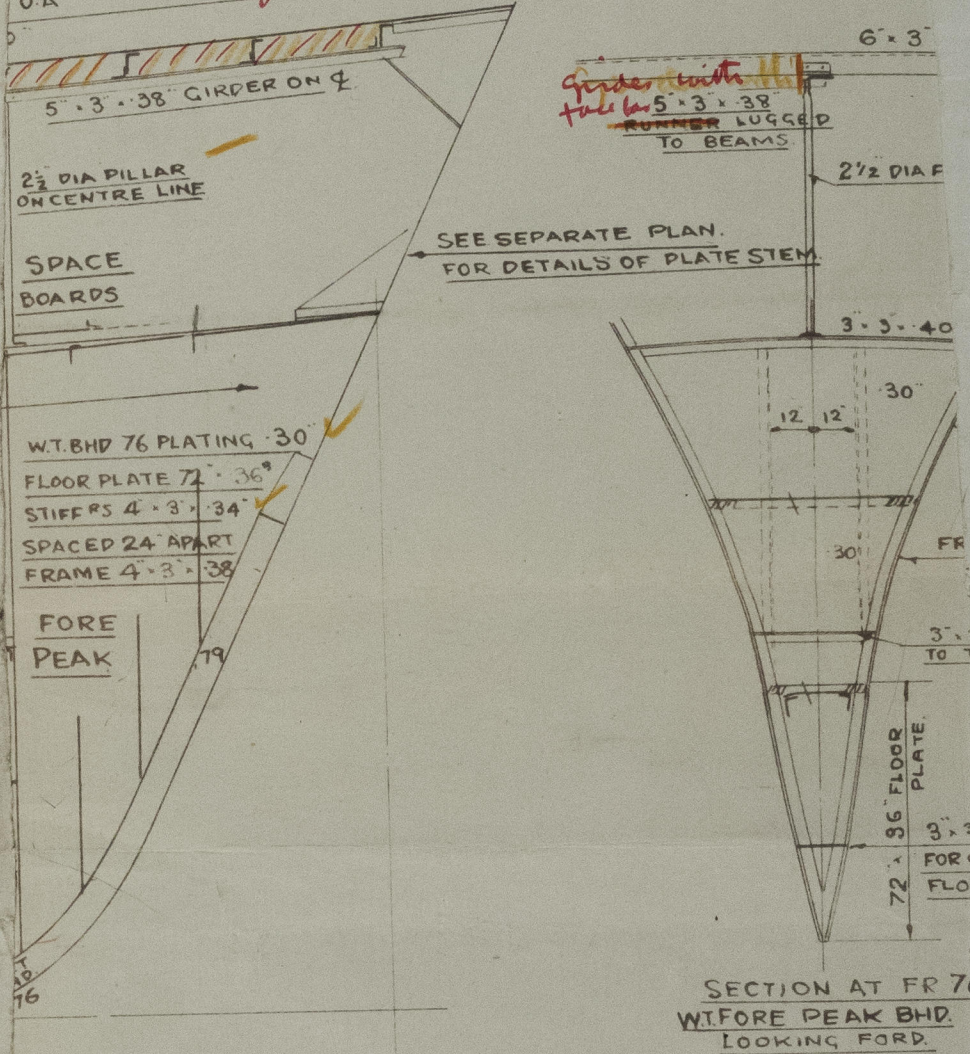

TE  
FLOORS, FRAMES  
Y OF CARBOARD & TWO  
AKES FORD OF 1/2 LENGTH  
4 CFTOCE

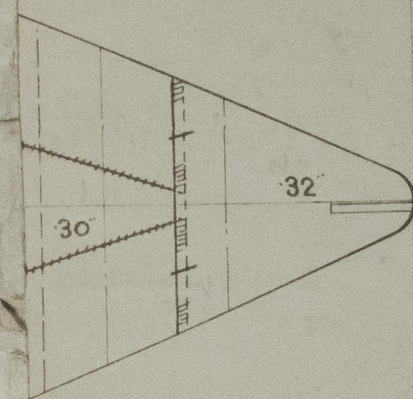

76  
AMES

E FLAT

30.10.45



© 2021  
Lloyd's Register  
Foundation



Offici

0178



© 2021

Lloyd's Register  
Foundation