



24 OCT 1922

- S.S. No 149 -  
FORGINGS.  
- SCALE = 1" TO 1 FOOT.

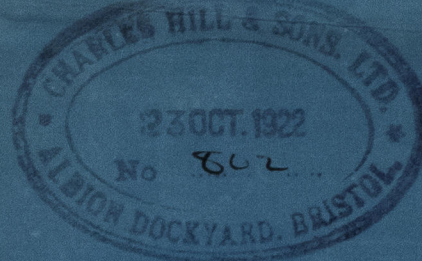

Approved *[Signature]*  
See L.H. 24 10 22

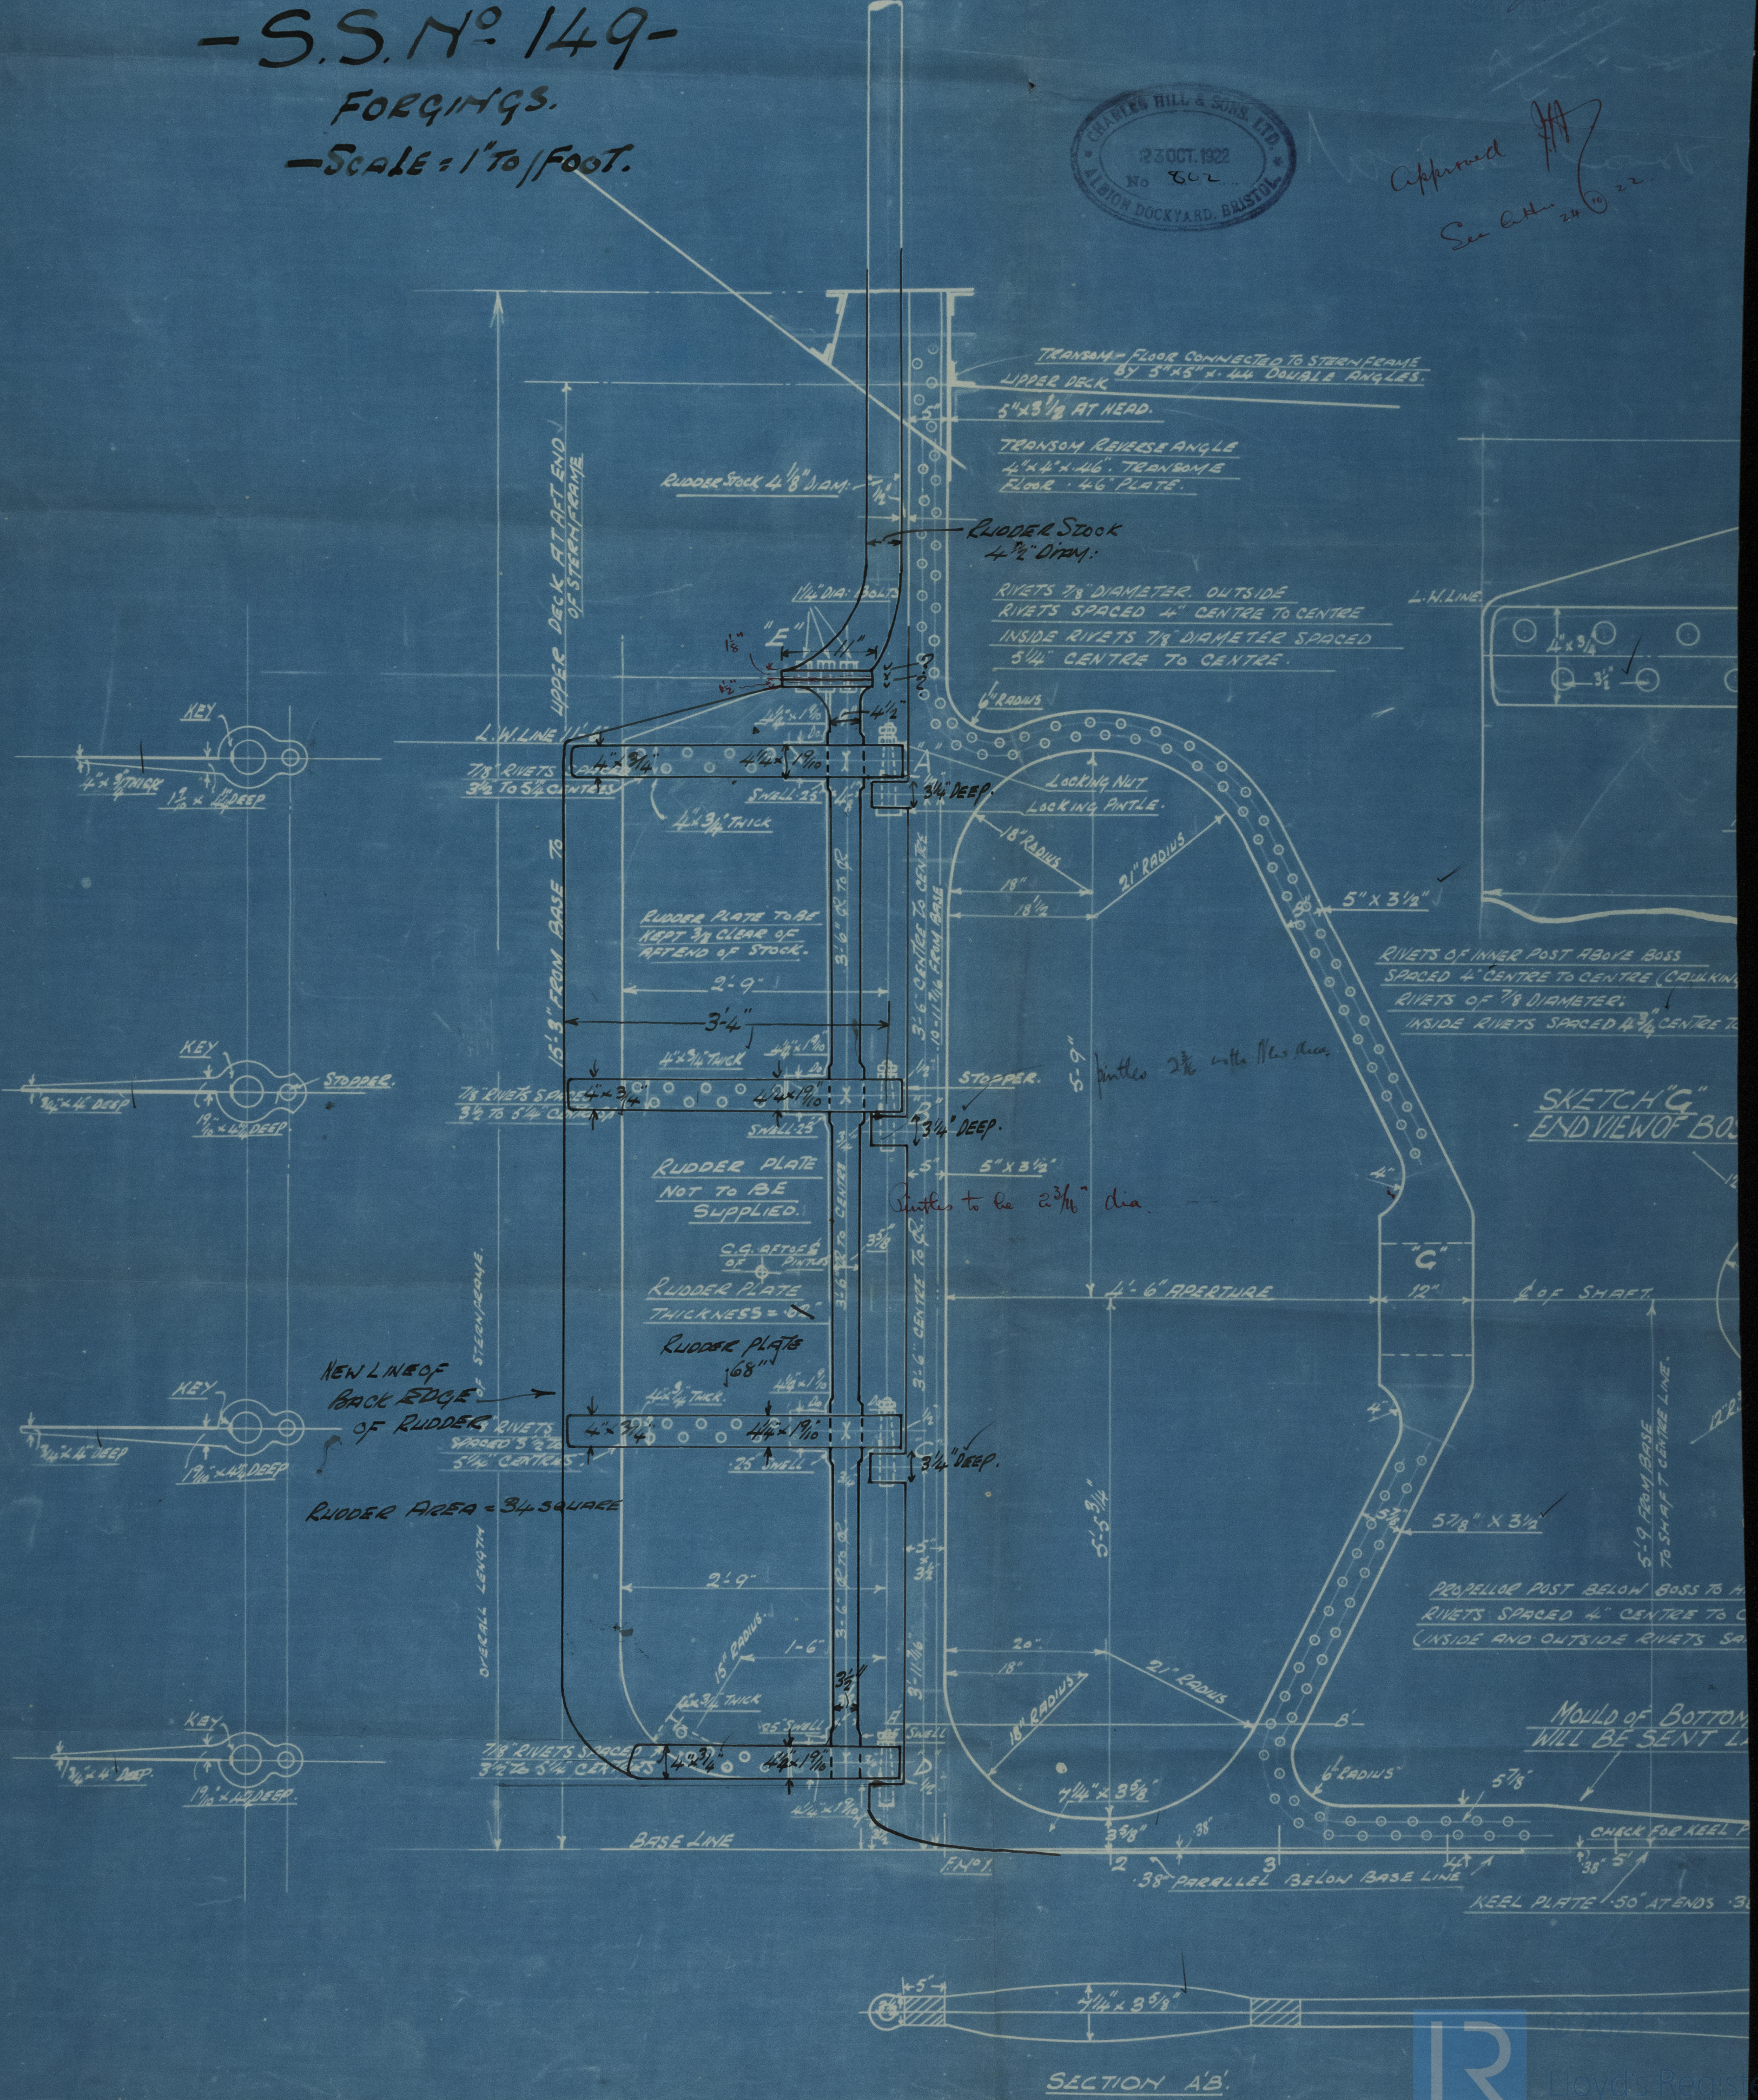



C Hill & Sons  
149  
Amended Rudder

Bag

C. Hill & Sons  
N<sup>o</sup> 149  
Amended Rudder

Sh. 10. m

SS BEN READ

6

015155-015162-0006



© 2021

Lloyd's Register  
Foundation