

|         |     |                                     |
|---------|-----|-------------------------------------|
| LENGTH  | BP  | 325'-0"                             |
| BREADTH | MLD | 47'-8 <sup>3</sup> / <sub>4</sub> " |
| BREADTH | EXT | 48'-0"                              |
| DEPTH   | MLD | 24'-3"                              |


CLASS 100 A.I. LLOYDS (1921-22 RULES)

STEEL

SCALE  $\frac{1}{2}$ " = 1 FT



|                                                      |                |
|------------------------------------------------------|----------------|
| B + D                                                | 71.98          |
| L x (B + D)                                          | 23593          |
| L/D TO MAIN DX.                                      | 13.41          |
| L/D TO BRIDGE DECK                                   | 10.11          |
| d                                                    | 21.0'          |
| LONGITUDINAL NO                                      | 23593          |
| POOP $35' \times 74' \frac{3}{4}$                    | <del>180</del> |
| BRIDGE $100' \times 79.2' \times \frac{3}{4}$        | 594            |
| FORECASTLE $30.7' \times 79.2' \times \frac{3}{4}$   | <del>172</del> |
| MIDSHIP HOUSE $20.4' \times 83' \frac{1}{2}$         | 82             |
| ENGINE HOUSE & CANNIS $58.1' \times 74' \frac{1}{2}$ | 192            |
| EQUIPMENT NO                                         | 34613          |

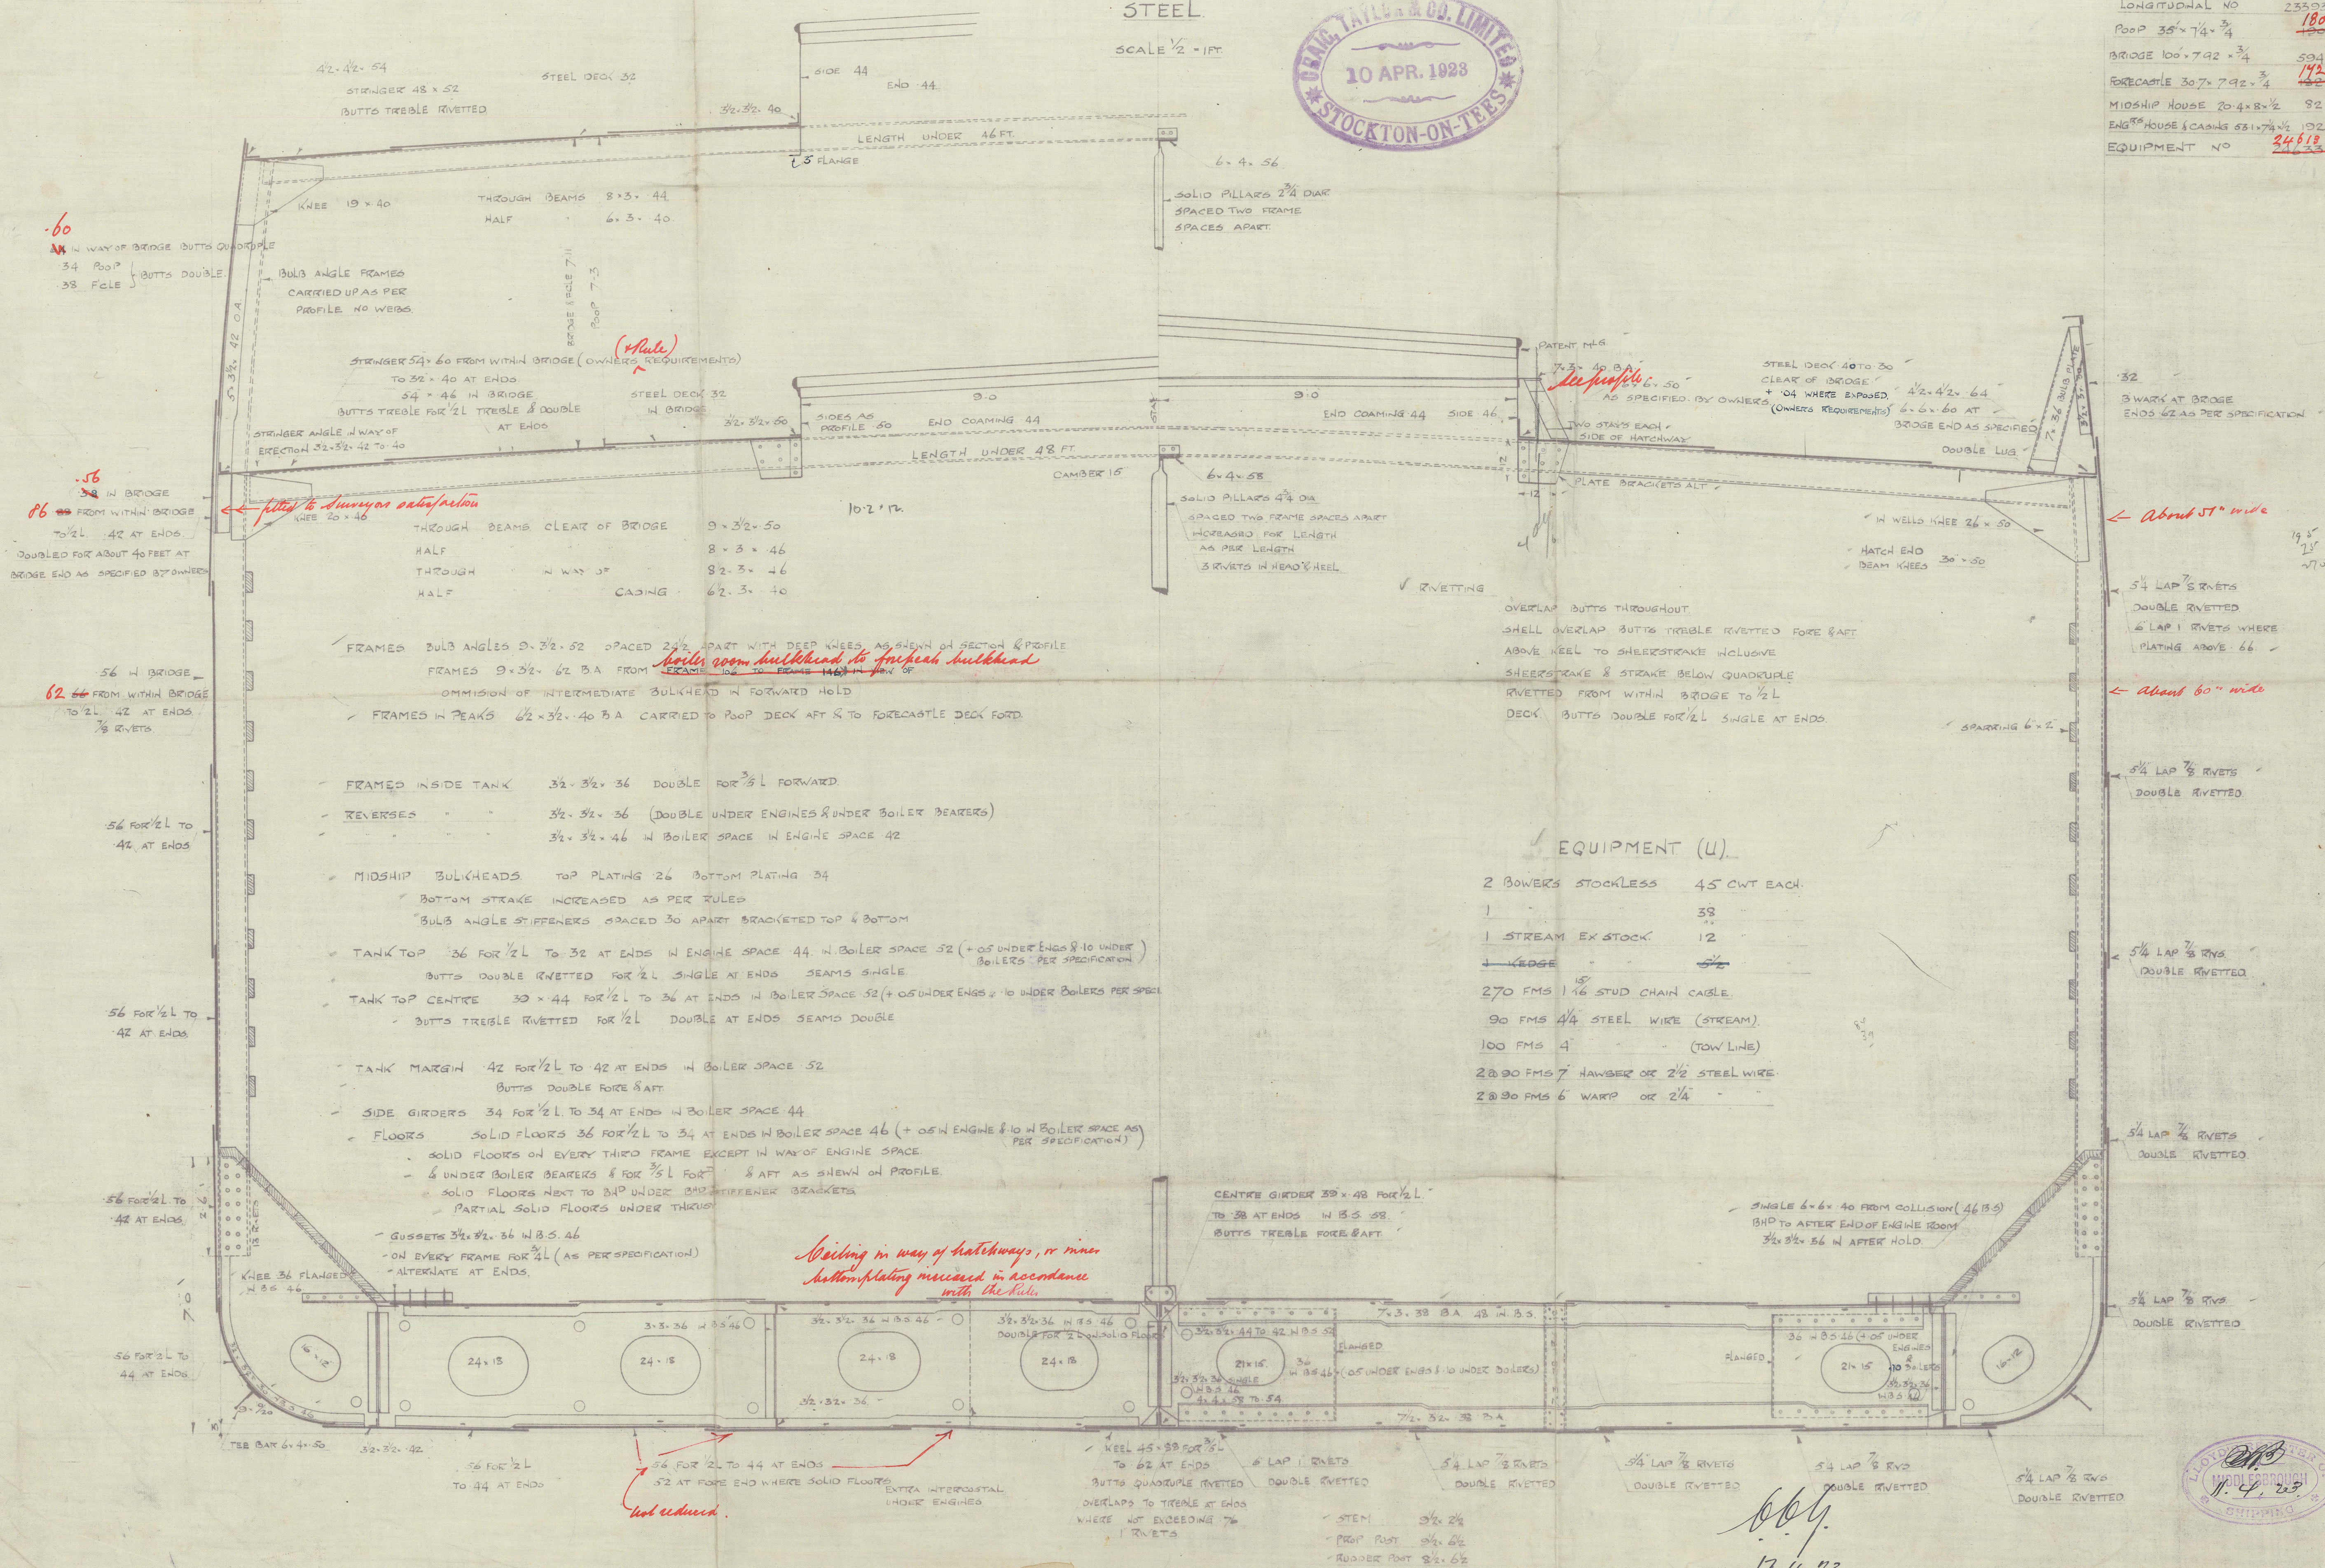





Meat Craig Taylor & Co. Ltd.

No 209.

Duplicate of No 208.

Mid: Dec.

S.S.

MDB. RPT. No.

"VIEN (EN)"

13286

X

S.S.

MDB. RPT. No.

"Wila" X

13401

Transferred to

Wila

Dis Metal

Shelves



© 2021

Lloyd's Register  
Foundation

015172-015182-0070