

M.V. EMPIRE TEDMUIR.
MIDSHIP SECTION AS FITTED.

SCALE $\frac{1}{2}$ " = ONE FOOT.

DIMENSIONS.

LENGTH BET. P.P.'S 190 FT 0 INS.
BREADTH MOULDED 32 FT 0 INS.
DEPTH MOULDED 14 FT 9 INS.

CLASS LLOYDS 100.A.1. CARRY PETROLEUM IN BULK.
WITH FREEBOARD CORRESPONDING TO A SUMMER
MOULDED DRAFT OF 13 FT 0 $\frac{1}{2}$ INS.



NUMERALS.

D	14.75
L x D	2803
L x (B + D)	8883
L ÷ D	12.88



EQUIPMENT.

2 BOWER ANCHORS STOCKLESS EACH	2 $\frac{1}{4}$ CWTs
1 BOWER ANCHOR STOCKLESS SPARE	18 "
1 STREAM " EX. STOCK	5 $\frac{3}{4}$ "
210 FTMS $1\frac{3}{8}$ " STUD LINK CABLE	
60 " $3\frac{3}{4}$ " G.12 FLEXIBLE STEEL WIRE, STREAM.	
90 " 3" " " " TOW WIRE.	
90 " 2 $\frac{1}{2}$ " " " " " HAWSERS.	
90 " 1 $\frac{3}{4}$ " " " " " WARPS.	


STEM	6" $1\frac{1}{2}$ "
FRAMING IN PEAKS	SPACED 22"
" ELSEWHERE	" 22 $\frac{1}{2}$ "

BULB ANGLES ARE N.B.S.

TEST 5'-0" ABOVE CROWN.
CAMBER 7 $\frac{1}{8}$ "

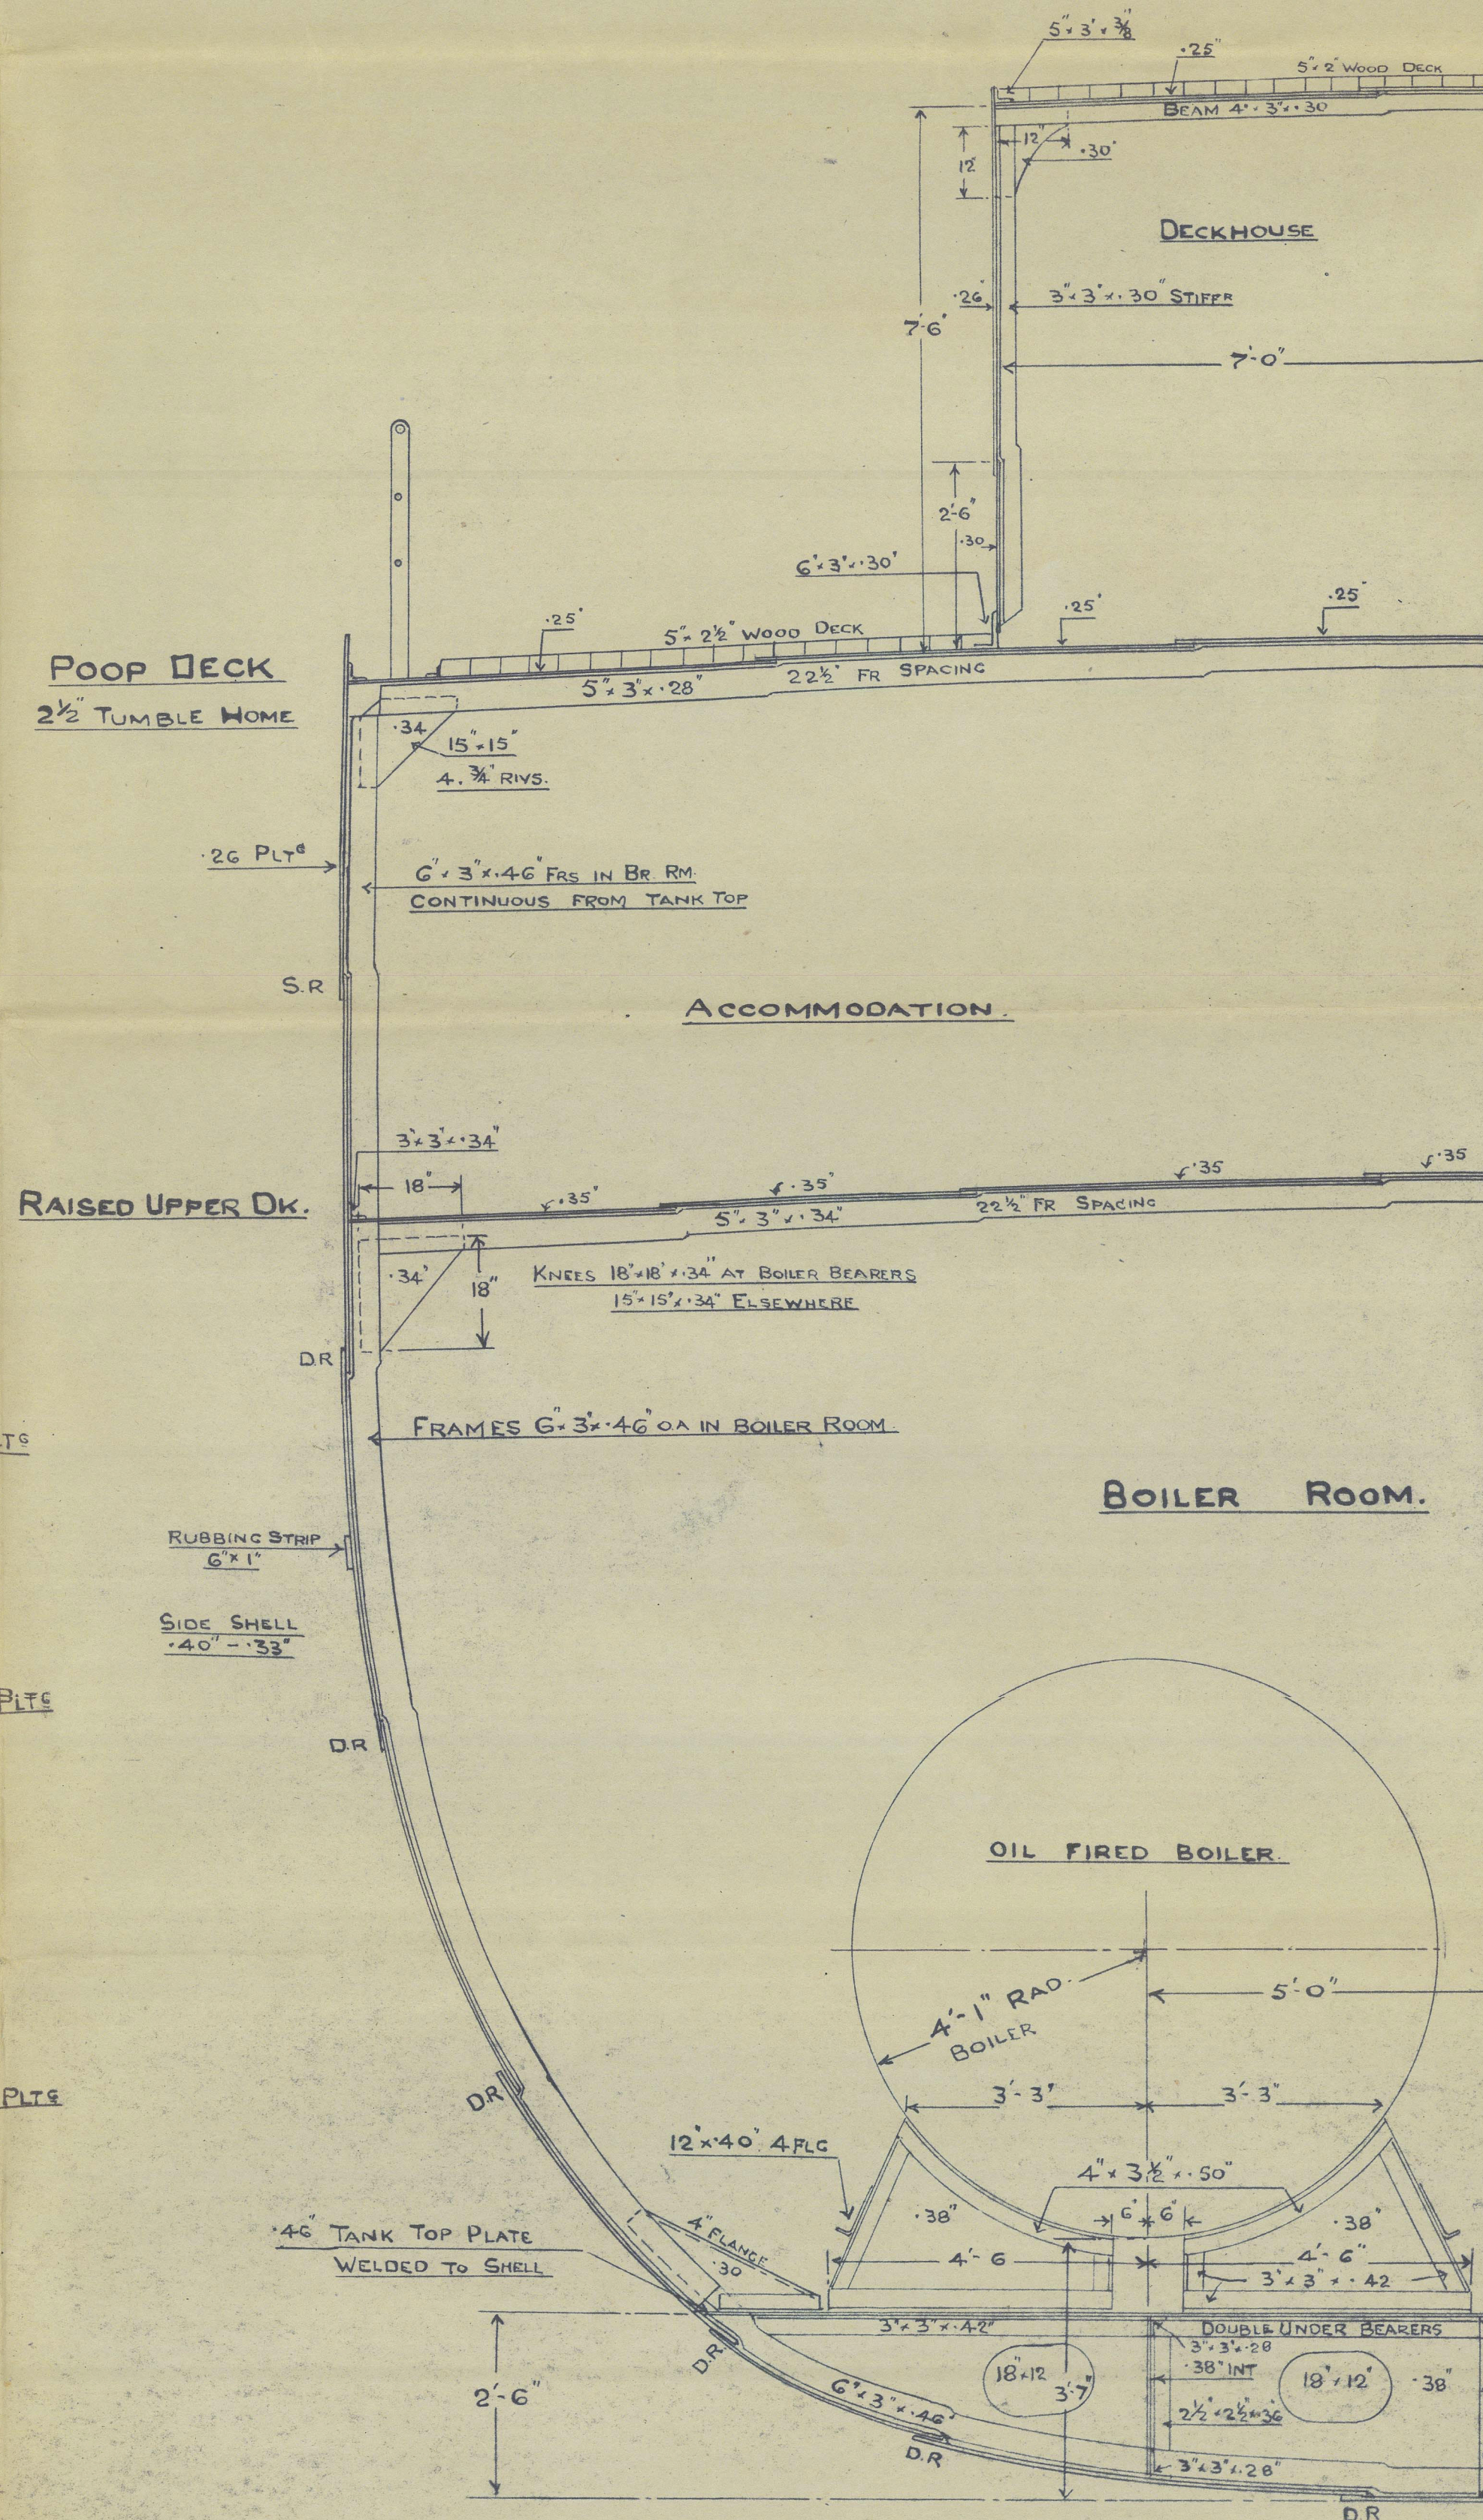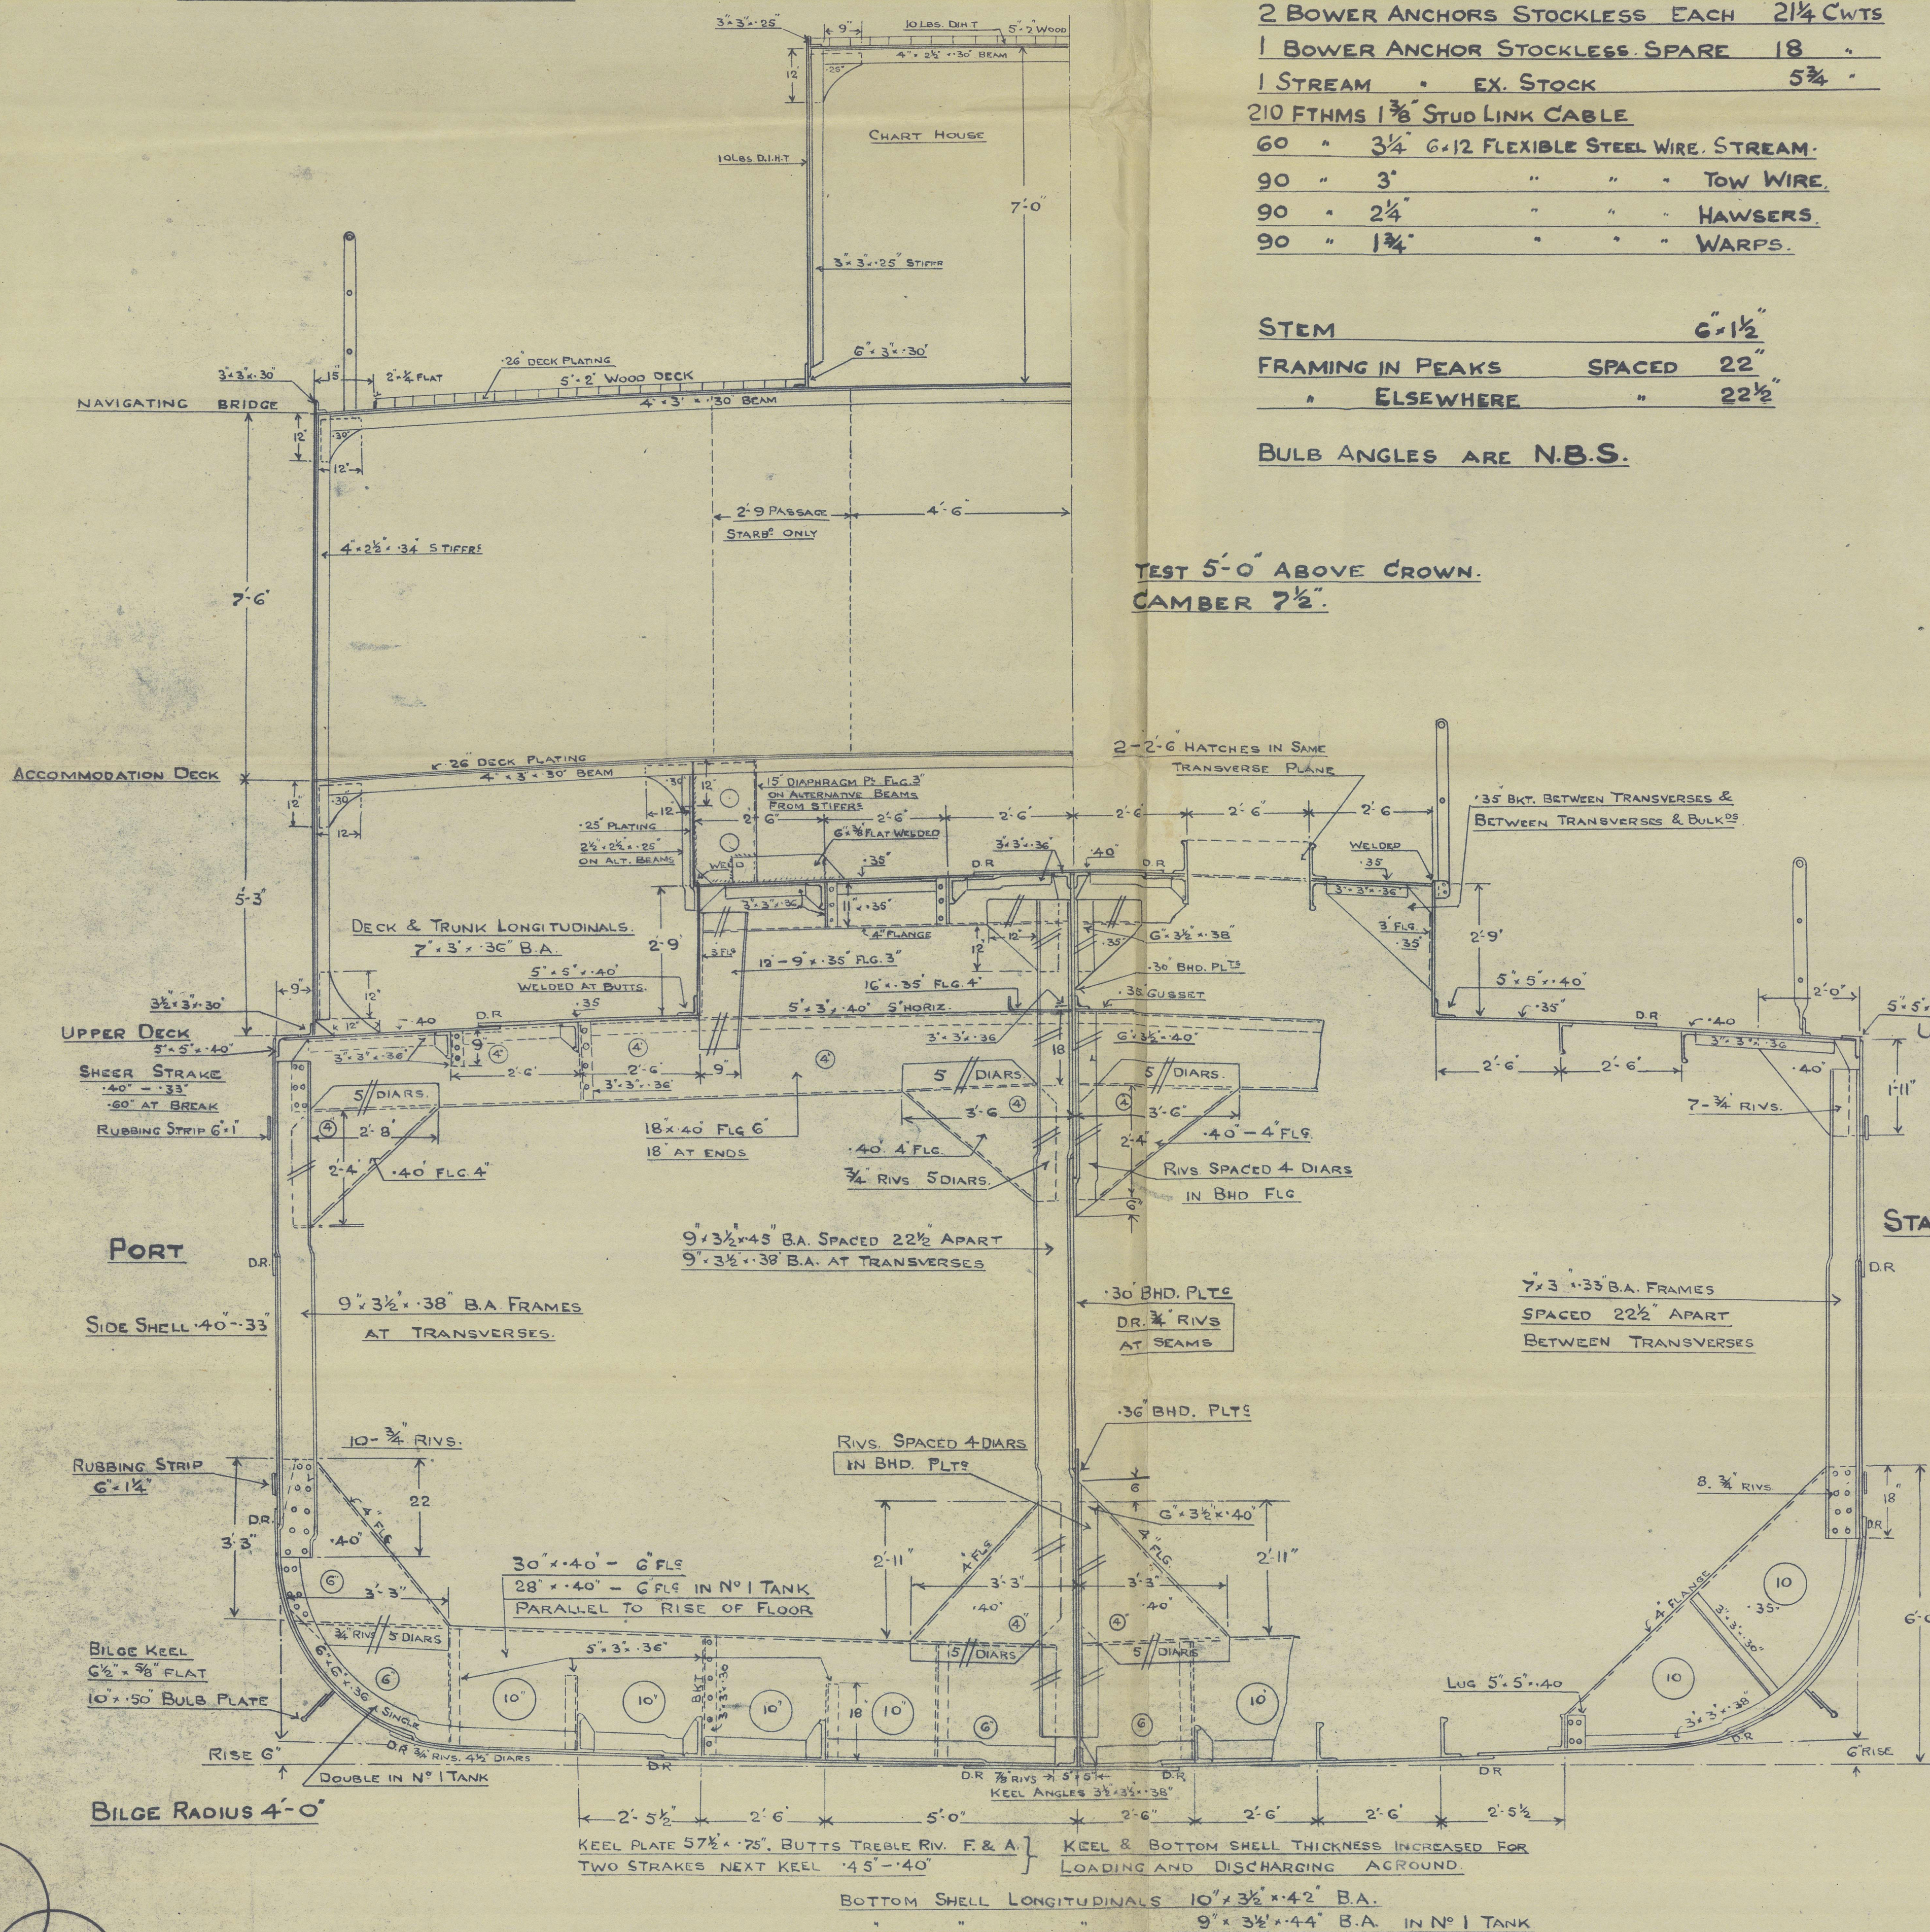

SECTION THRO' BOILER ROOM.
IN WAY OF N.W.T. FLOOR.

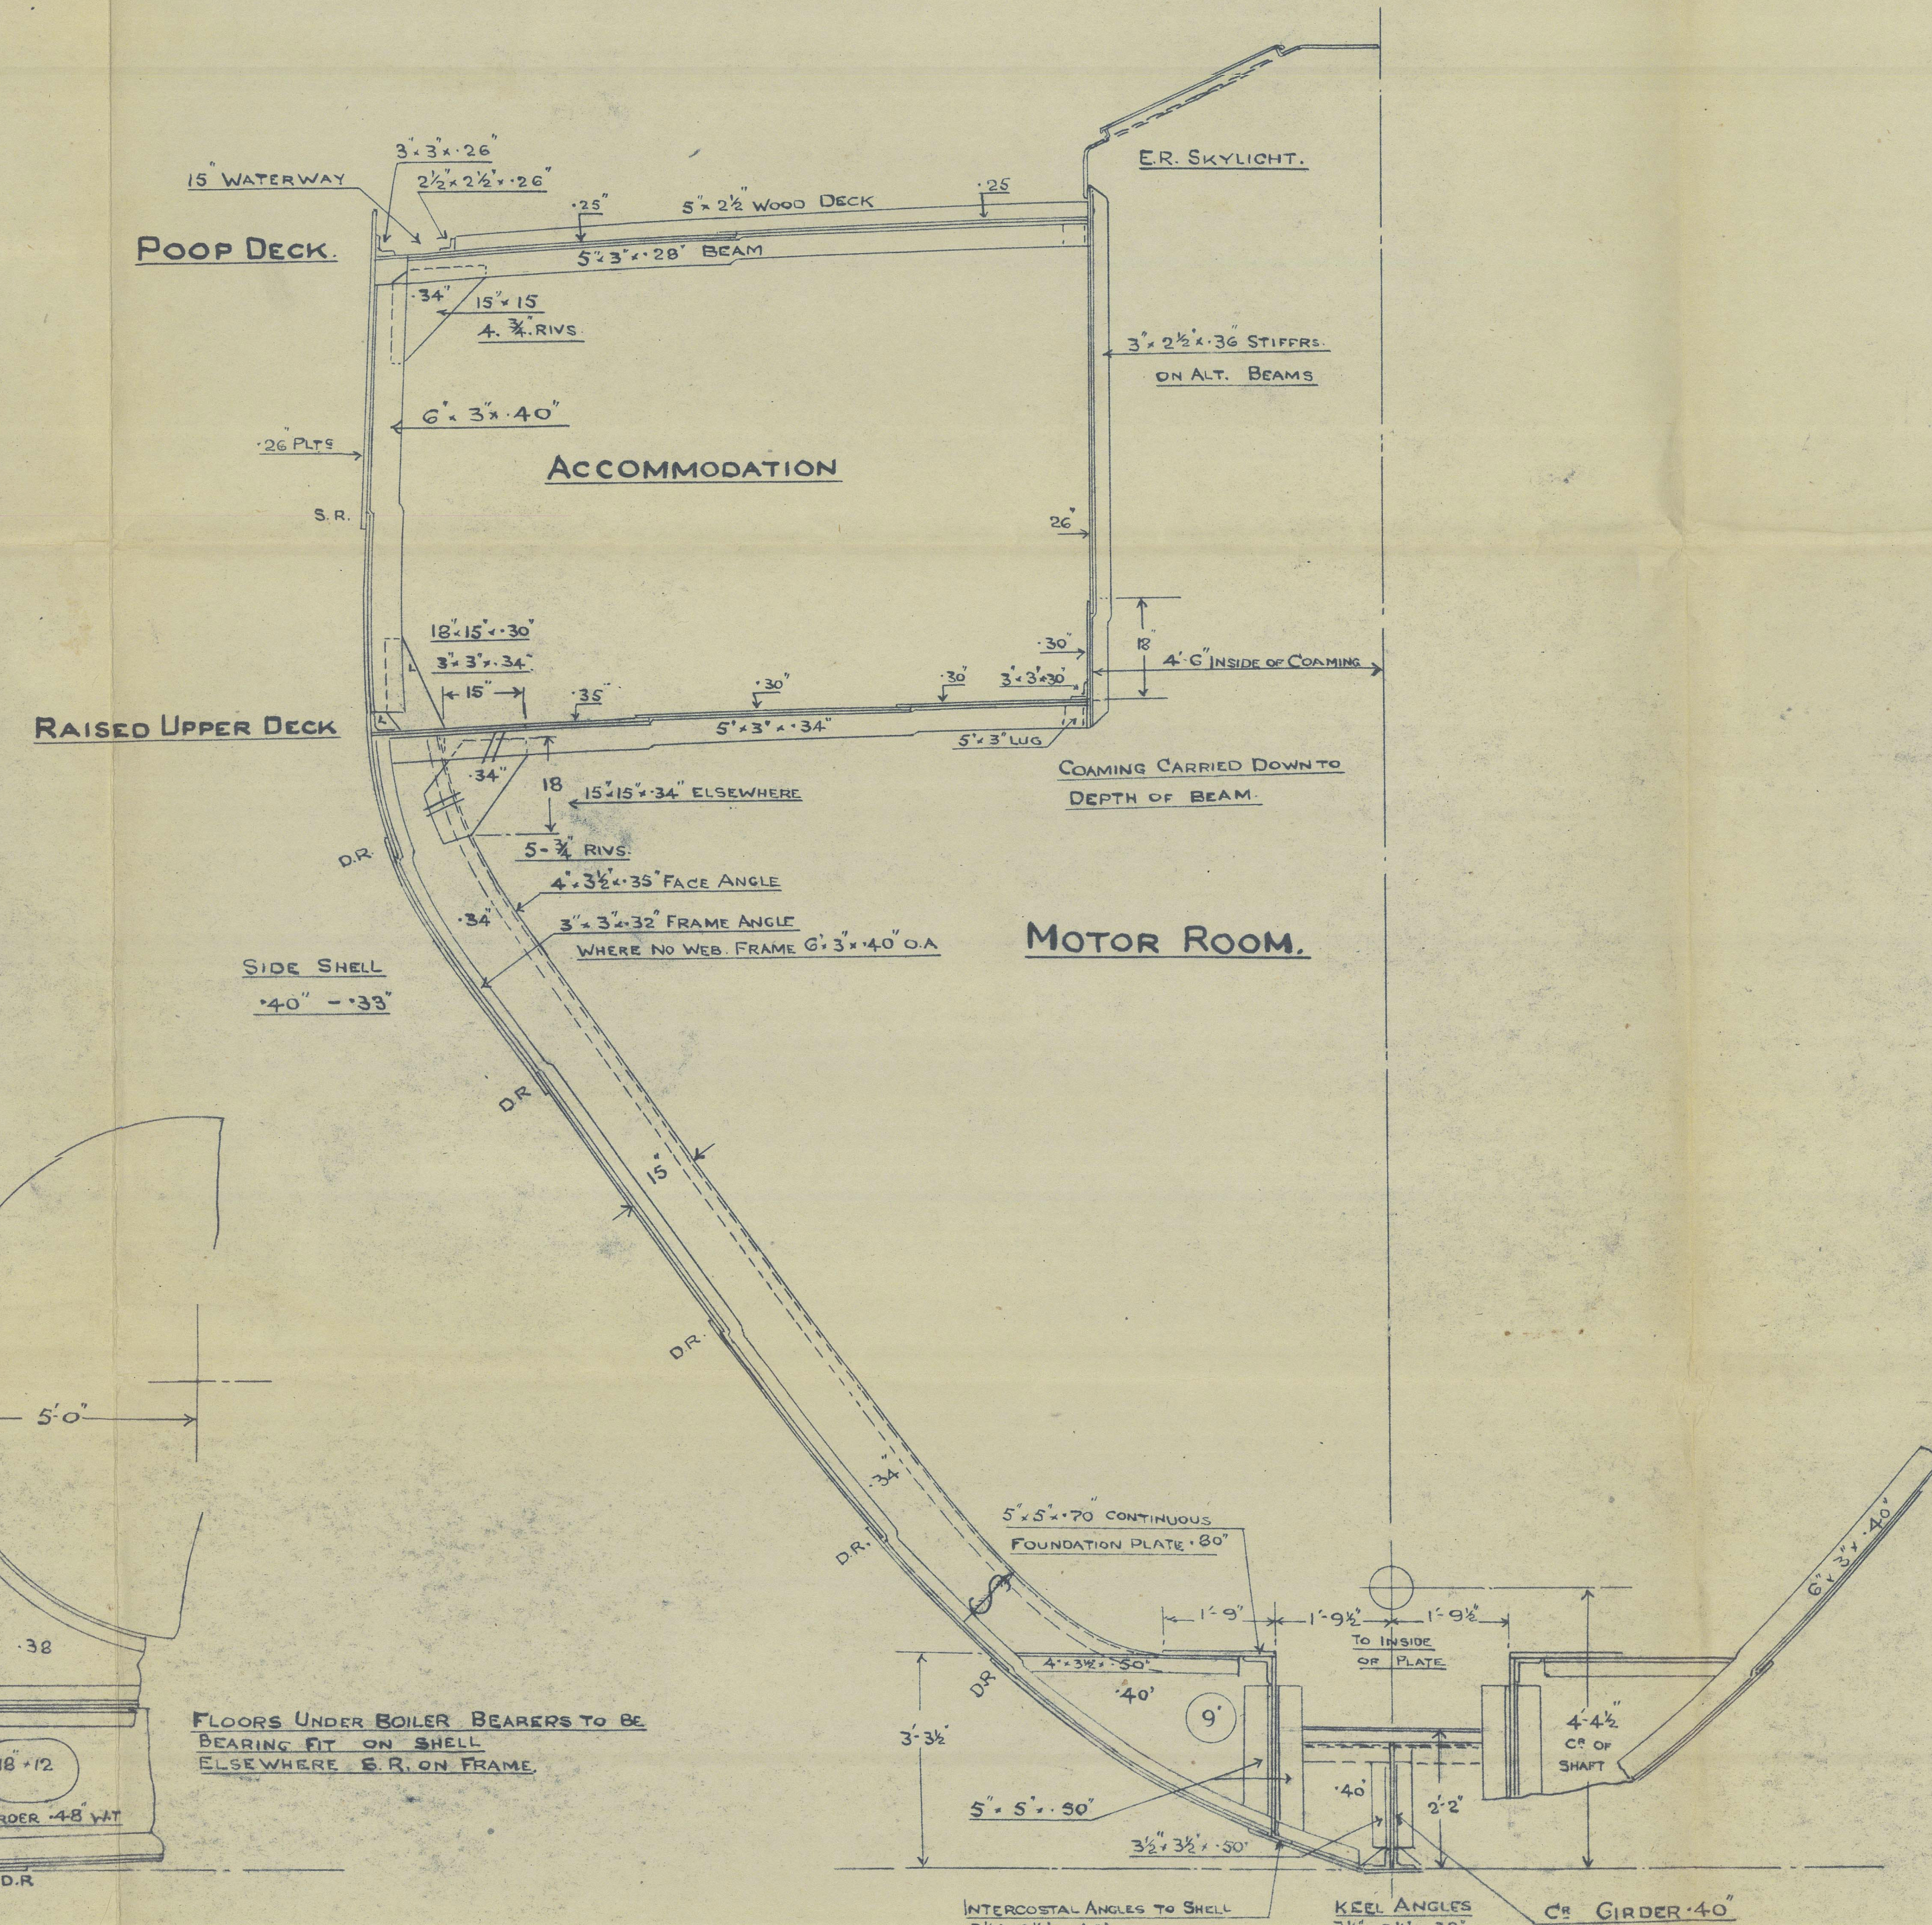

SECTION THRO' ENG. ROOM.
IN WAY OF WEB AT FRAME 14.

As J Inglis Esq

No 1313

"AQUEITY" ✓

M/M. 4143

"Empire ^{EX} Admiral" AQUEITY

Midship Section as fitted

Glasgow Reg. No 70705)

Empire Admiral

Empire Midship)
(No 1311)



© 2021

Lloyd's Register
Foundation

015188-015197-0267