

PROFILE & DECK PLANS.


S.S. N° 798.

SCALE 1/8" = 1 FOOT

LENGTH 340'-0" x 48'-6" MLD x 25'-3" MLD TO CLASS

B.S. * SPECIAL SURVEY, BRITISH CORPORATION.

NOTE: OBS INDICATES OLD BRITISH STANDARD SECTION
NBS " " " " " "

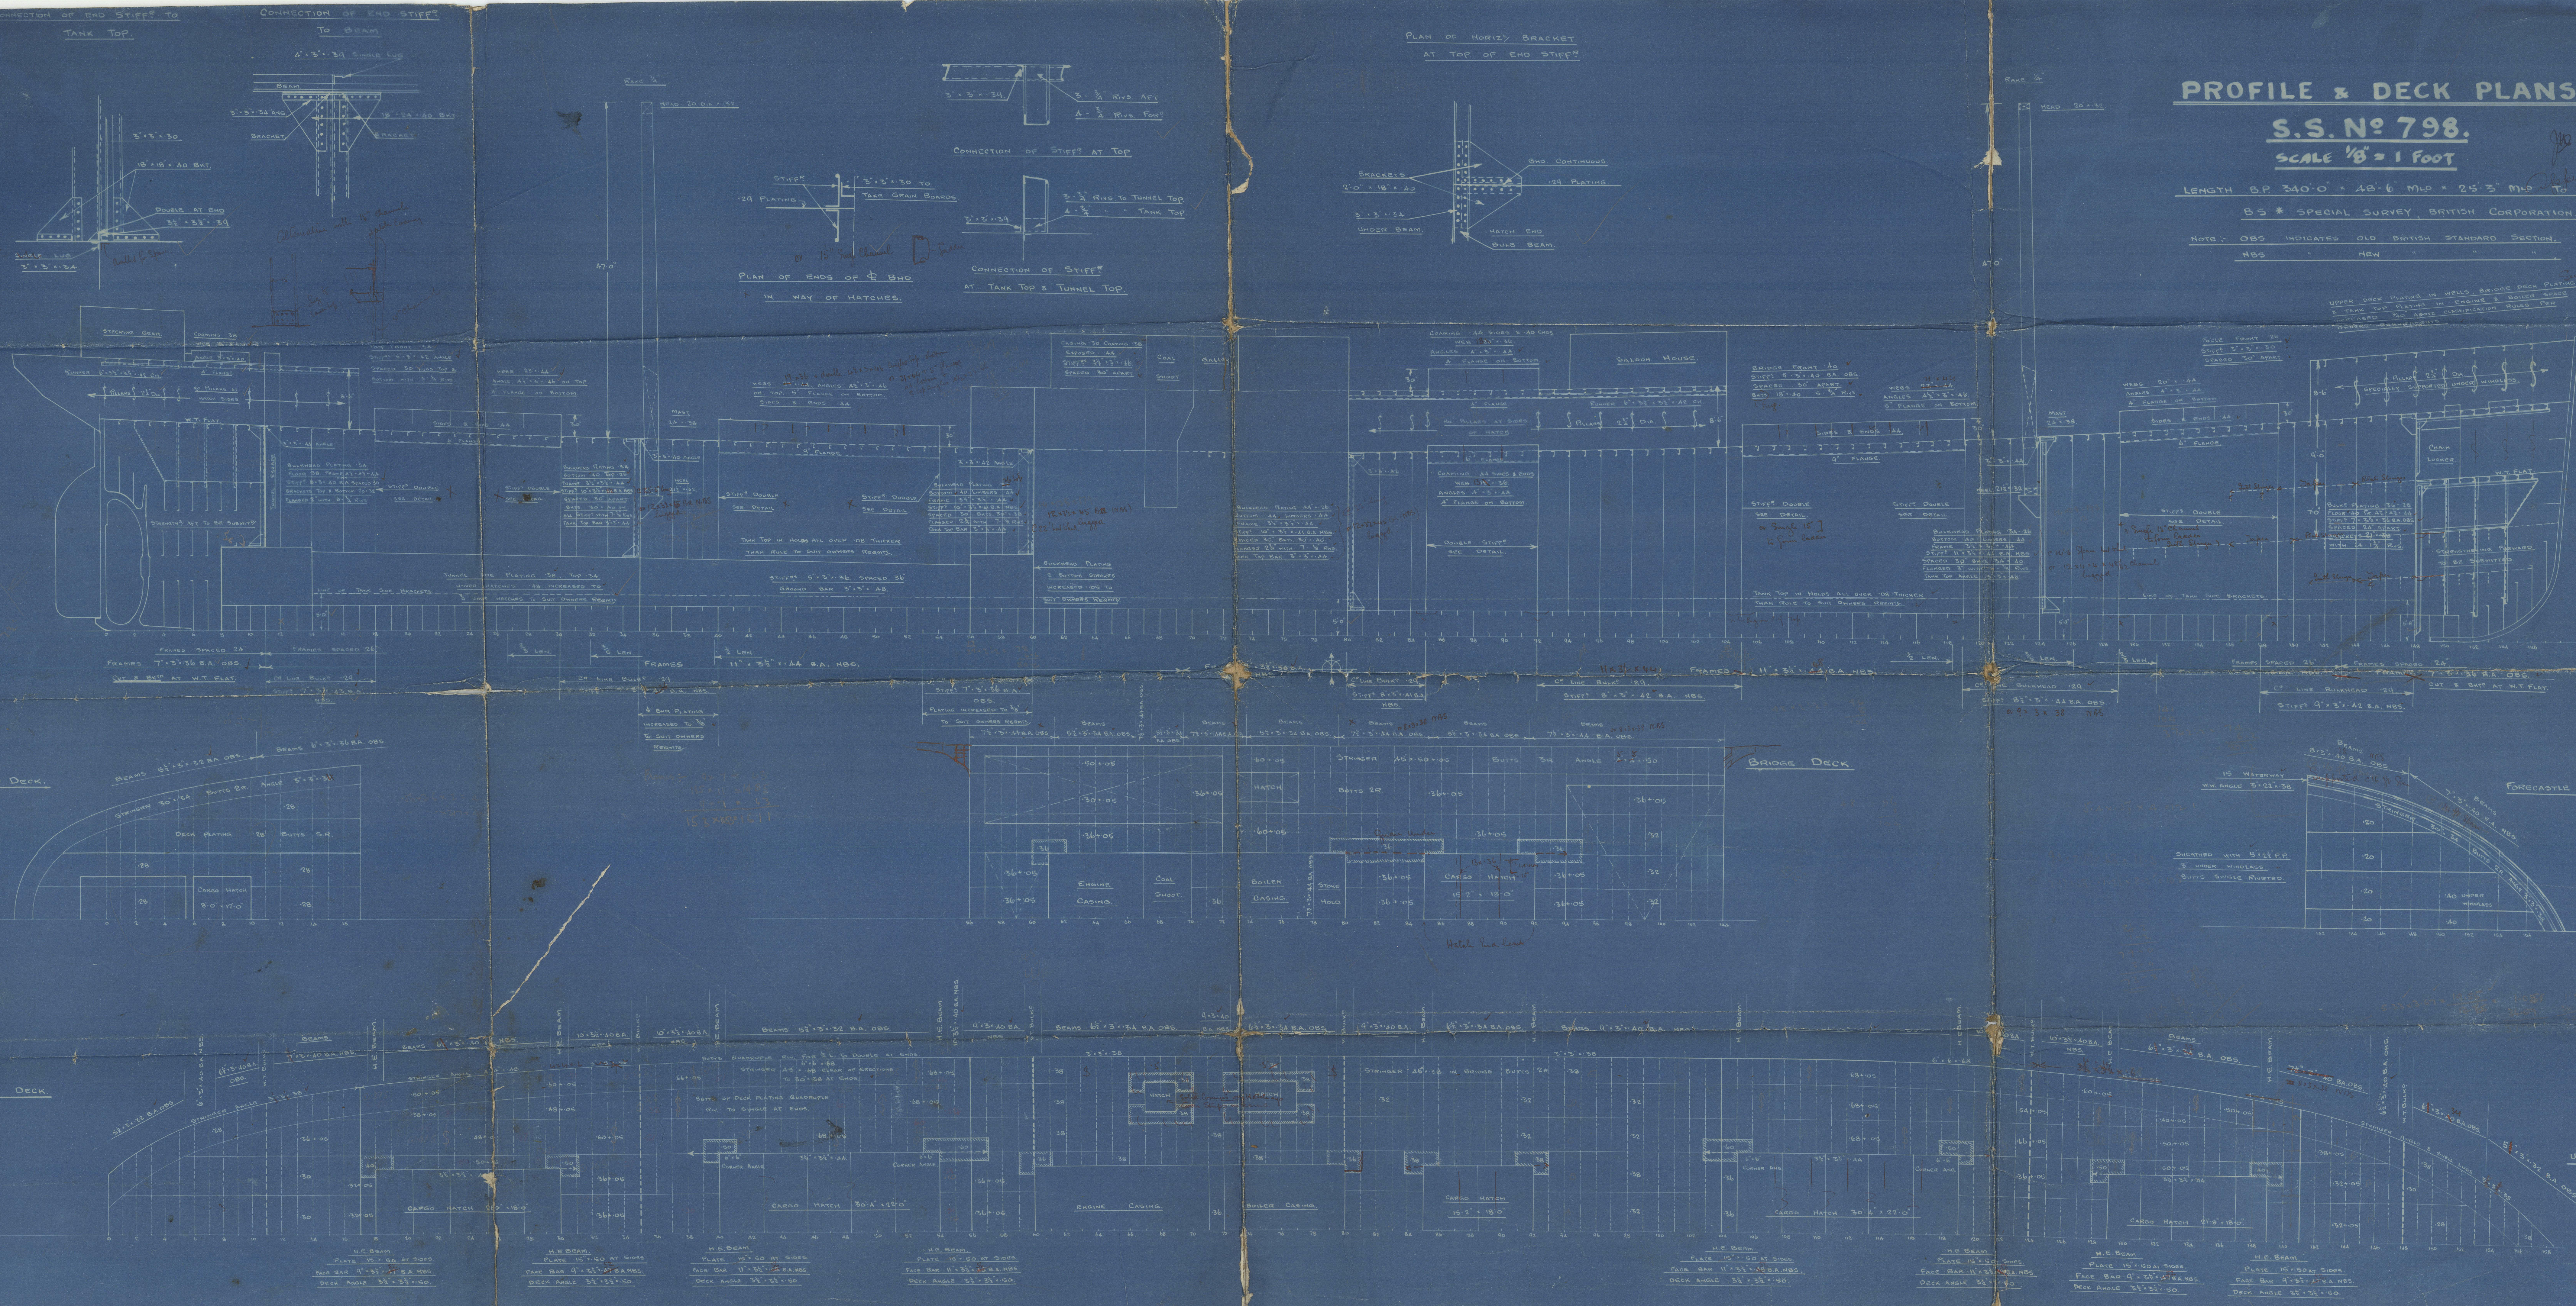

2.

Profile & Deck.

Lithgows Ltd.

N^{os} 498 & 813.

N/N LORNA

6 . 8 . 26

L.b. 25 . 8 . 26. for 798

L.b. 30 . 11 . 27. for 813

NN LORNA

Ex. 98 "Baron Tweedmouth" *

813 "Kingsborough" ^{EX} NOW BASFORD
NIN

IZMIT

Bag

016198-016212-0283



© 2021

Lloyd's Register
Foundation