

30 AUG 1933  
 LLOYD'S REGISTER  
 LONDON




Approved  
 2-9-33

S S N°36.  
 PRELIMINARY.  
 PROFILE & STEEL DECK

SCALE 1/16" = 1 FOOT

DIMENSIONS AS 220'-0" x 35'-0" MLD x 14'-0" MLD

To CLASS B.1\* (BULK OIL CARRIER)

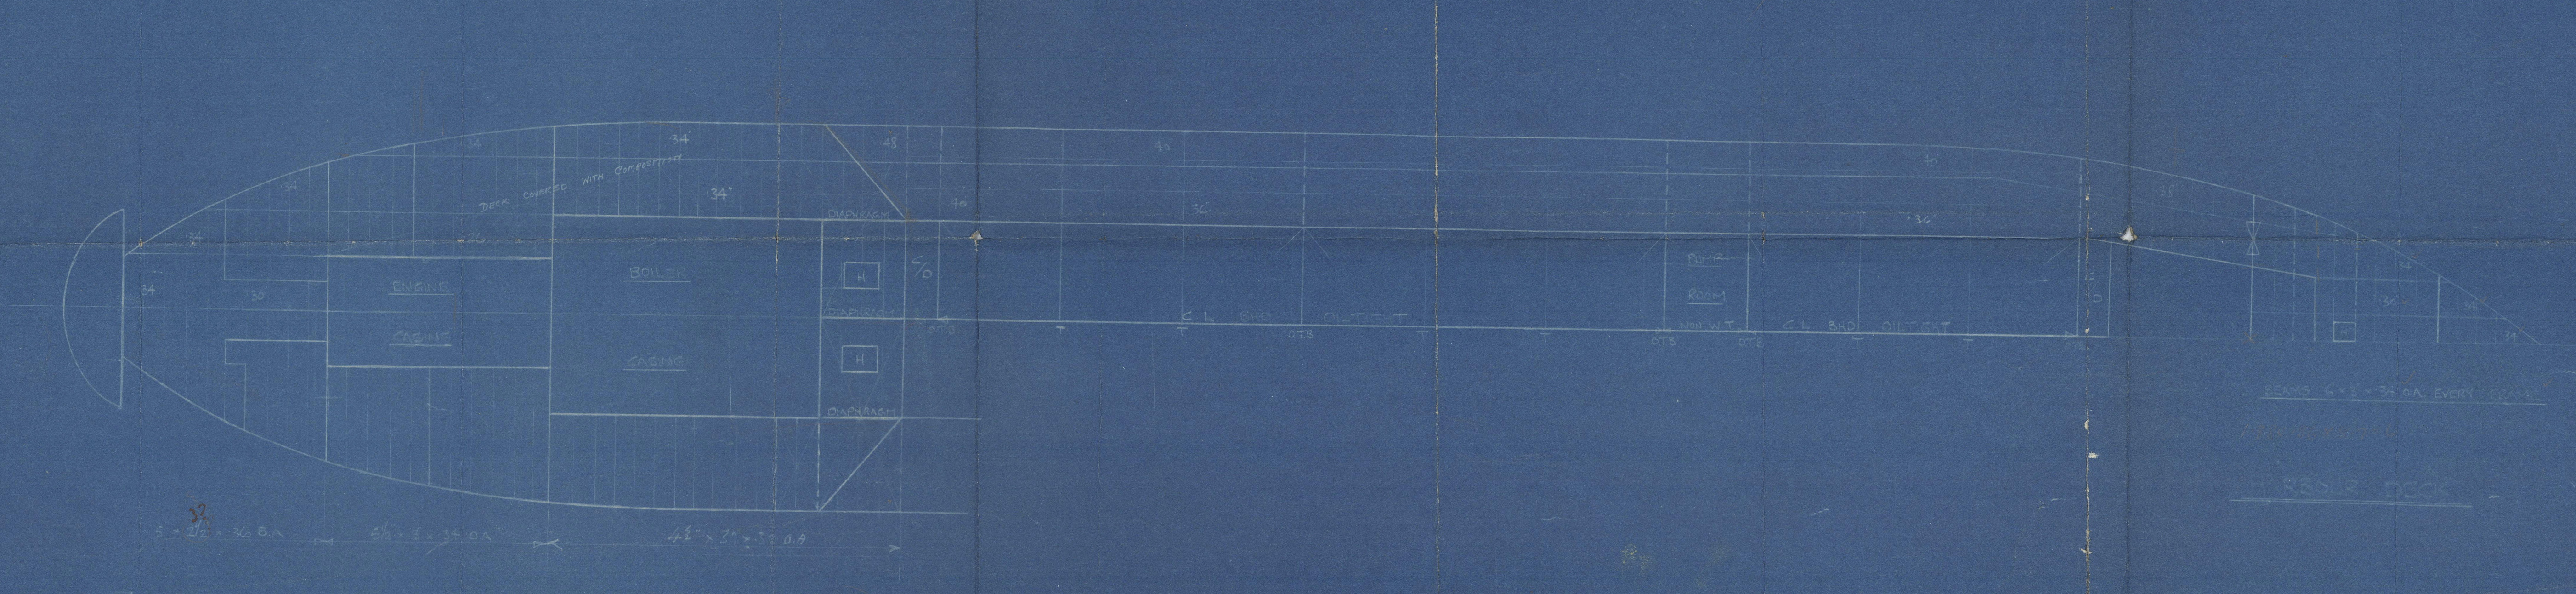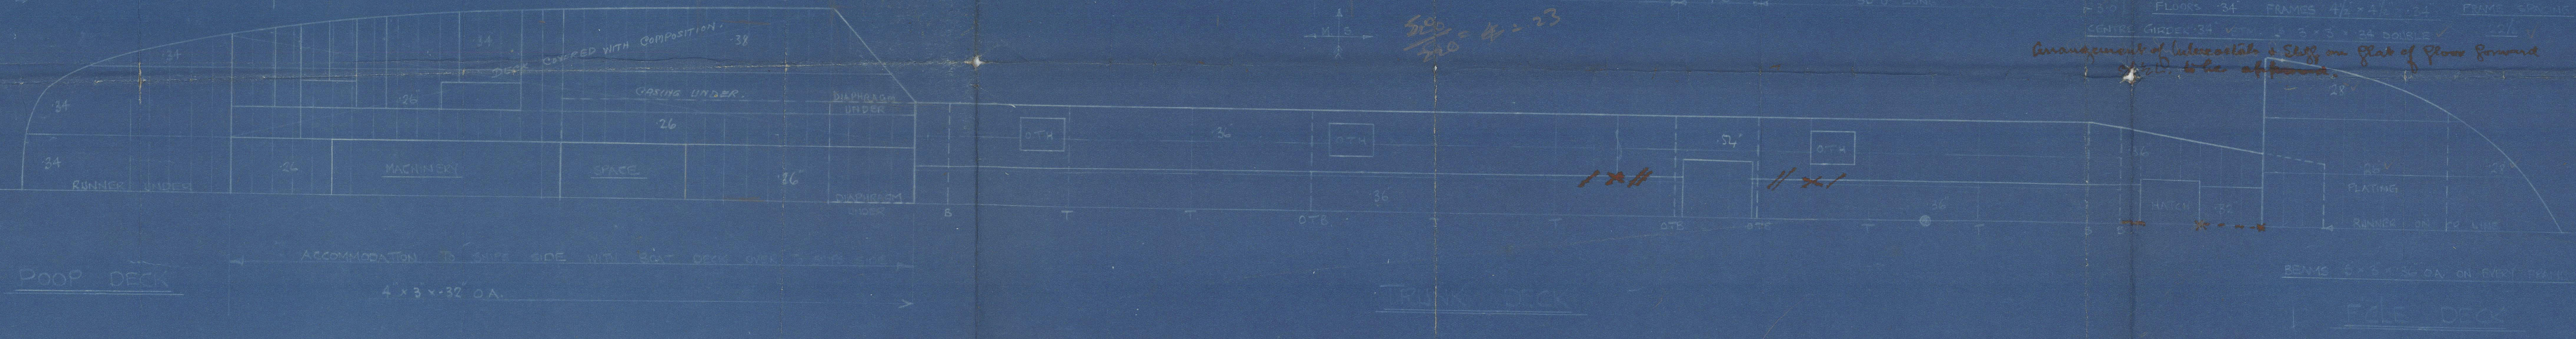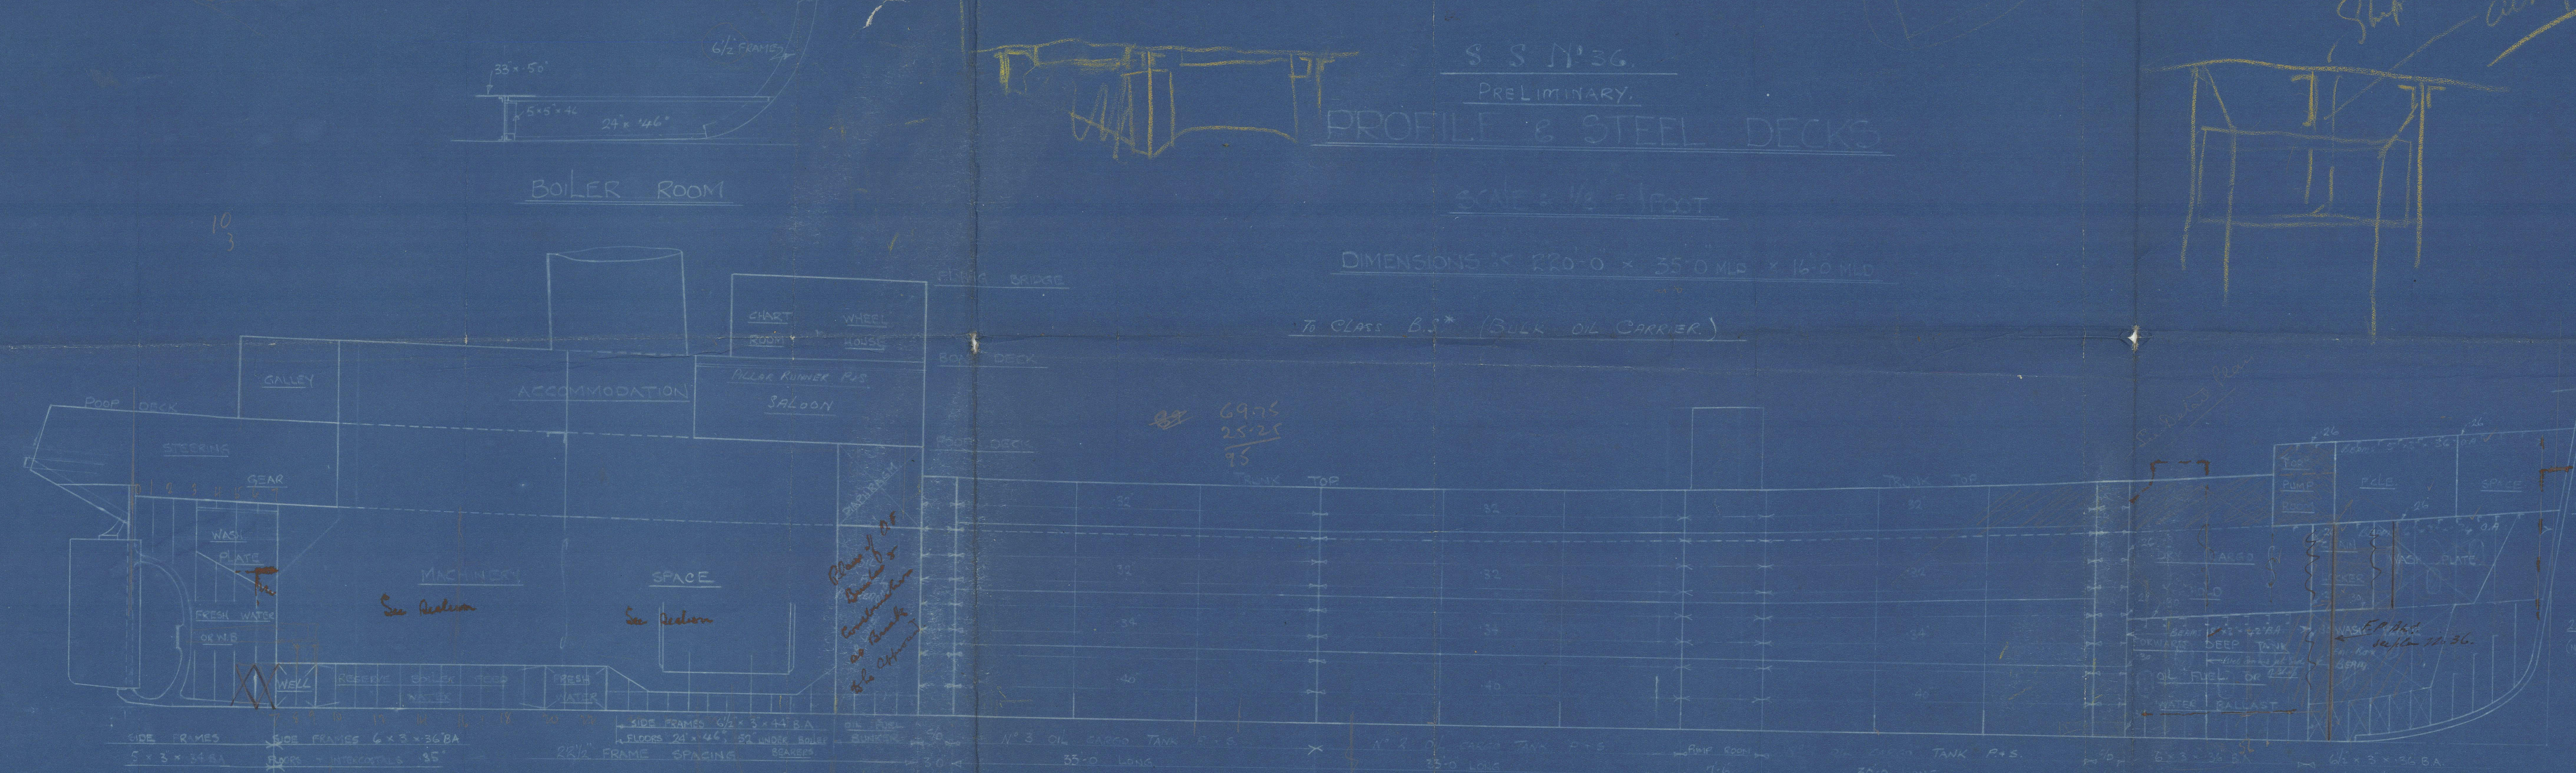

Arrangement of Lubricating & Serv. on Deck of Plan Forward

30 AUG 1933  
 LLOYD'S REGISTER  
 LONDON



0267



© 2021

Lloyd's Register  
Foundation



2


Profile & Deck.  
Blythwood S.S. Co.  
No. 36.

T.C. 30.8.33.


2.9.22.

'BASSETHOUND'

220'

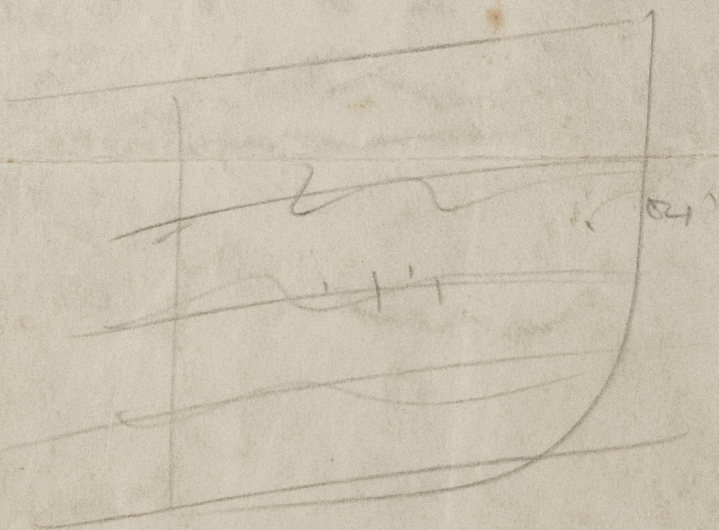

Blythwood S.S. Co. No. 36

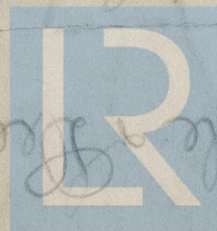

© 2021

Lloyd's Register  
Foundation