
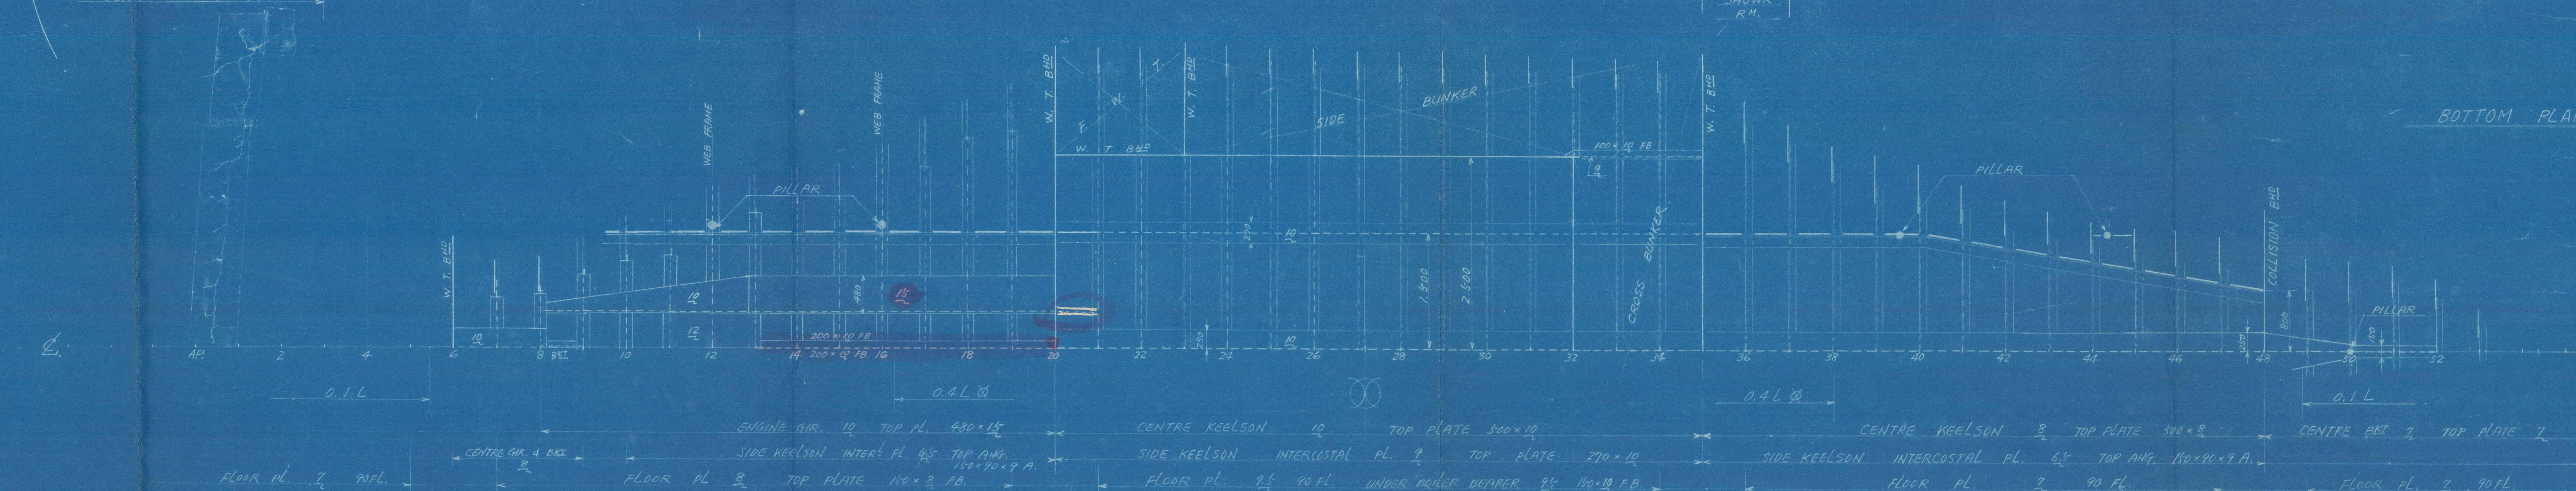
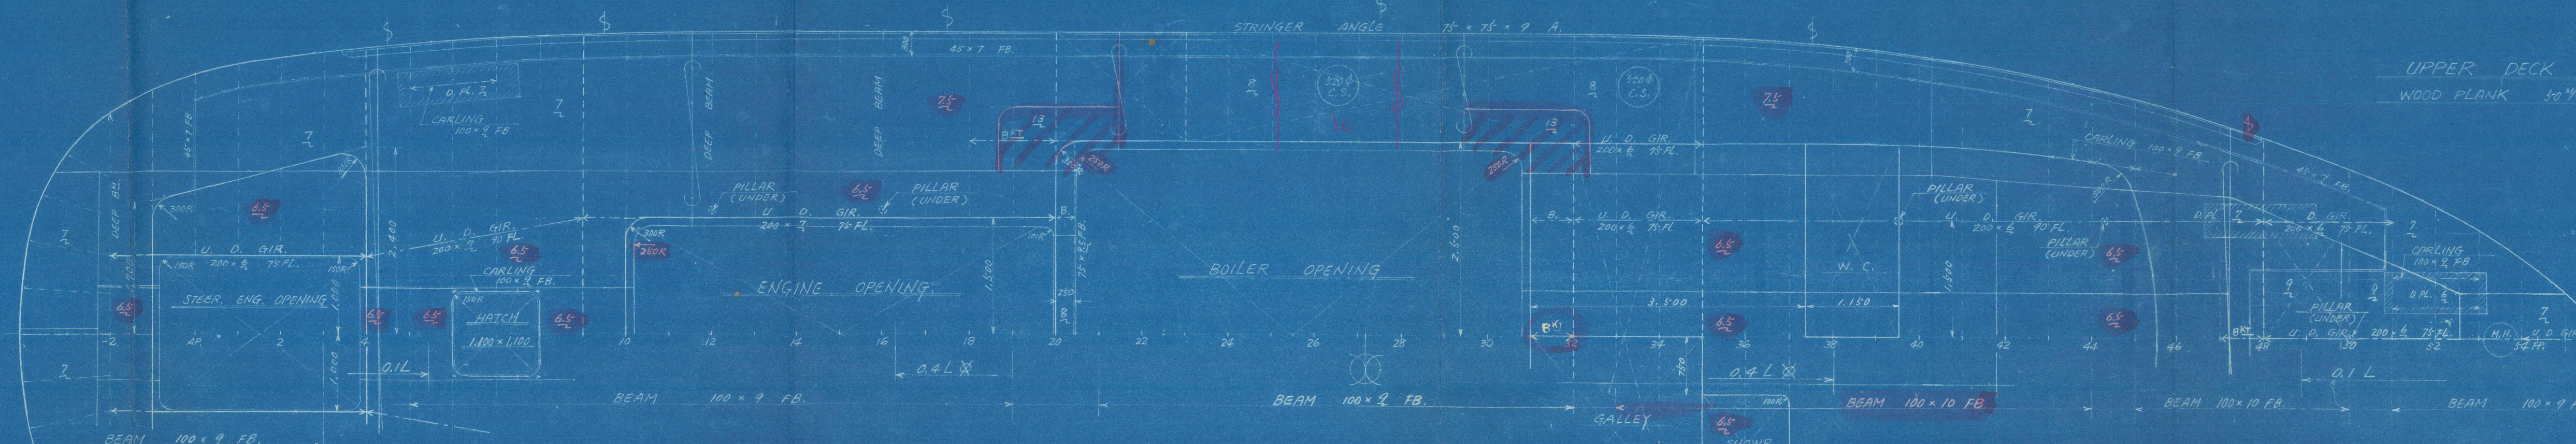
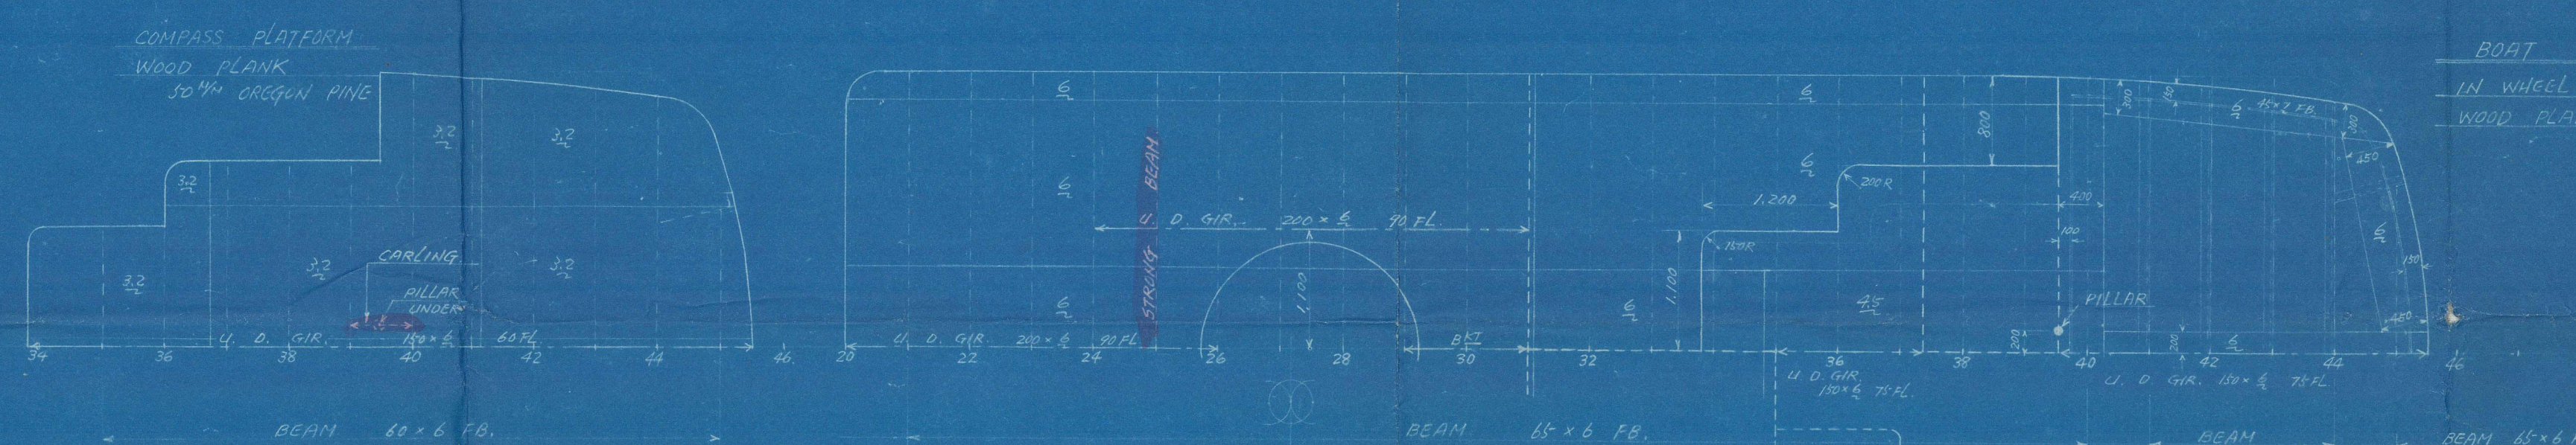


図面来歴
昭和25年6月20日 社別
昭和25年7月20日 社別
昭和25年7月20日 社別

PRINCIPAL DIMENSIONS	
LENGTH P.P.	27M 900
BREADTH MOULDED	7M 800
DEPTH MOULDED	3M 500
DESIGNED DRAUGHT MOULDED	2M 650

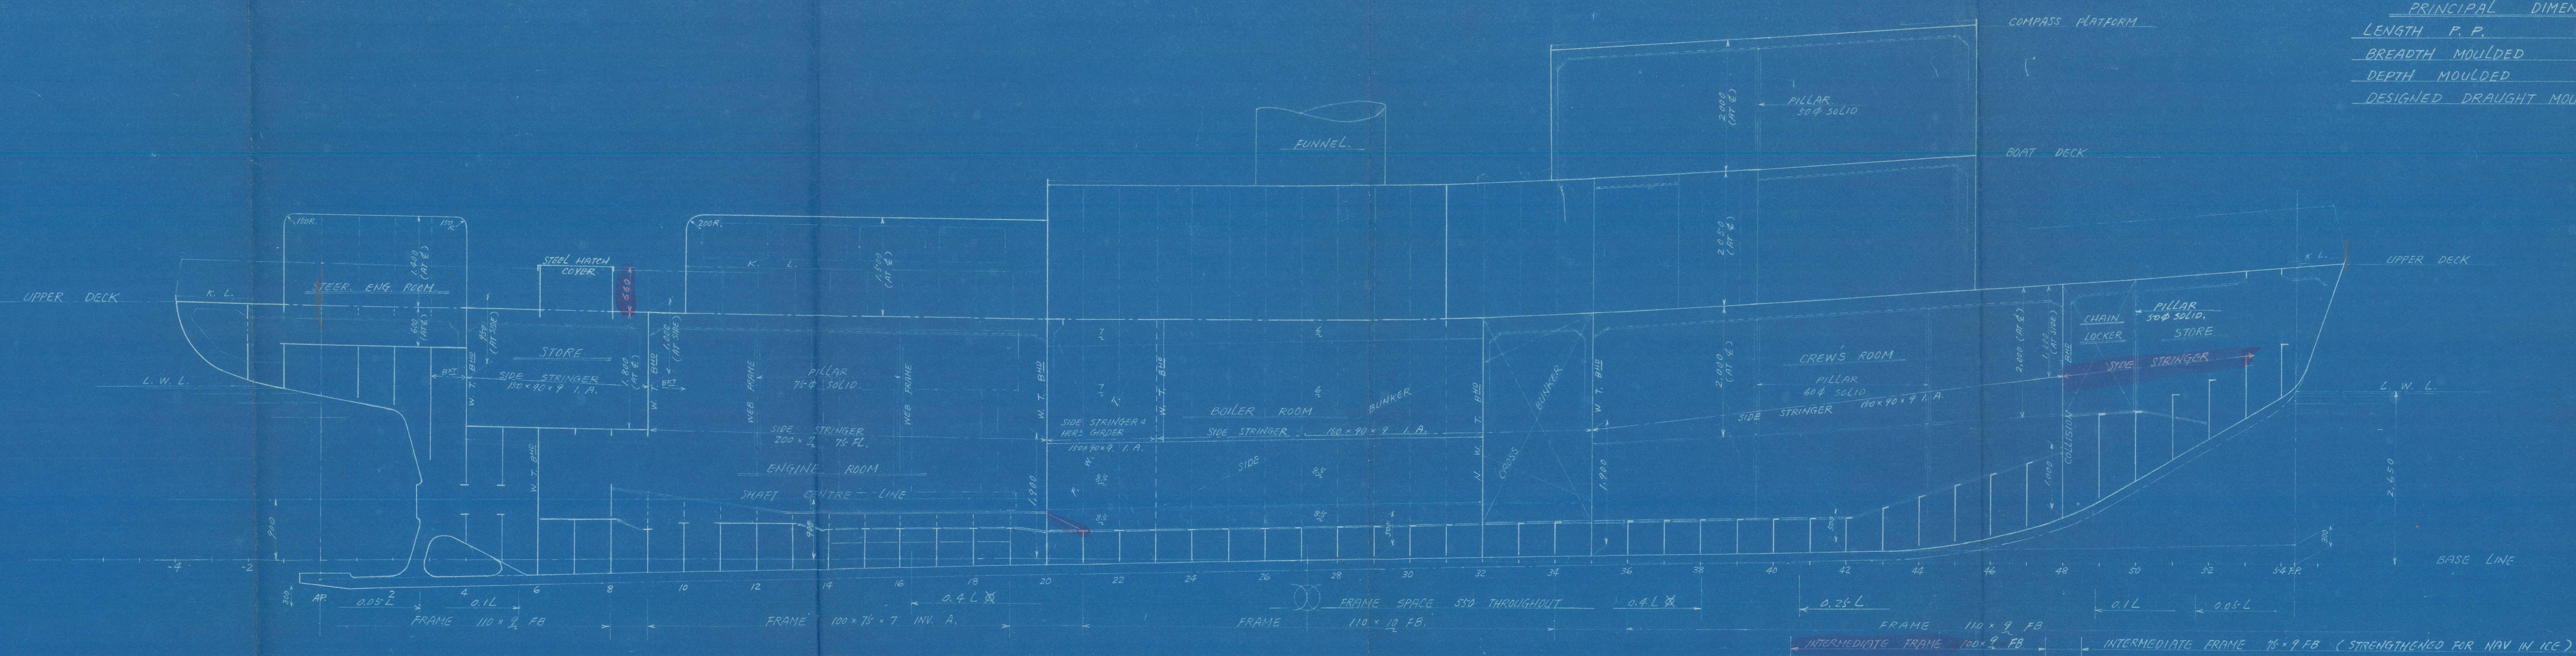

MAINT STEAM RECIP 400/500 IHP

3756/9

Hand Rev
3756-9



FOR APPROVAL
(REVISION)

V6 "TRANSMASHIMPORT" MOSCOW
U. S. S. R.

D. No 2582 SINGLE SCREW
STEAM TUG

CONSTRUCTION PROFILE & PLANS
SCALE 1/50

HITACHI SHIPBUILDING & ENGINEERING CO. LTD.
- OSAKA, JAPAN -

DESIGNING DIVISION

SHIP DESIGN SECTION

DATE JUNE 30 1954
DRAWING NO H-02
SHEET NO 116435

Hitachi S. & E. Co. Ltd.

Mukaishima styd.



Nos. 3786 and 3787

Profile & Deck

As Approved.

No. 3786 "KONDOR" Kobe Rpt. No. F.E. 3798

No. 3787 "JAGUCHA" Kobe Rpt. No. F.E. 3799

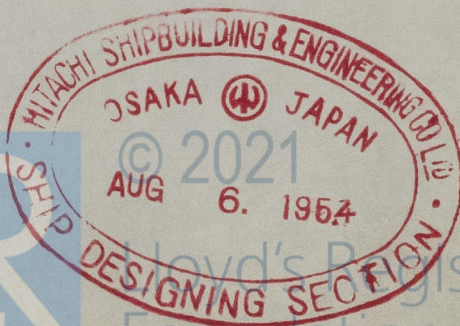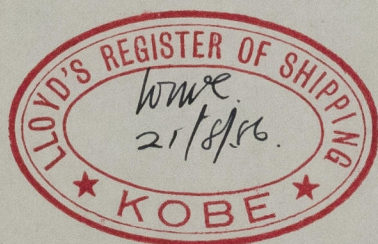

015253-015263-0282