


SECTION THROUGH F. NO. 20 LOOKING AFT.

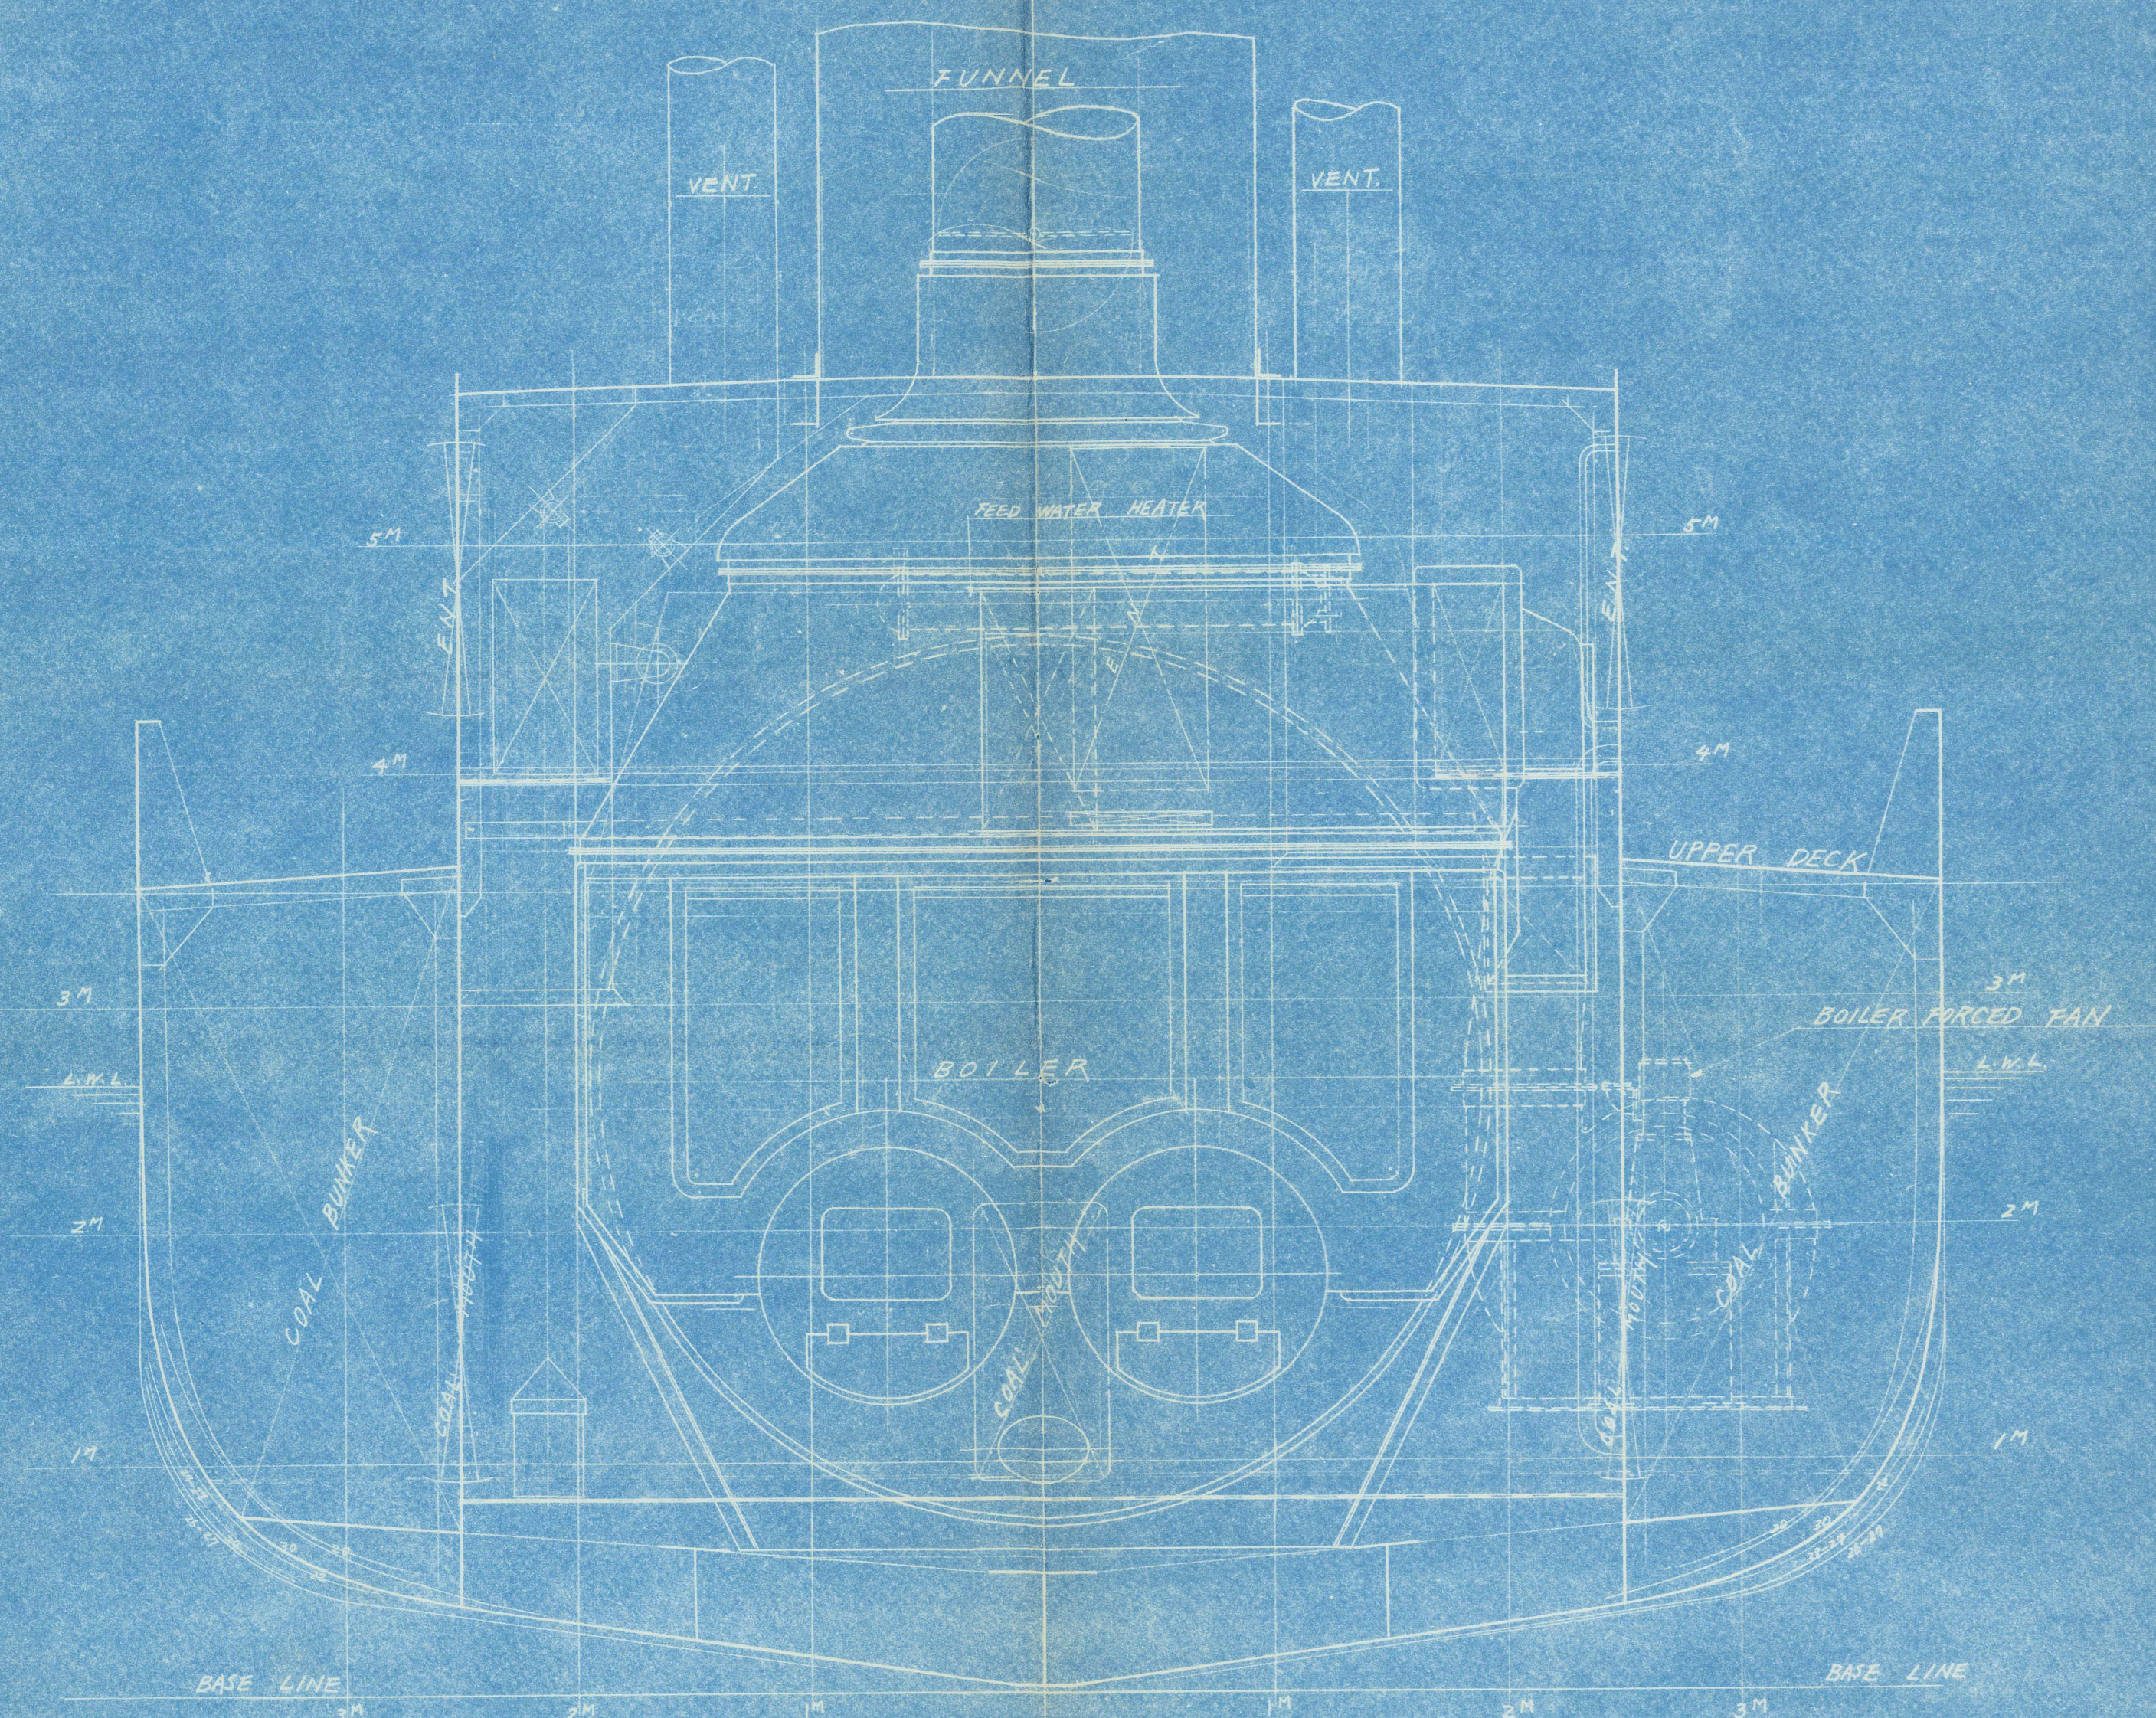

SECTION THROUGH F. NO. 30 LOOKING AFT.

REMARK  
THE COLOURED PARTS ARE REVISED

HULL SECTION *K. I. Iwano*

|  |        |                       |             |
|--|--------|-----------------------|-------------|
| 1ST AMENDMENT  |        | %SUDOIMPORT MOSCOW    |             |
| STEAM TUG  |        | SINGLE SCREW TUG BOAT |             |
| S.N.O. 3756~7  |        |                       |             |
| ARRANGEMENT OF MACHINERIES<br>IN ENGINE & BOILER ROOM              |        |                       |             |
| SCALE 1/32   |        |                       |             |
| HITACHI SHIPBUILDING & ENGINEERING CO. LTD.<br>MUKAISHIMA SHIPYARD |        |                       |             |
| MACHINERY SECTION DESIGNING BRANCH                                 |        |                       |             |
| DATE   |        | APPROVED BY           | Z. Pleumisa |
| DRAWING NO.  | 022465 | REVIEWED BY           | a young to  |
| SHEET NO.  | 0101-3 | CHECKED BY            | not signed  |
| REMARK   |        | DRAWN BY              | 0202        |



HITACHI SBL

Prod Nos 3756/7

ARR'GT of MACHINERIES in ENGINE  
& BOILER ROOM. III



© 2021

Lloyd's Register  
Foundation

015253-015263-0289





© 2021

Lloyd's Register  
Foundation

FEB 1 5 1956