

11.4.13.  
7.5.13  
13.5.13  
16.5.13 (no. 334)  
9.6.13  
10.9.13  
28.11.13  
10.12.13  
26.1.14  
2.7.14

nos 333+4 See blue print

LONGITUDINAL SECTION OF TWIN SCREW STEAMER

DIMENSIONS 450' x 57'-6" x 34'-0" TO UPPER DECK

To CLASS 100 A.I. AT LLOYDS

SCALE  $\frac{1}{8}$  = ONE FOOT.

Deck plans to be submitted

See Blue print

C.B.  
10.4.13.

015292-015301-0021 Lloyd's Register Foundation



(4)

015292-015301-0021


Profit

Messrs Workman Clark & Co.



No. 333

See amended

Blue print.

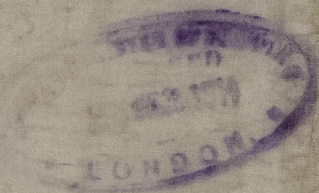

~~Blue Bag~~

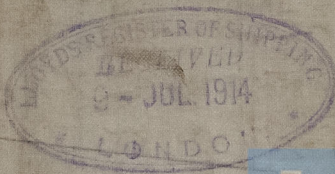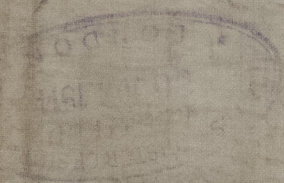

© 2021

Lloyd's Register  
Foundation