

N^{os}. 1249-50

MIDSHIP SECTION

COCHRANE & SONS LTD.

SHIPBUILDERS, SELBY

PLAN N^o. 1249/2

DRAWN BY :- H.M. 515144

SHIP N^{os}.

1249-50

1255-6

1267-8

1273-4

1279-80

1285-6

1291-2

S.T. "FLYING METEOR"

EX. "EMPIRE DENIS"

MIDSHIP SECTION

2826

N^{os} 1249-50

MIDSHIP SECTION

COCHRANE & SONS, LTD.

SHIPBUILDERS SELBY


PLAN N° 1249/2

DRAWN BY : - H.M. 515144

105'-0" B.P. : 26'-6" MLD. : 13'-0" MLD.

TO CLASS +100 A1 FOR TOWING SERVICES

SCALE - $\frac{1}{2}$ IN = 1 FT

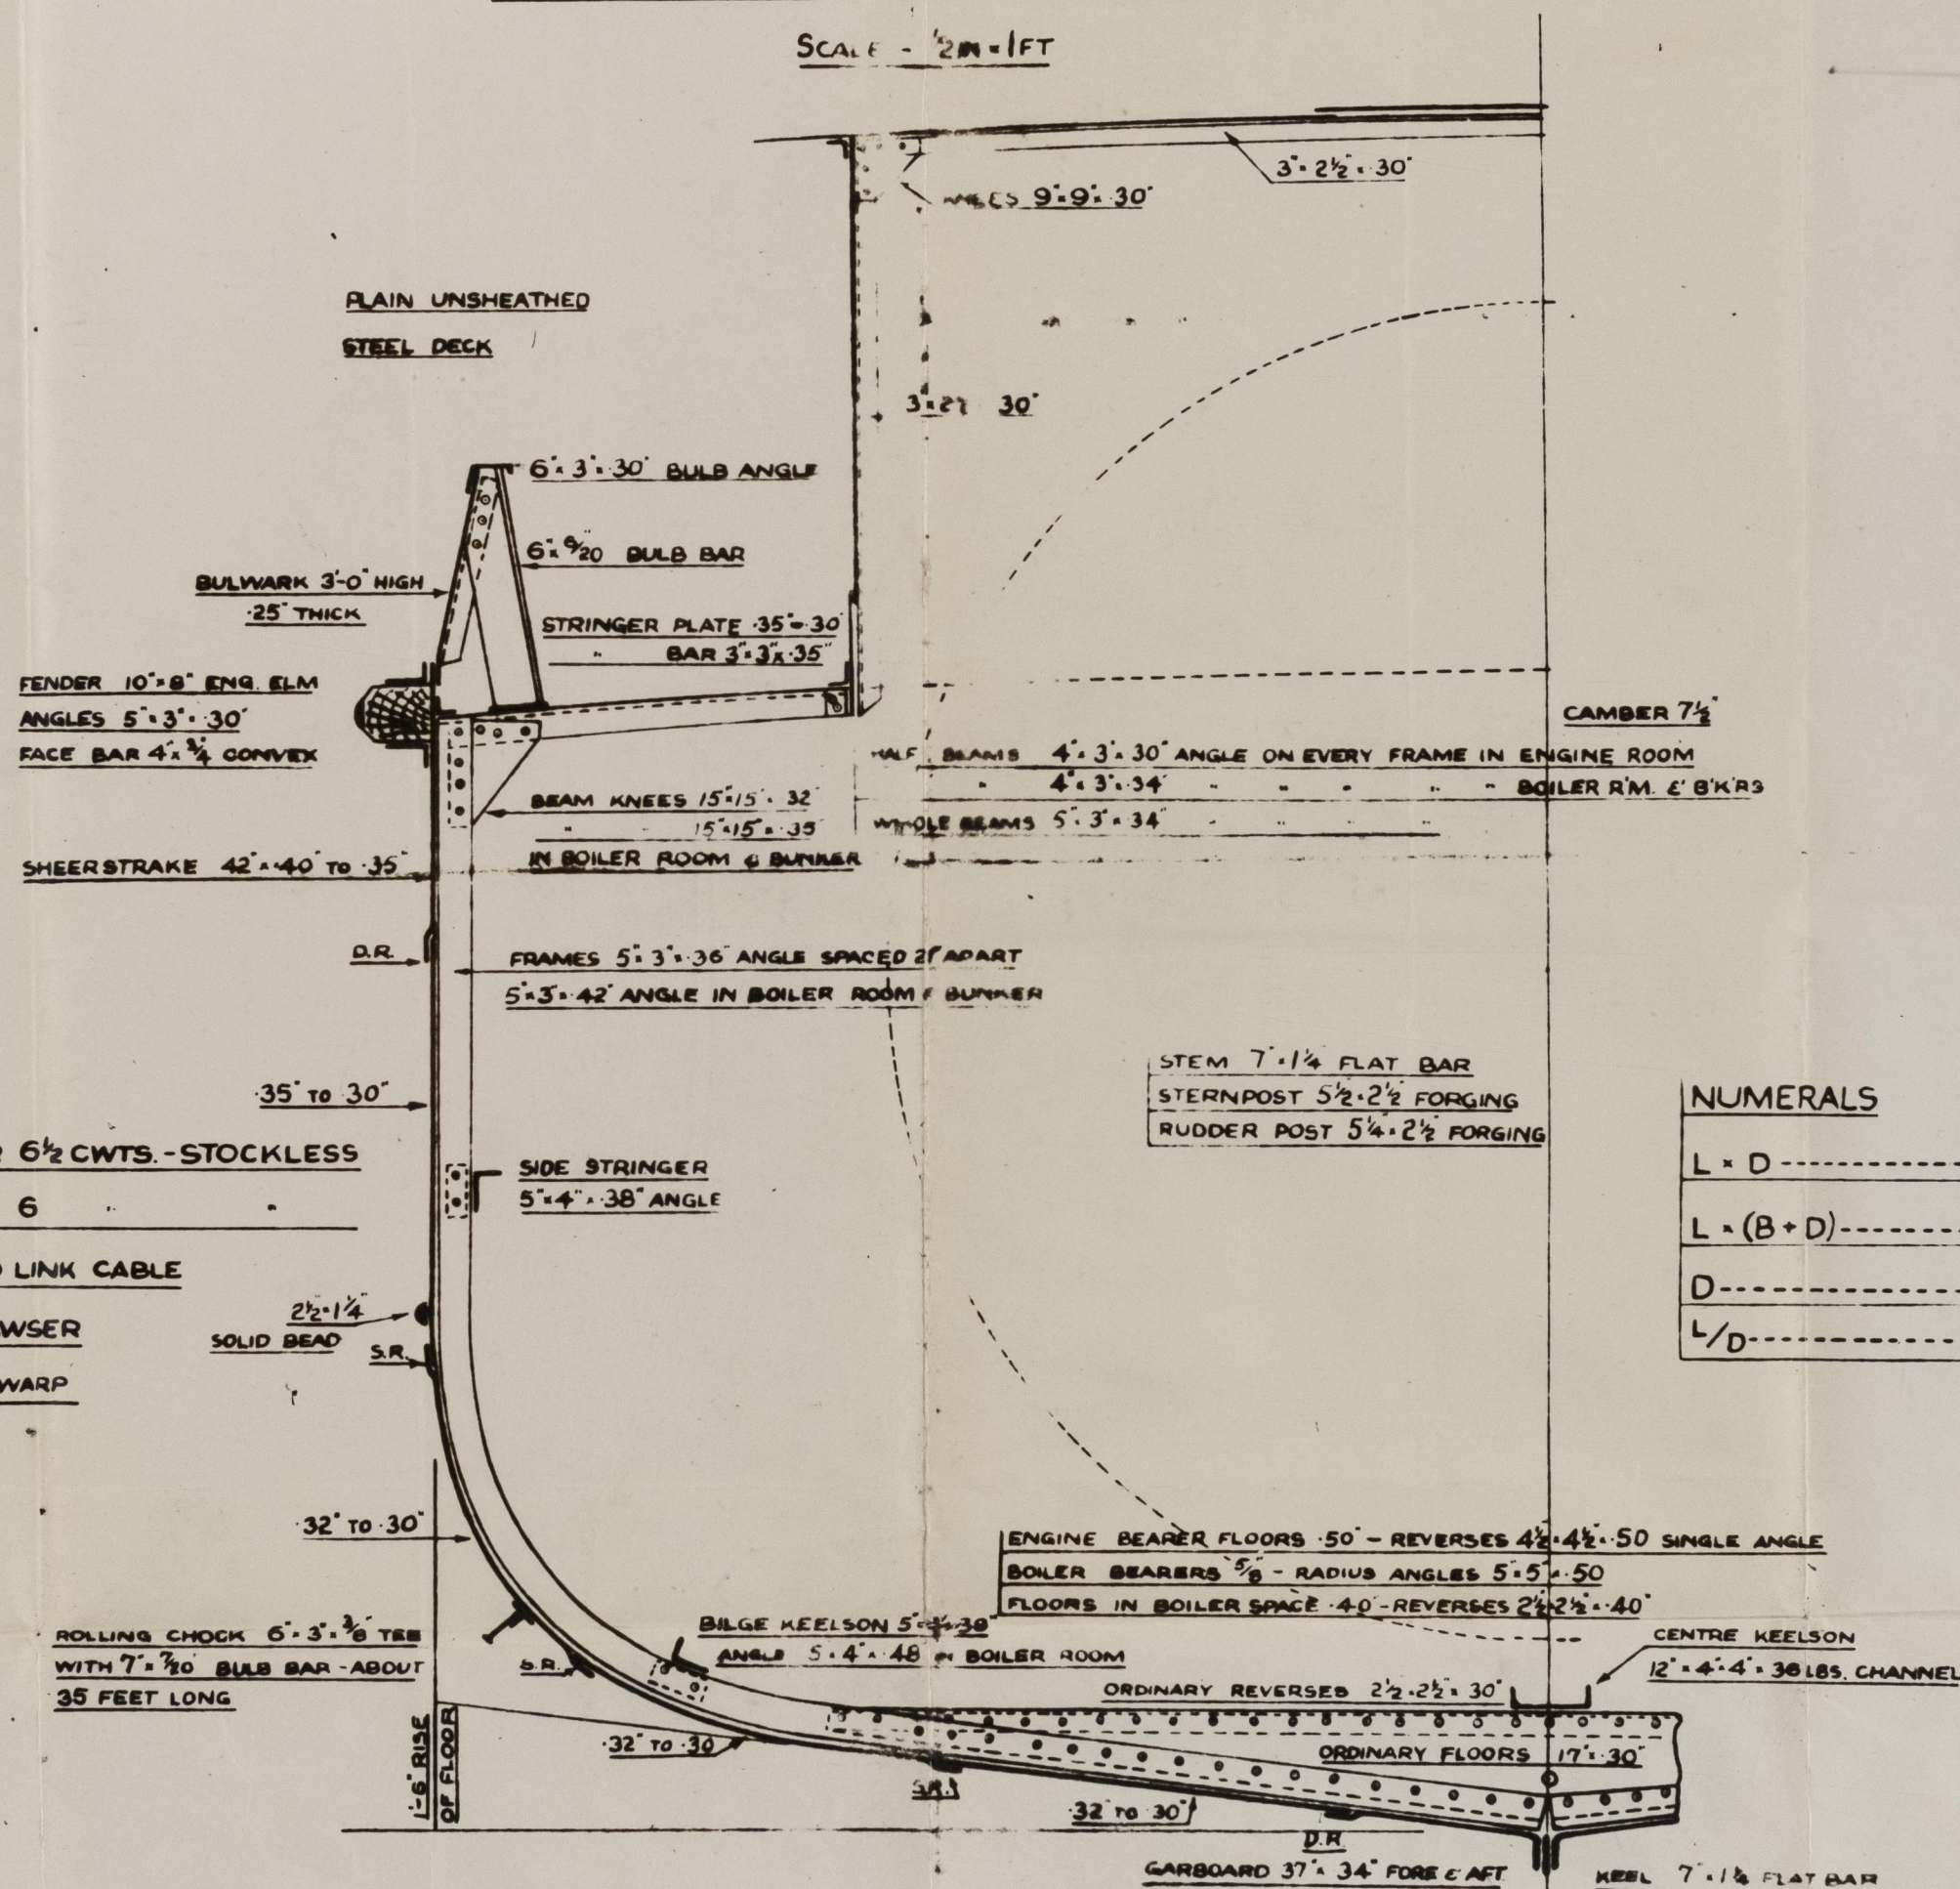

EQUIPMENT

1ST. BOWER ANCHOR 6½ CWTs. - STOCKLESS

2ND " " 6 " "

150 FMS. 1" DIA. STUD LINK CABLE

60 FMS. 6" HEMP HAWSER

60 F.MS. 4 1/2 HEMP WARP

NUMERALS

L x D ----- 1365

$$L \times (B + D) \text{-----} 4147.5$$

D-----13

L/D-----8




Midship Section.

S/S FLYING METEOR. ex EMPIRE DENIS.

Plan Line Repair

10.1.48.

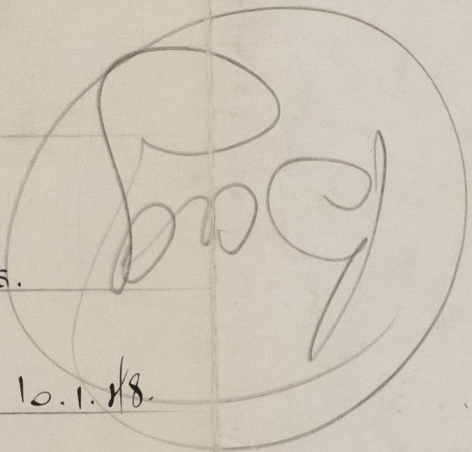

70 JAN 1948

Midship Section
S/S Flying Meteor

015292-015301-0047

