

LLOYD'S REGISTER OF SHIPPING


UNITED WITH THE BRITISH CORPORATION REGISTER

6 OCT 1952

Ship's Name M.V. "SUNNY PRINCE" (EX-"TIJUCA") Official No.

Memorandum of alterations reported since ship was surveyed for assignment of Load Lines in H A M B U R G

SKETCH SHOWING INCREASE IN LENGTH OF POOP FOR FREEBOARD IN THE EVENT OF TONNAGE OPENING BEING CLOSED.

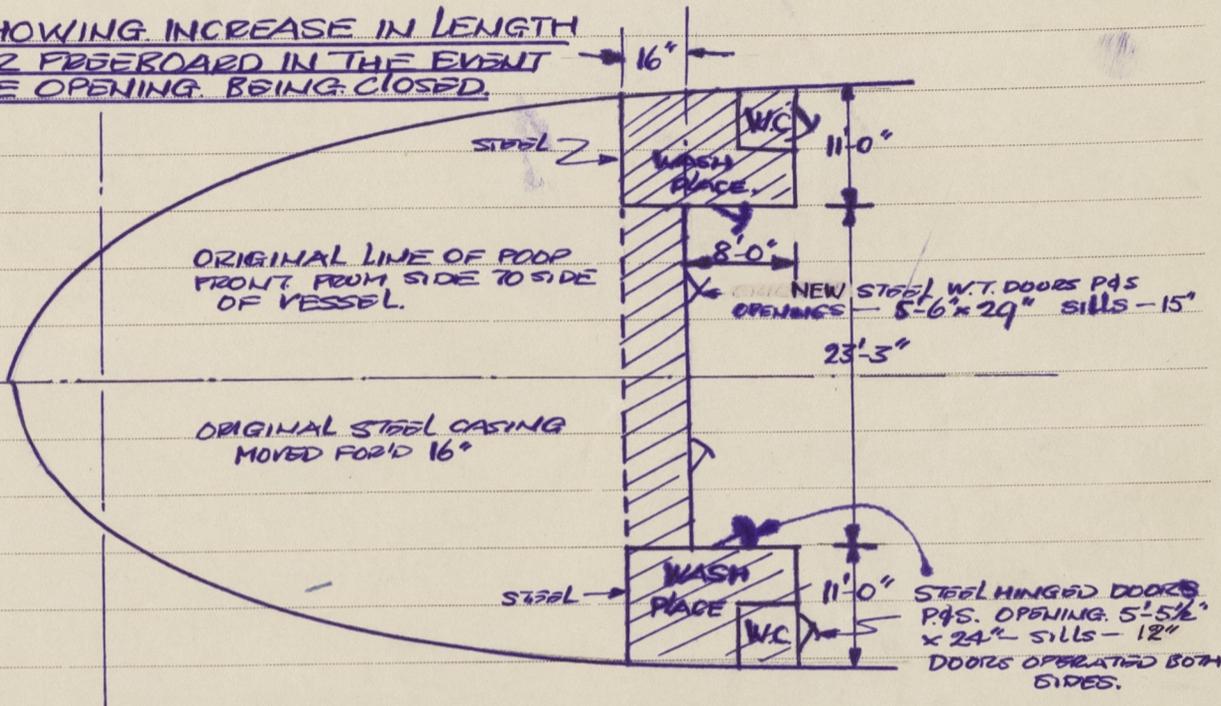

ACCOMMODATION ALTERATIONS:

The after and amidship accommodation spaces have been altered and extended this time. For the alterations to the amidship accommodation, only the wood partitions have been amended but the poop accommodation has been extended by moving the existing poop front 16" further forward and arranging new wing extensions (see sketch above).

Eight new ventilators have been fitted on the poop deck (4 P 4 S) for the ventilation of the new accommodation spaces ; 9" diam. ventilators with coamings 21" high x . 35. Wood plugs and canvas covers have been supplied for the new ventilators.

24-9-52
 Lloyd's Register
 Hamburg
 of Shipping

W. J. G.

22 OCT 1952



© 2021

Lloyd's Register Foundation

015338-015347-0177