

17.6.15
4.11.15

PROFILE AND DECK PLAN

N° 712

DIMENSIONS 135 OBP x 23 GEX x 13-1 MOULDED
SCALE 1/4 INCH

PLAN No. 5699


FOR ENCLOSURE TO

Meach Lloyds

FR

DATE: 15/6/15

11/1/19

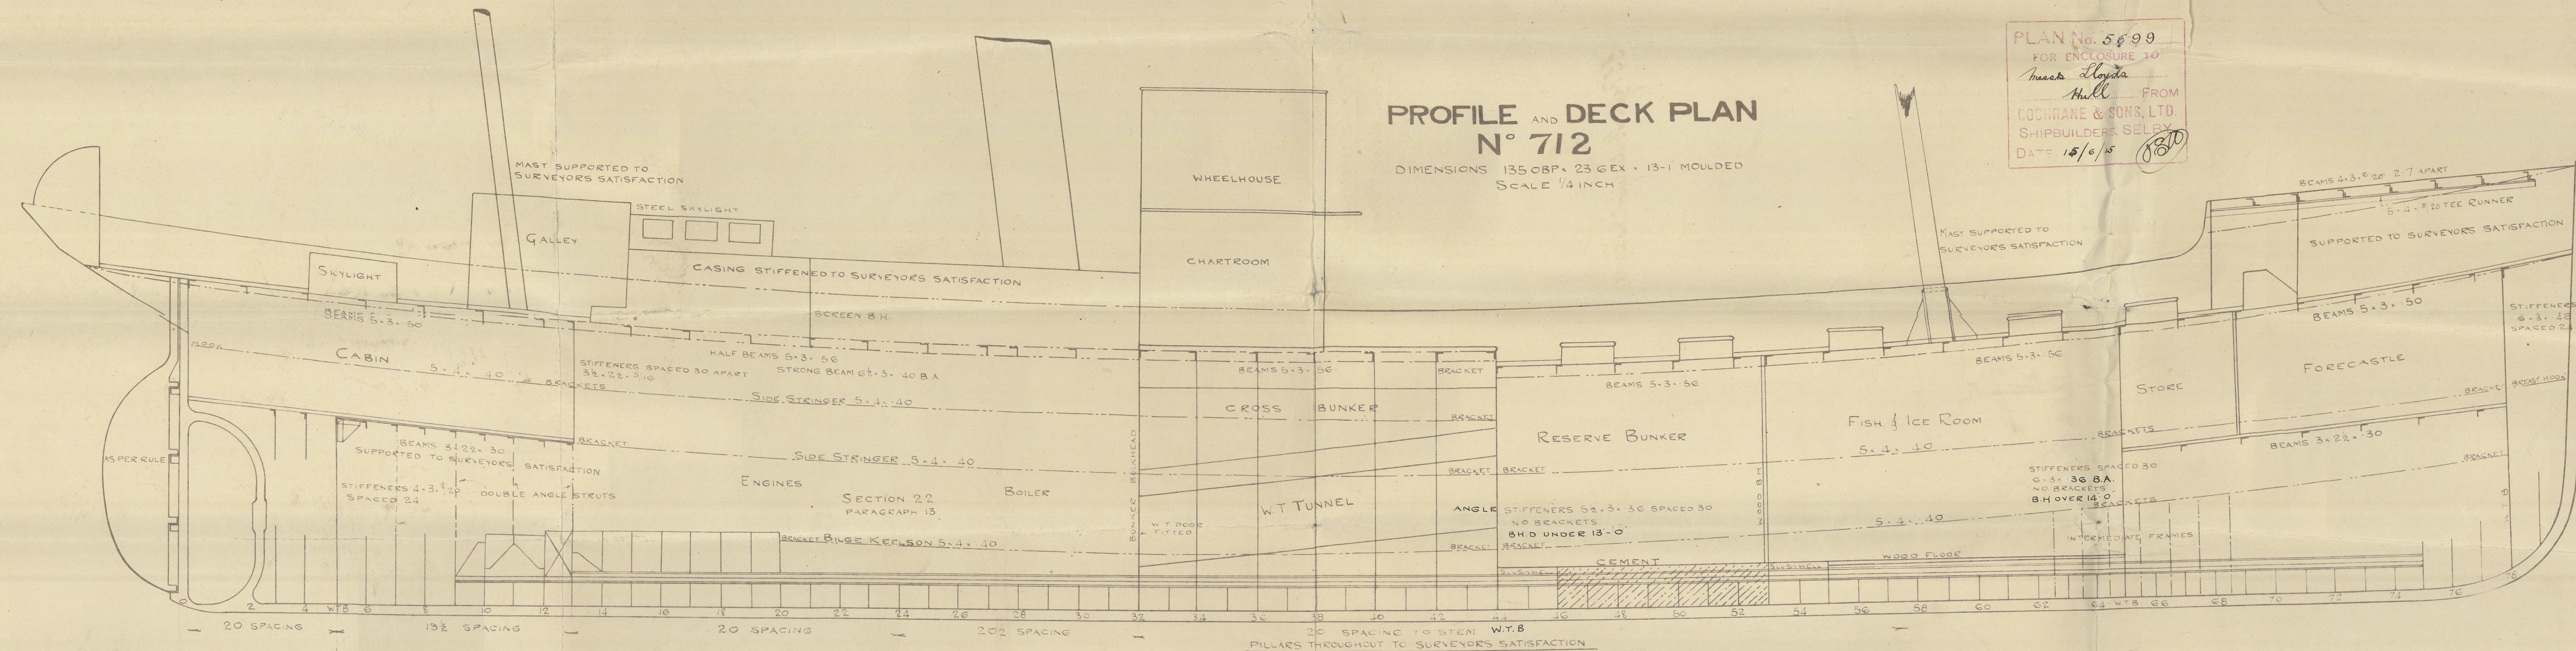

ccf
17.6.15

PROFILE & DECK PLAN
COCHRANE & SONS LTD
No. 712



Norland
Ex



"S.S. Prefect" Hull Report No. 29108.

© 2021

Lloyd's Register
015338-015347-0275
Foundation