

17.6.15
4.11.15

MIDSHIP SECTION

STEEL SCREW TRAWLER

Nº 712


135.0 B.P. * 23.6 EX. * 13.1 MOULDED

1/2" SCALE

TO CLASS 100 A.I.

DECK PLATED OVER IN WAY OF MACHINERY
ENGINE AND BOILER CASING AS PREVIOUSLY APPROVED

PLAN No. 5698
FOR ENCLOSURE TO
Heath, Lloyd
Hull FROM
COCHRANE & SONS, LTD
SHIPBUILDERS, SELBY
DATE 15/6/15 *JSW*

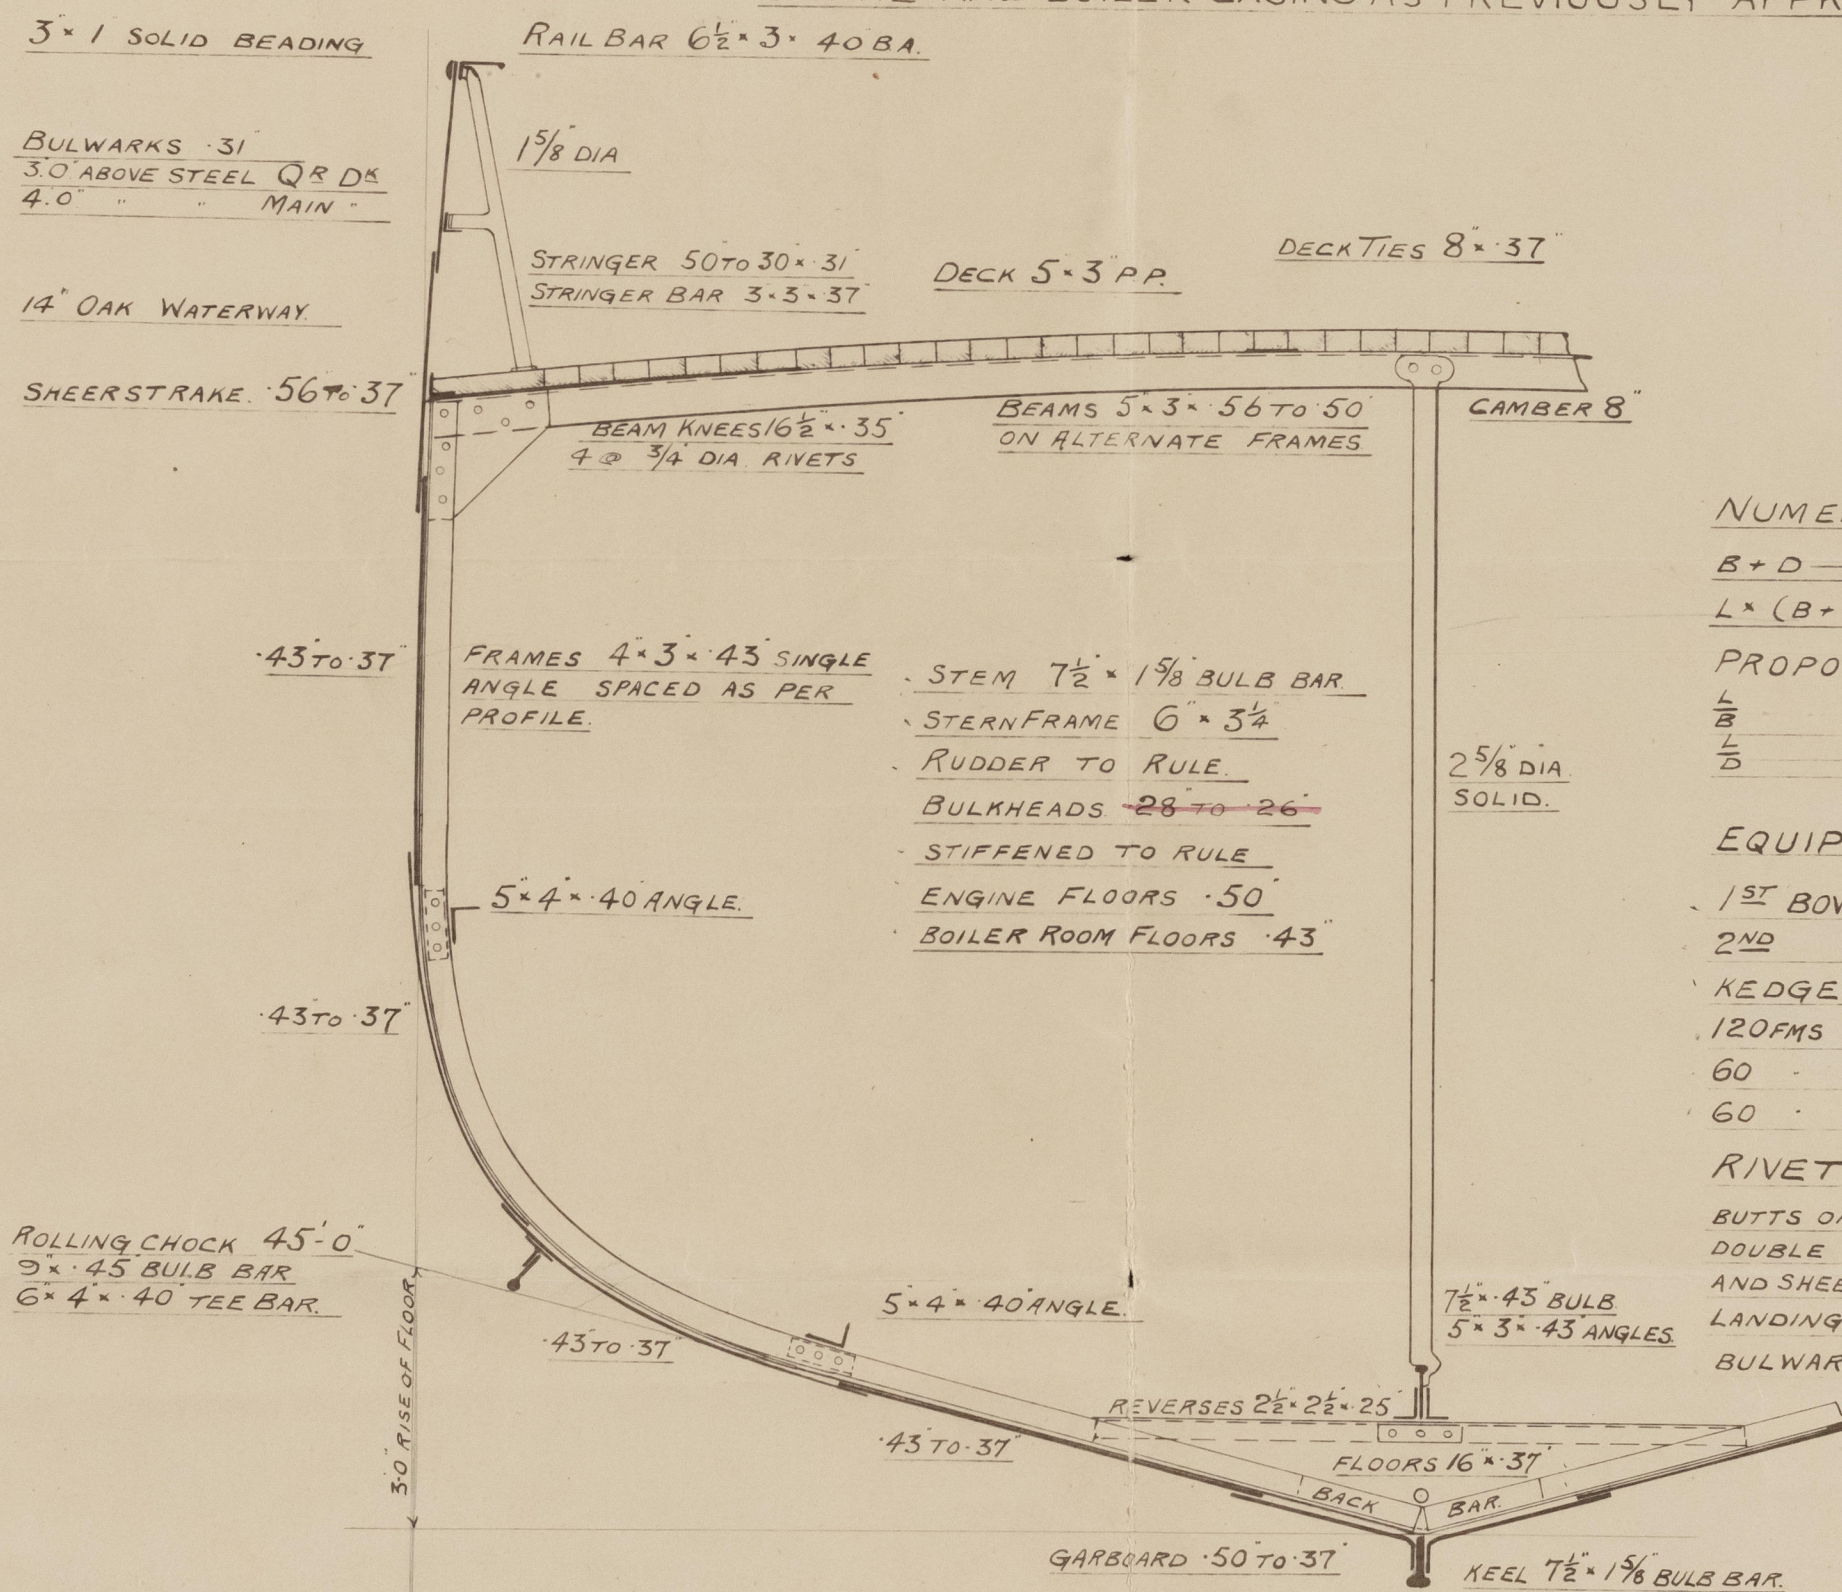

NUMERALS

B + D ——— 36.45

L * (B + D) — 4920.75

PROPORTIONS

L/B ——— 5.77

L/D ——— 10.32

EQUIPMENT

1ST BOWER 7 1/2 CWTs STOCKLESS

2ND " 7 " "

KEDGE 3 " EX STOCK

120 FMS 1 1/8" STUD LINK CABLE

60 - 6" HAWSER

60 - 5" WARP

RIVETTING

BUTTS OF SHELL PLATES LAPPED AND
DOUBLE RIVETTED EXCEPT GARBOARD
AND SHEERSTRAKE WHICH ARE STRAPPED
LANDINGS DOUBLE RIVETTED EXCEPT
BULWARKS WHICH ARE SINGLE.

CCP
17.6.15.






© 2021

Lloyd's Register
Foundation

015338-015347-0216


MIDSHIP SECTION
COCHRANE & SONS LTD

No. 712

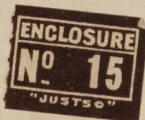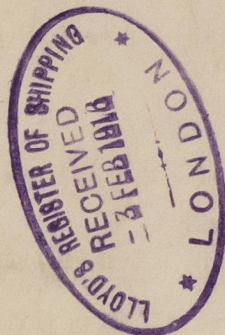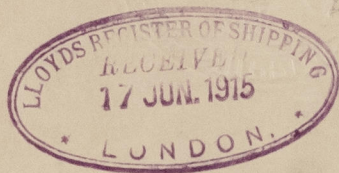

"Norland"

Box

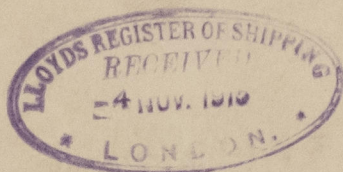

S.S. Prefect. Hull Report No. 29/08.

015338 - 015347 - 0276



© 2021

Lloyd's Register
Foundation