
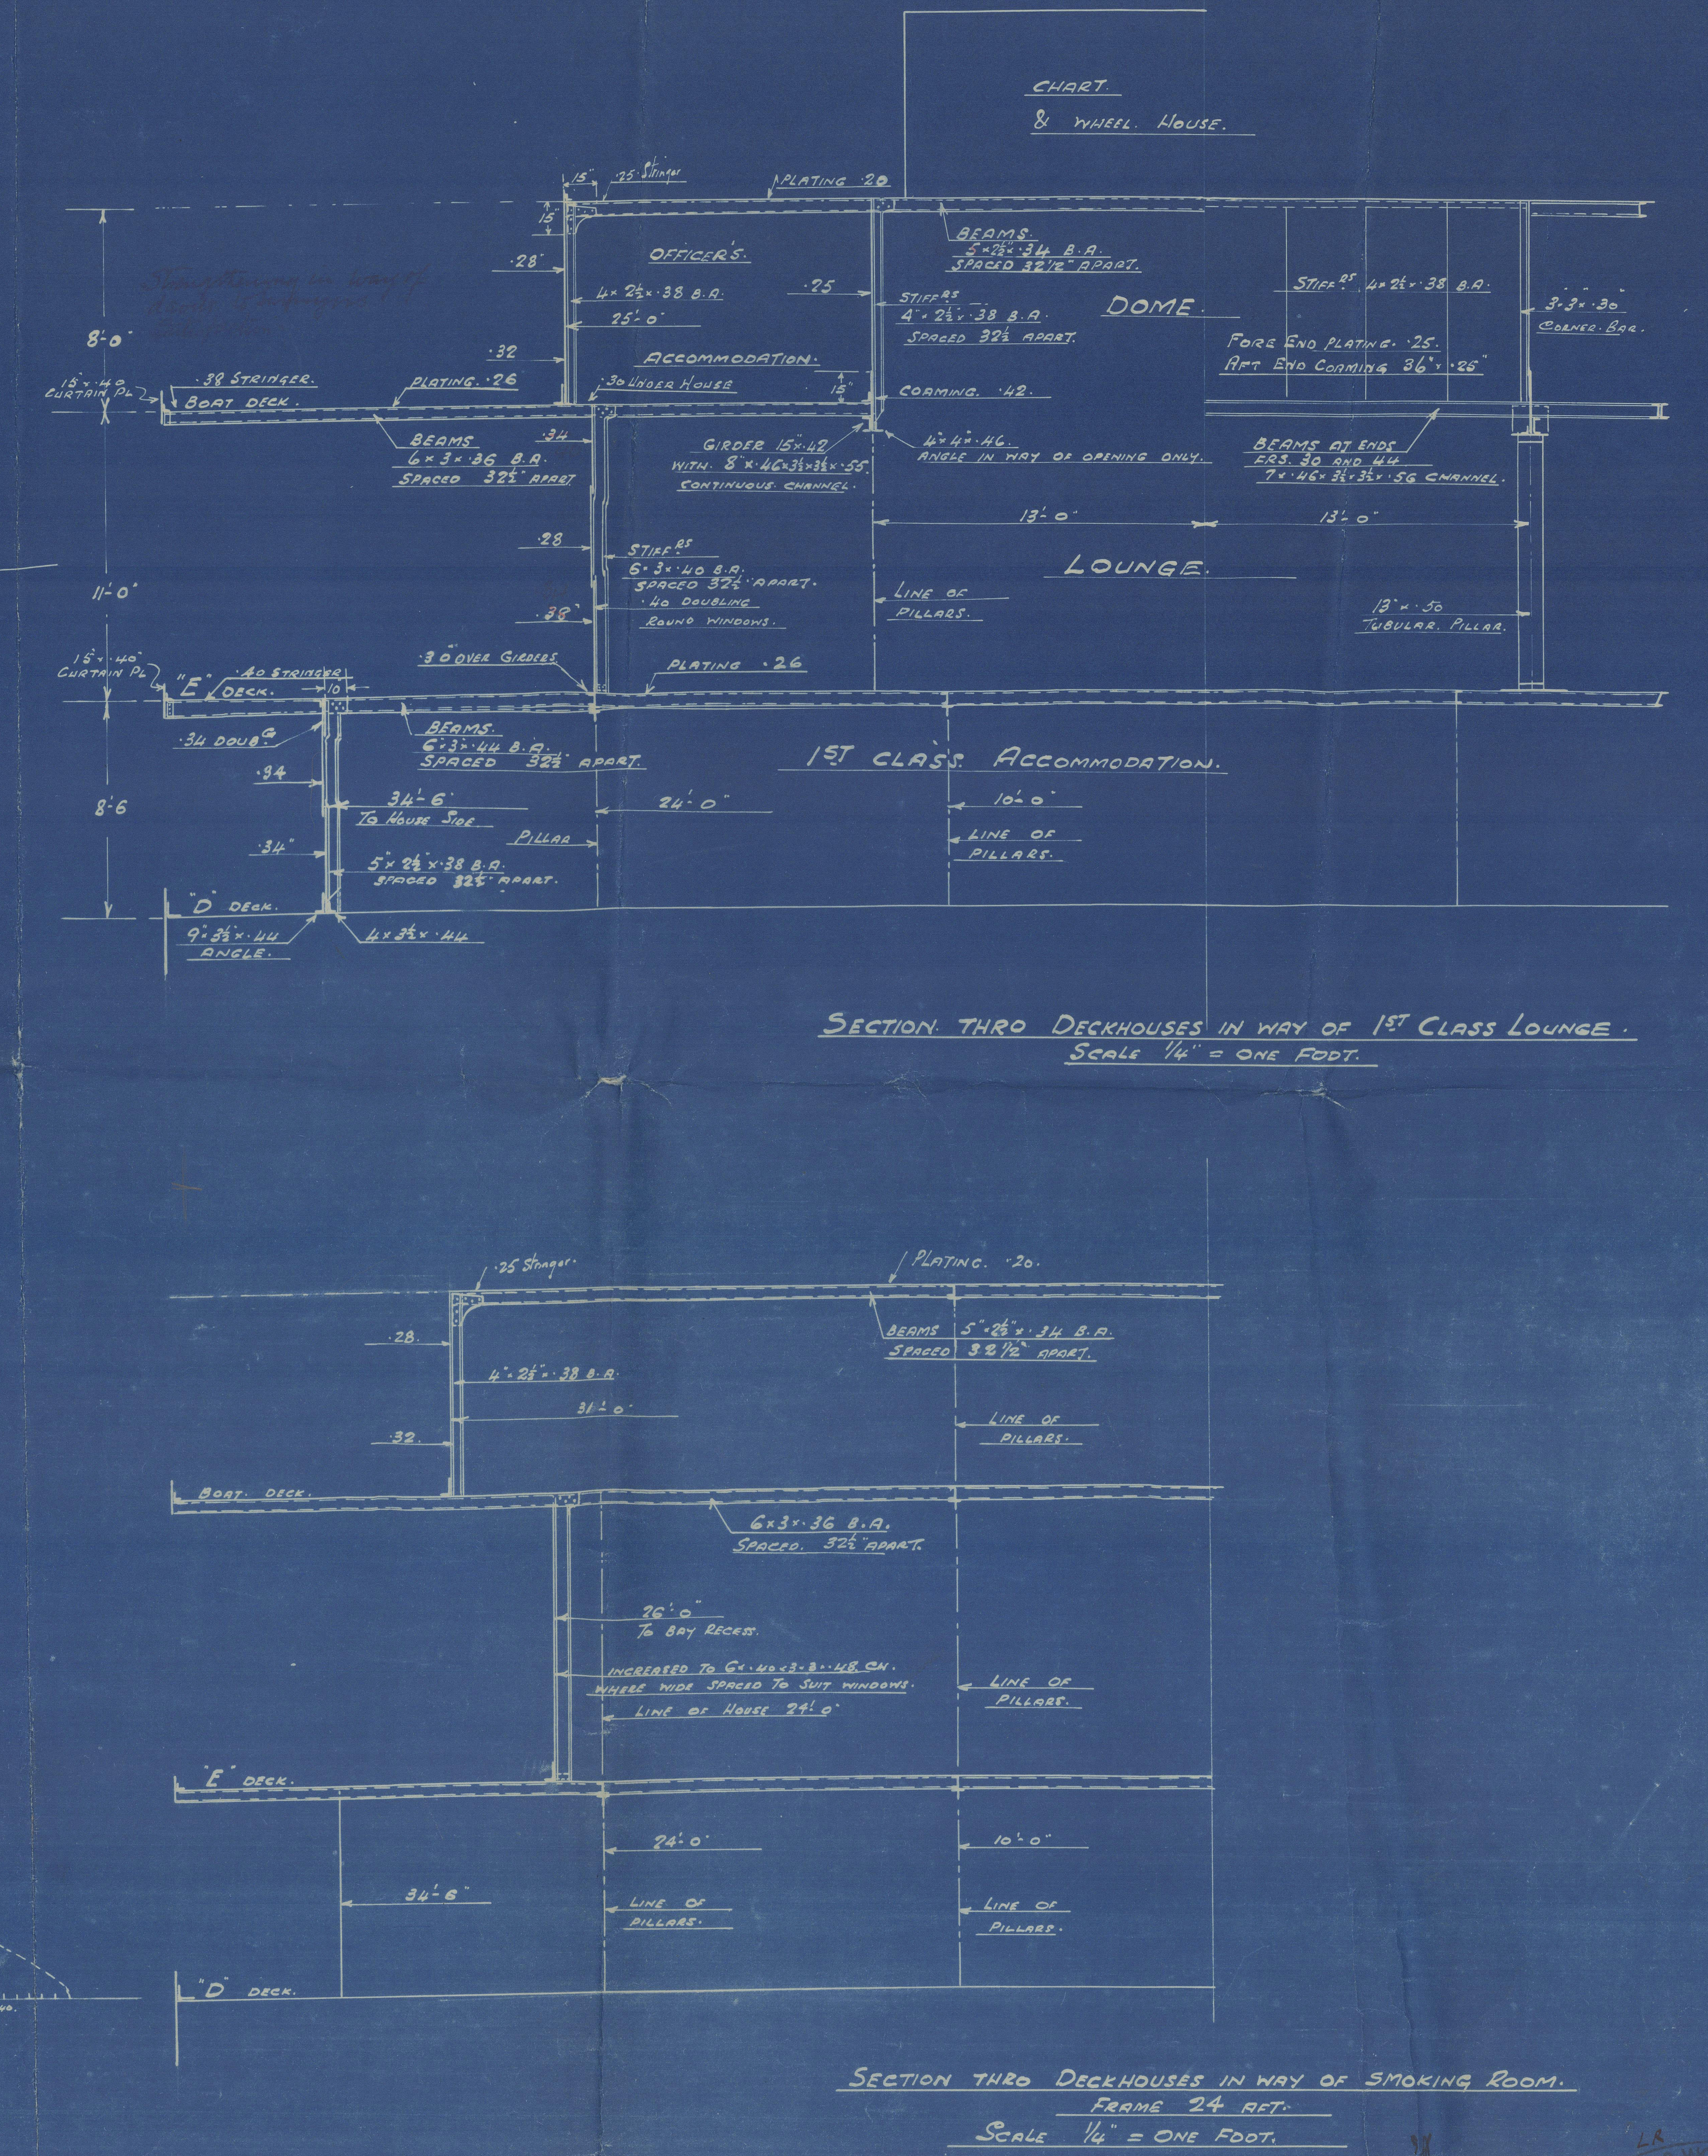


Nos 941-2
 PLAN OF "E" & BOAT DECKS & DECKHOUSES.
 SCALE $\frac{1}{16}$ " = ONE FOOT.
 SECTIONS $\frac{1}{4}$ " = ONE FOOT.

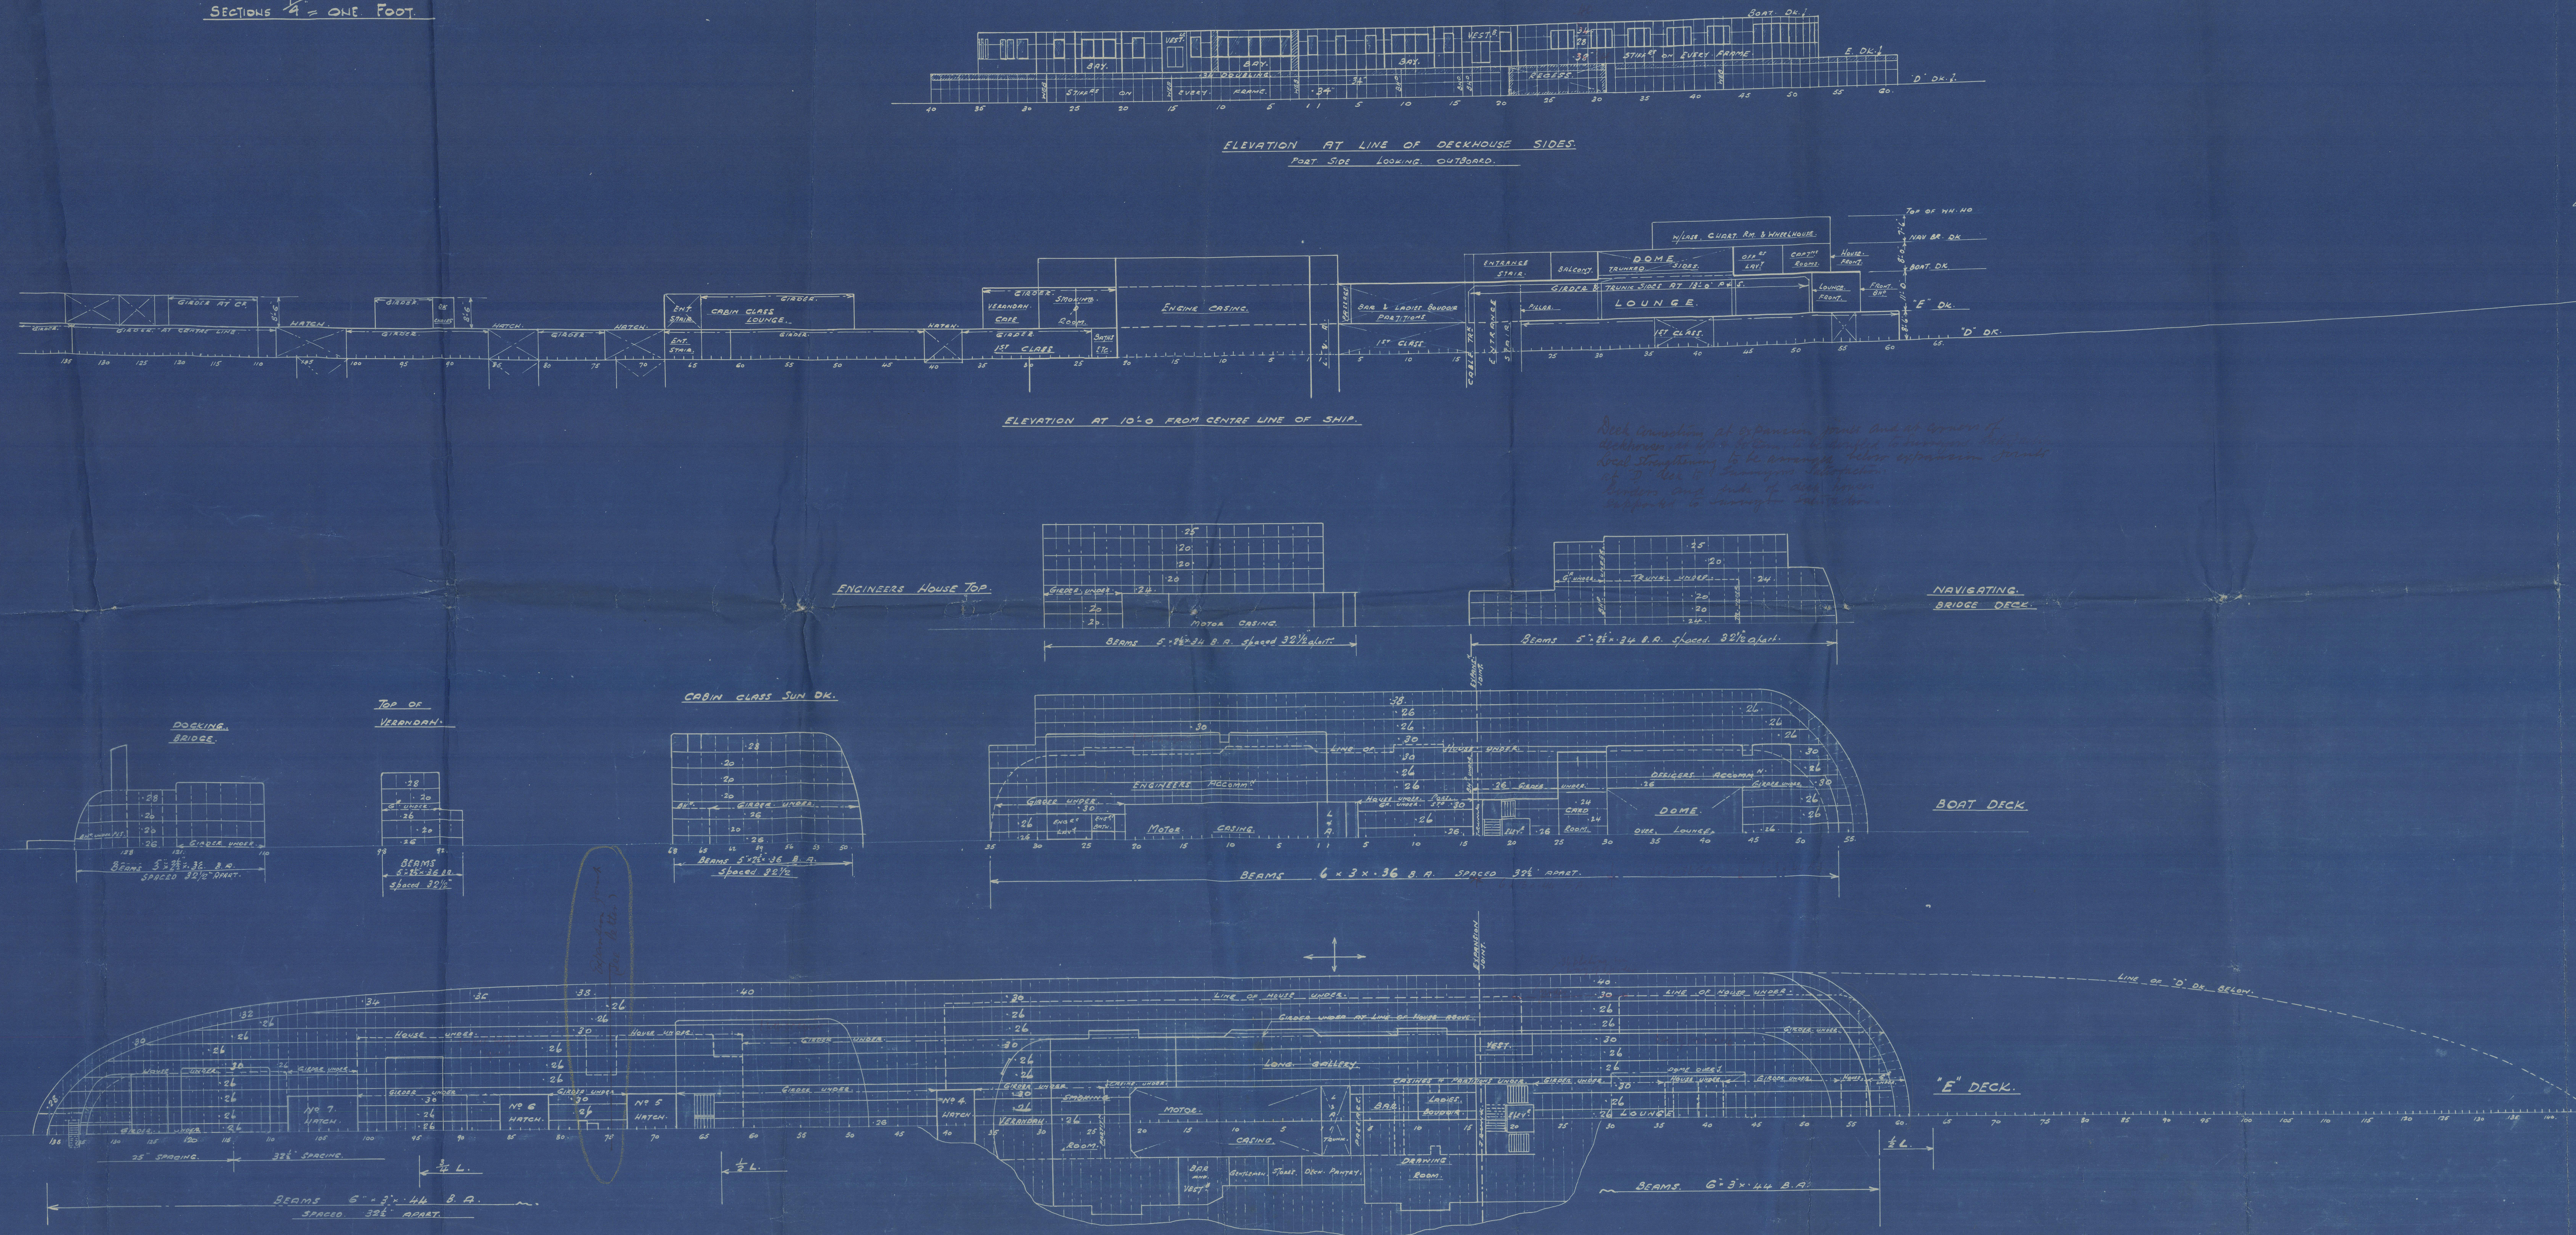

Harland & Wolff

N^o 941/2

Plan of "E" & Boat Dks & Deck Houses.

(27)

250

STIRLING CASTLE
ATHLONE CASTLE

Up Structures

PLANS TRANSFERRED
TO SISTER VESSEL

CAPETOWN CASTLE

BOX NO

2

PLAN NO

22

015348 - 015354 - 0004



© 2021

Lloyd's Register
Foundry