№ 986. ELEVATION SHOWING W.T. BULKHEAD SCANTLINGS.

ALSO FIRE RESISTING BULKHEADS

SCALE ⅛" = ONE FOOT

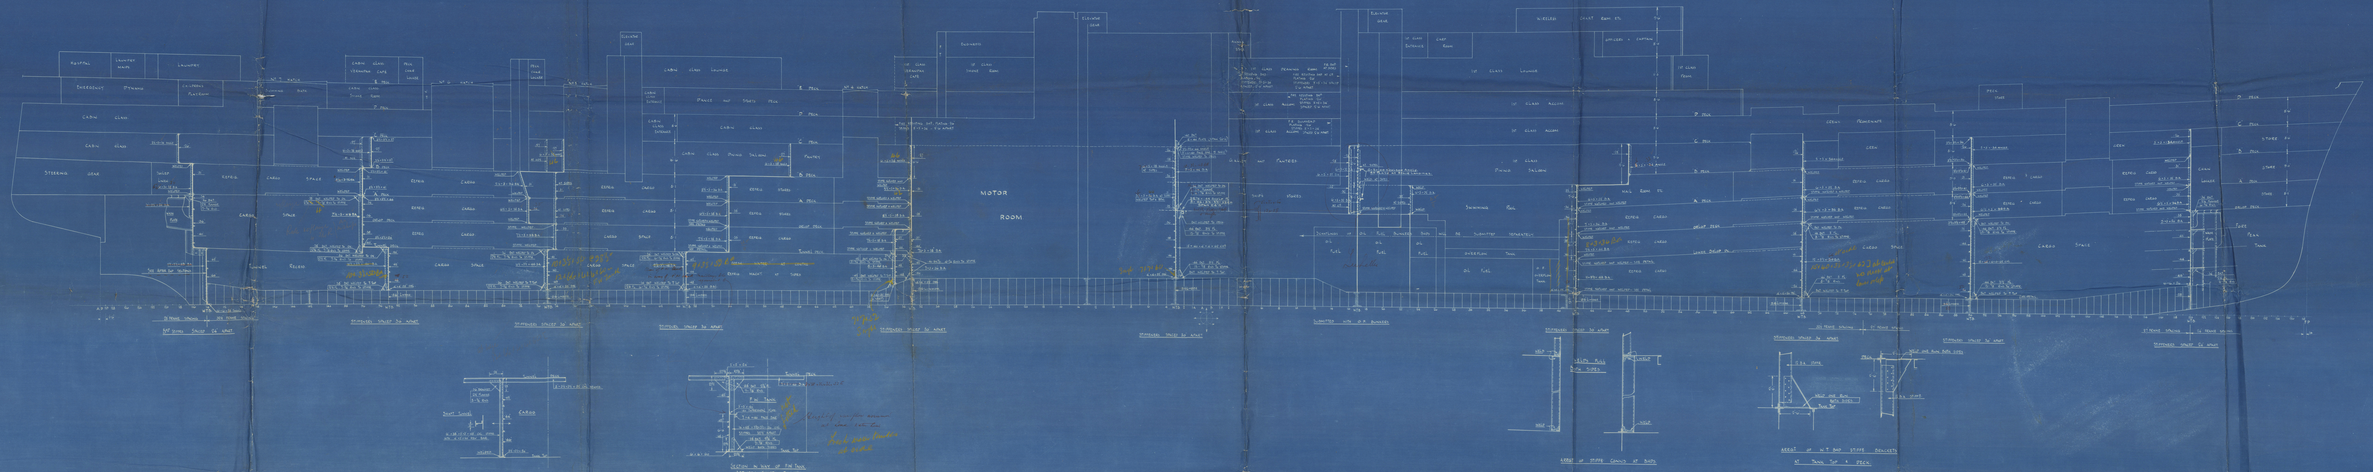

HARLAND & WOLFF LTD.
BELFAST

No. 986 Capetown Castle

TITLE. Elevation for W.T. BH.

11

See also 11A + 11B.

Rpt No 19198

© 2021
Lloyd's Register
Foundation

015348-015354-0009