

CAPE TOWN CASTLE

No. 986.


BALLAST TANK SECTIONS

SCALE 1/4" = 1 FOOT

CODE No. 101

LIST OF INTERCOSTAL PLATES FORWARD OF FRAME 15 FORD

MARK	NO.	LEN.	B. TANK	LOCATION
1	36	4'-3"	52	FR 13-63 10'-0" FRI
2	10	4'-0"	52	39-64 17'-0"
3	1	3'-2"	52	64-65
4	04	3'-8"	52	15-47 25'-0"
5	24	2'-7"	52	63-75 3'-6"
6	24	2'-3"	52	75-107
7	22	4'-3"	52	75-107 7'-0"
8	24	4'-3"	52	63-75
9	12	2'-3"	52	86-92
10	18	2'-7"	52	63-75 10'-6"
11	18	2'-3"	52	75-84
12	10	4'-1"	52	63-71 12'-0"
13	03	2'-7"	52	71-75
14	2	2'-2"	52	75-79

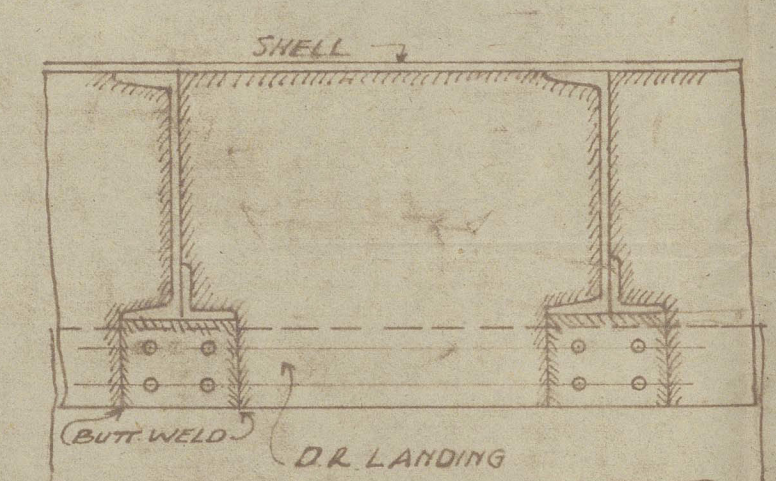

POSITION	ANET	PITCH	QWS	REMARKS
VERT. ANGLES TO CEILING	1	210	5	SEE DETAIL OF ANG. PLAT
CEILING VERTICALS TO FLOORS	7/8	438	5	UNDER ENGINES
TANK FRAMES TO SHELL 325 SPACING	1	638	7	AT OT OR WT DIVISIONS
TO FLOORS	7/8	638	7	FORWARD OF 15 LENGTH
REVERSE FRAMES TO FLOORS	1	638	7	AT OT OR WT DIVISIONS
TANK TOP	1	638	7	IN ENGINE ROOMS
TO FLOORS	1	638	7	AT OT OR WT DIVISIONS
INTERCOSTAL VERTICAL ANGLES	7/8	638	7	SEE DETAIL
STIFFENERS TO FLOORS	1	638	7	UNDER ENGINES
FLOORS TO MARIN PLATE	1	638	7	OUTWARD OF ENGINES
CONTINUOUS GIRDER TO SHELL	1	638	7	AT OT OR WT DIVISIONS
TANK TOP LANDING 325 SPACING 8" PER 1/8" RYS PER SPACE	1	638	7	SEE DETAIL
BUTTS	1	638	7	WHERE SHIP ANGLE OT OR WT


MARGIN PLATE BUTTS 12" AND 42" 75 RIVETS SPACED 36" APART



"Capetown Castle"

Plan received from Belfast showing
cracking of frames at inner bottom
forward

Aug 1946

RPT NO Bel 14313



© 2021

Lloyd's Register
Foundation

015348-015354-0036