


ELEVATION.

SCALE $\frac{1}{8}'' = 1 \text{ FT.}$

DIMS: 215'-0" B.P x 32'-0" x 14'-6" MLD

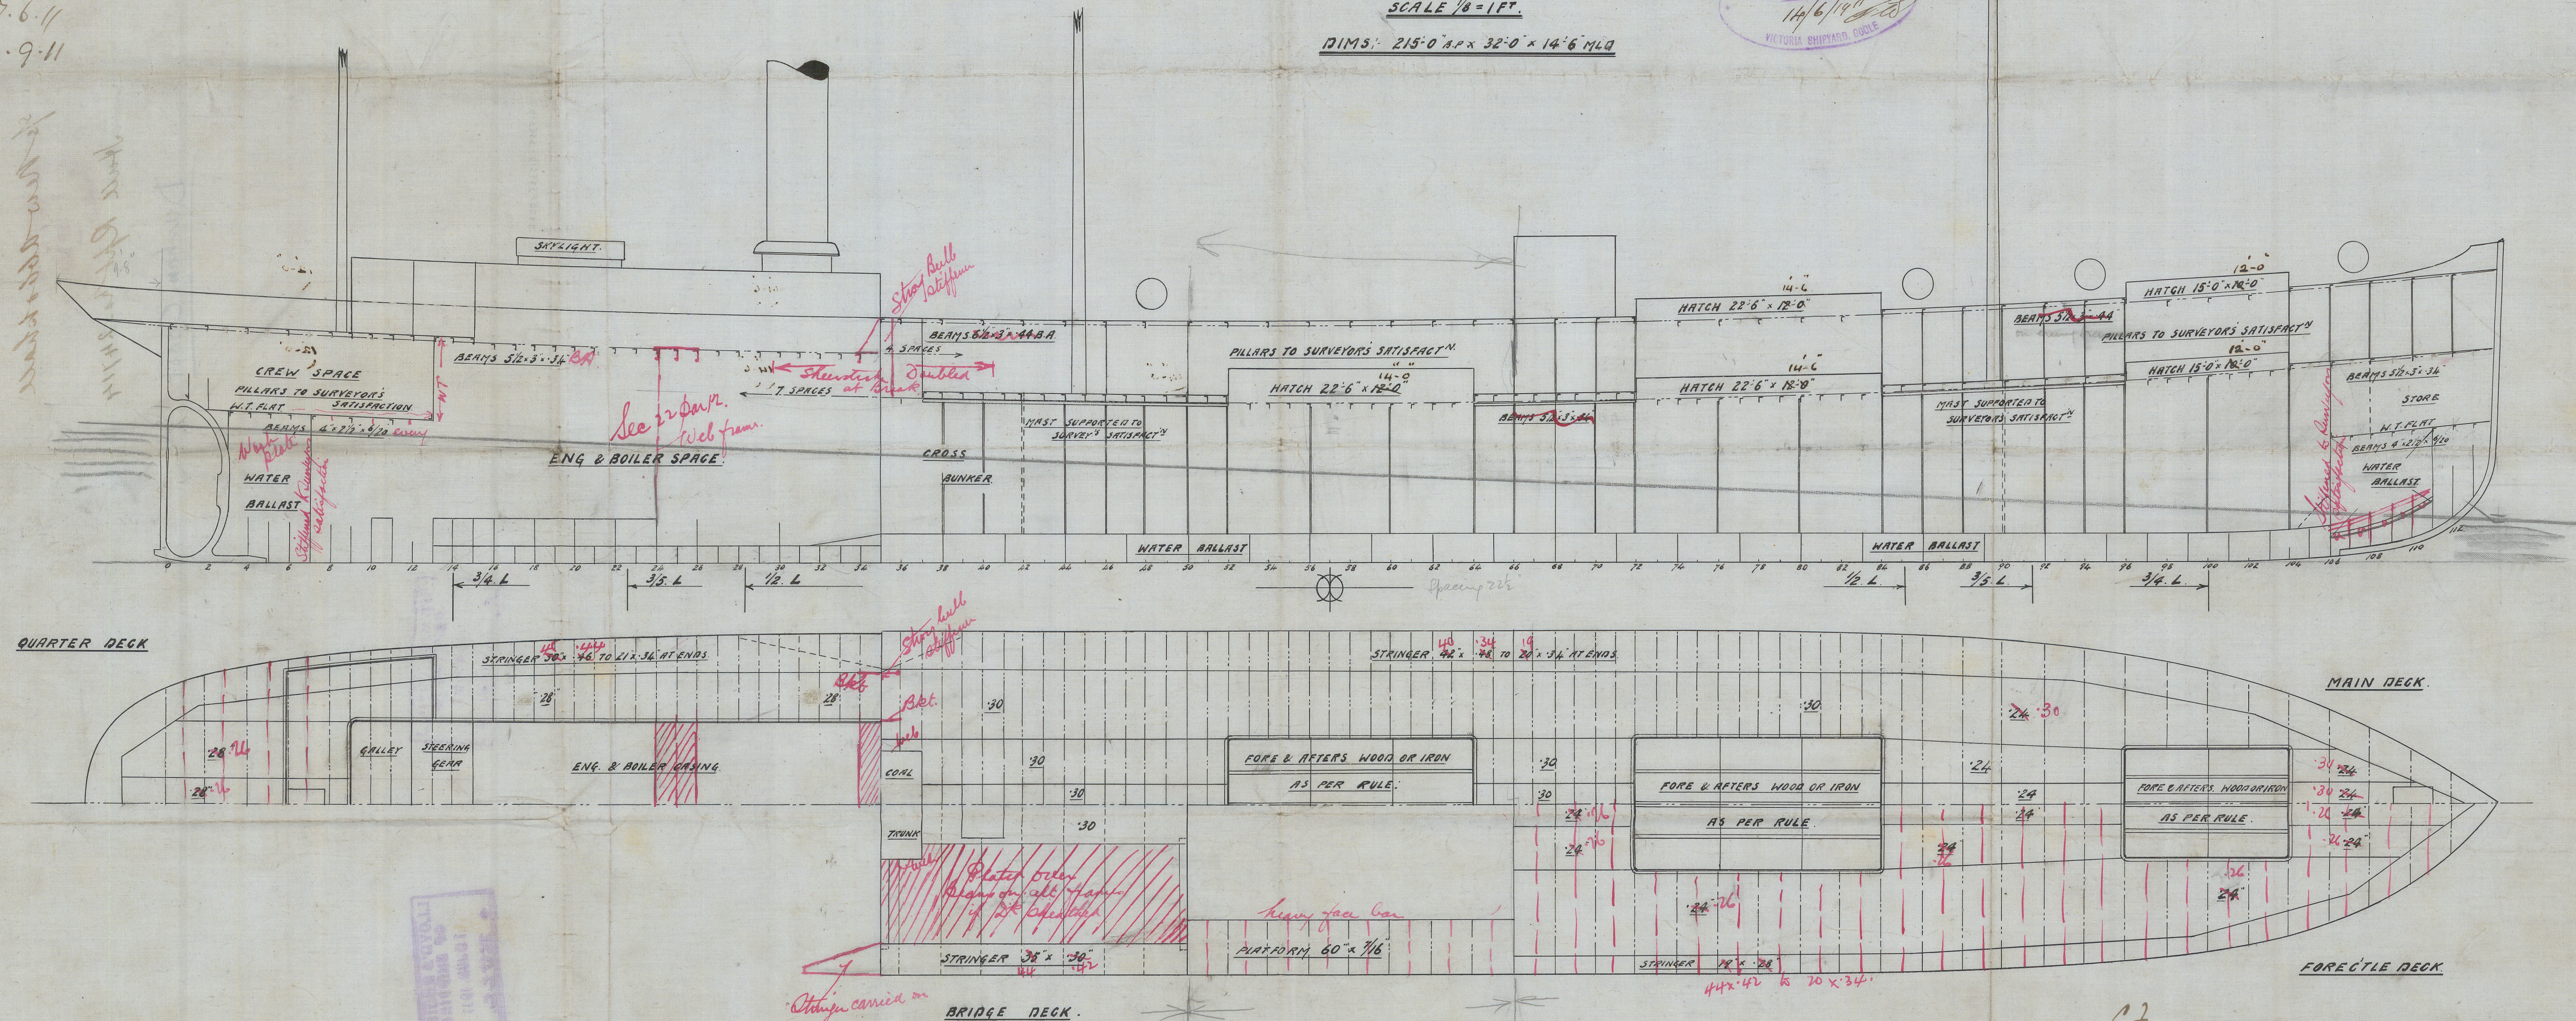

C. f.
17. 6. 11.

Goole S. & R. Co. Ltd


Profile & Deck
No 146.

for New Abbotshall

Stall Rpt no. 24714

Durham Coast

015355-015365-0066

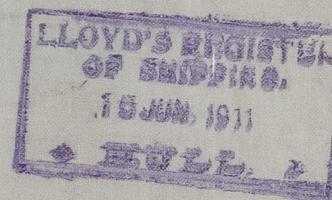

© 2021

Lloyd's Register
Foundation