

MIDSHIP SECTION S.S. No. 161

DIMENSIONS.

LENGTH INSIDE STEM & STERNPOST	248.0
BREADTH MOULDED	38.0
DEPTH	17.6
DEPTH OF HOLD [245 FLOORS SUPPORTS]	16.8
HEIGHT OF RIGGED QUARTER DECK	9.0
OF POPE 7.0. HEIGHT OF BRIGGS 5.0. HEIGHT OF MAIN 5.0.	
<u>SCALE 2 IN = 1 FOOT.</u>	

CLASS: BRITISH CORPORATION B.S.*
MATERIAL: STEEL
TYPE: SHORT POOP AFT QUARTERDECK BRIDGE FORECASTLE
DRAFT: 16'-9 1/2" SPEED: 9 KNOTS
ALL THICKNESSES IN 50 ^{TNS}

PLANS TO BE SUBMITTED.

PLAN OF STEEL

— - STEERN & PROPELLER POST

— - RUDDER.

— - ICE STRENGTHENING OF THE BOW.



OUTSIDE PLATING SEAMS ALL LAPPED - 2 IN. ✓
5 $\frac{1}{2}$ LAPS $\frac{3}{8}$ INETS SPACED 3 $\frac{1}{2}$ " C.T.O.C. ✓
4 $\frac{1}{2}$ " - $\frac{1}{4}$ " - 2 $\frac{1}{2}$ " - 3" - ✓
BULKHEAD SEAMS LAPPED 1 IN. 2 $\frac{1}{2}$ LAP $\frac{1}{8}$ IN. SPACED 4 $\frac{1}{2}$ " C.T.O.C. ✓
FORECASTLE, POOP & DECK PLATING SEAMS LAPPED 1 IN. 2 $\frac{1}{2}$ LAP $\frac{1}{8}$ IN. 2 $\frac{1}{2}$ C.T.O.C. ✓

[illegible]

SECTION IN WAY OF QUARTER DK.

SECTION IN MACHINERY SPACE.



BEAMS		
	APPROX. IN CENTER OK.	BRIDGE OK.



SECTION IN WAY OF WELL.

HOLD PILLARS.
ONE PILLAR AT SIDE OF EACH HATCH.

FARMES SPREAD 25 BUT 17 FROM STEM TO 2 FARMES SPACES
 ABOUT COLLISION BULKHEAD.
 FARMES IN WAY OF MAIN DR 7'5" 28' FARMES 10' 11" 20' 25" X 12'
 FARMES IN WAY OF QUARTER ON 8'5" 26'5" IN PERKS 5'5" 18'5"
 ALL TO FORECASTLE MAIN BRIDGE QUARTER & POOL DKS. ✓

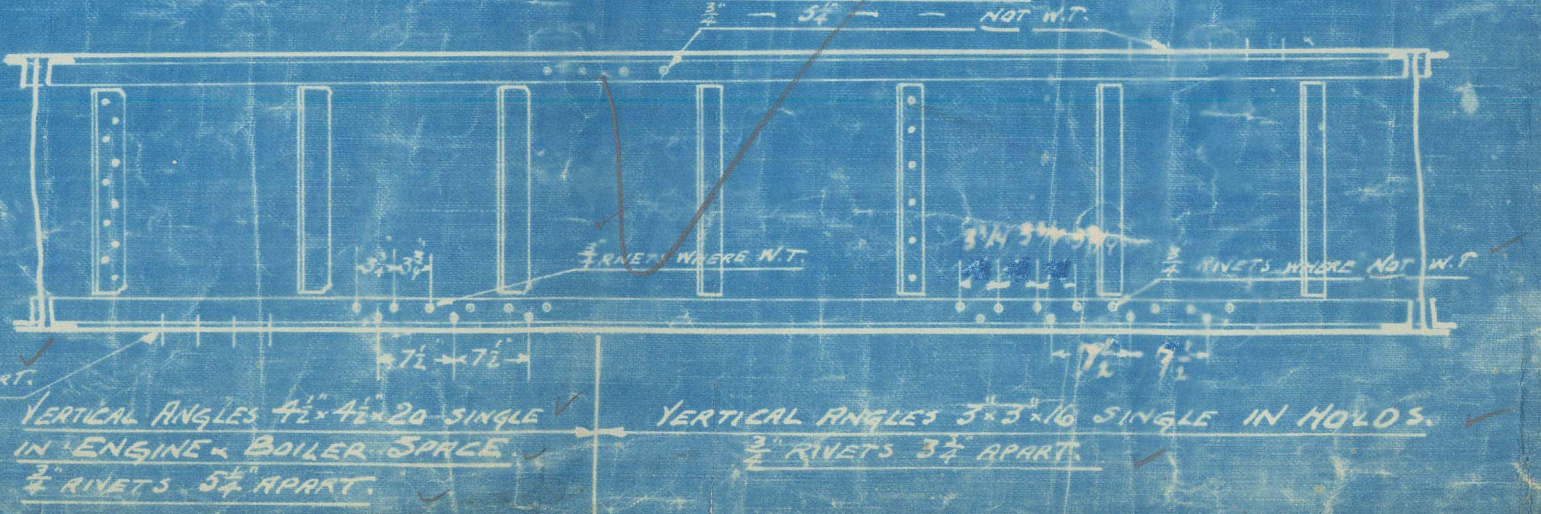[illegible]

SKETCH OF SIDE INTERCOSTALS.

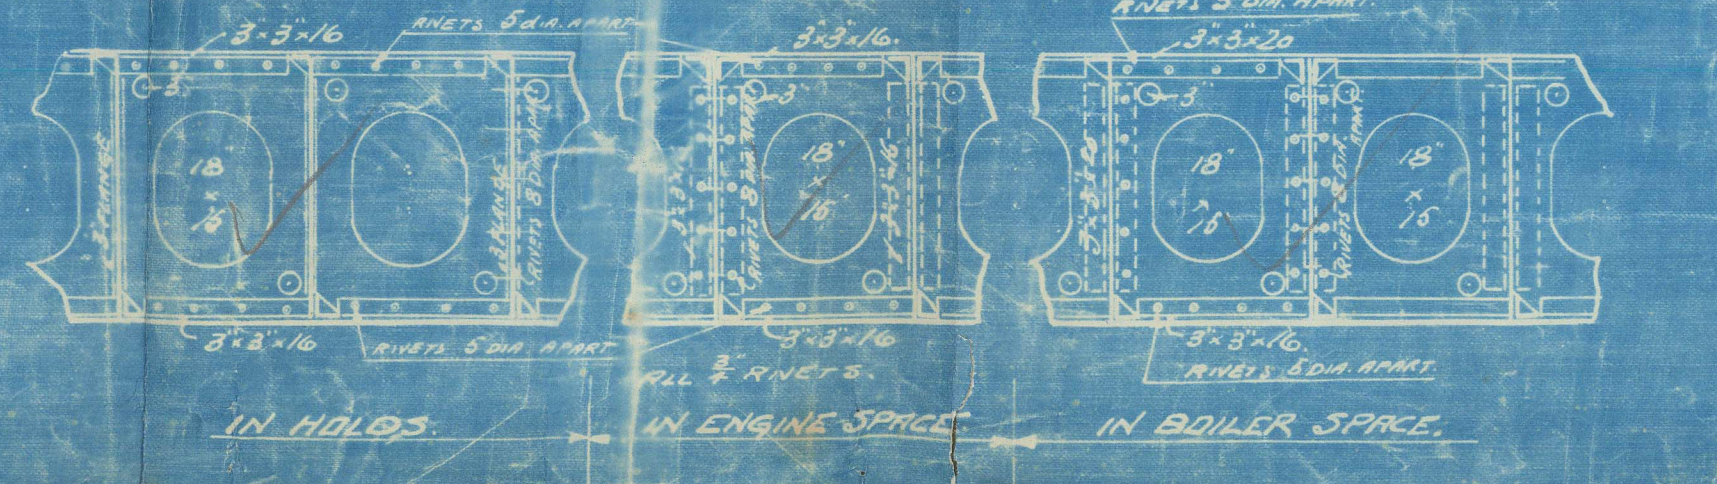

THE PLATES WHICH COVER THE STERN TUBE TO BE 3 THICKER THAN THEIR STARKES MIDSHIP.
ALL THE PLATES WHICH ARE RIVETED TO THE PROPELLER POST ABOVE/BELOW THE PROPELLER SHAFT ARE TO BE OF THE MIDSHIP THICKNESSES OF THEIR RESPECTIVE STARKES.

Helsingors

Midship Section
S S no 161

B.C. Lecky.

N.N. SISUKAS

015355-015365-0139

TC 27. 8 19

Elsmore's

161

Midship Section

7

3. 7. 19

© 2021

SS RODEFAKE
NOW CASTOR

David's Register
Foundation