


REPAIRS TO SHIPS
AND BOATS
BY THE
F. W. LEAKE & CO. LTD.

17 MAR 1948

*Shiffman
Lee Leake & Co. Ltd.
13-4-48*

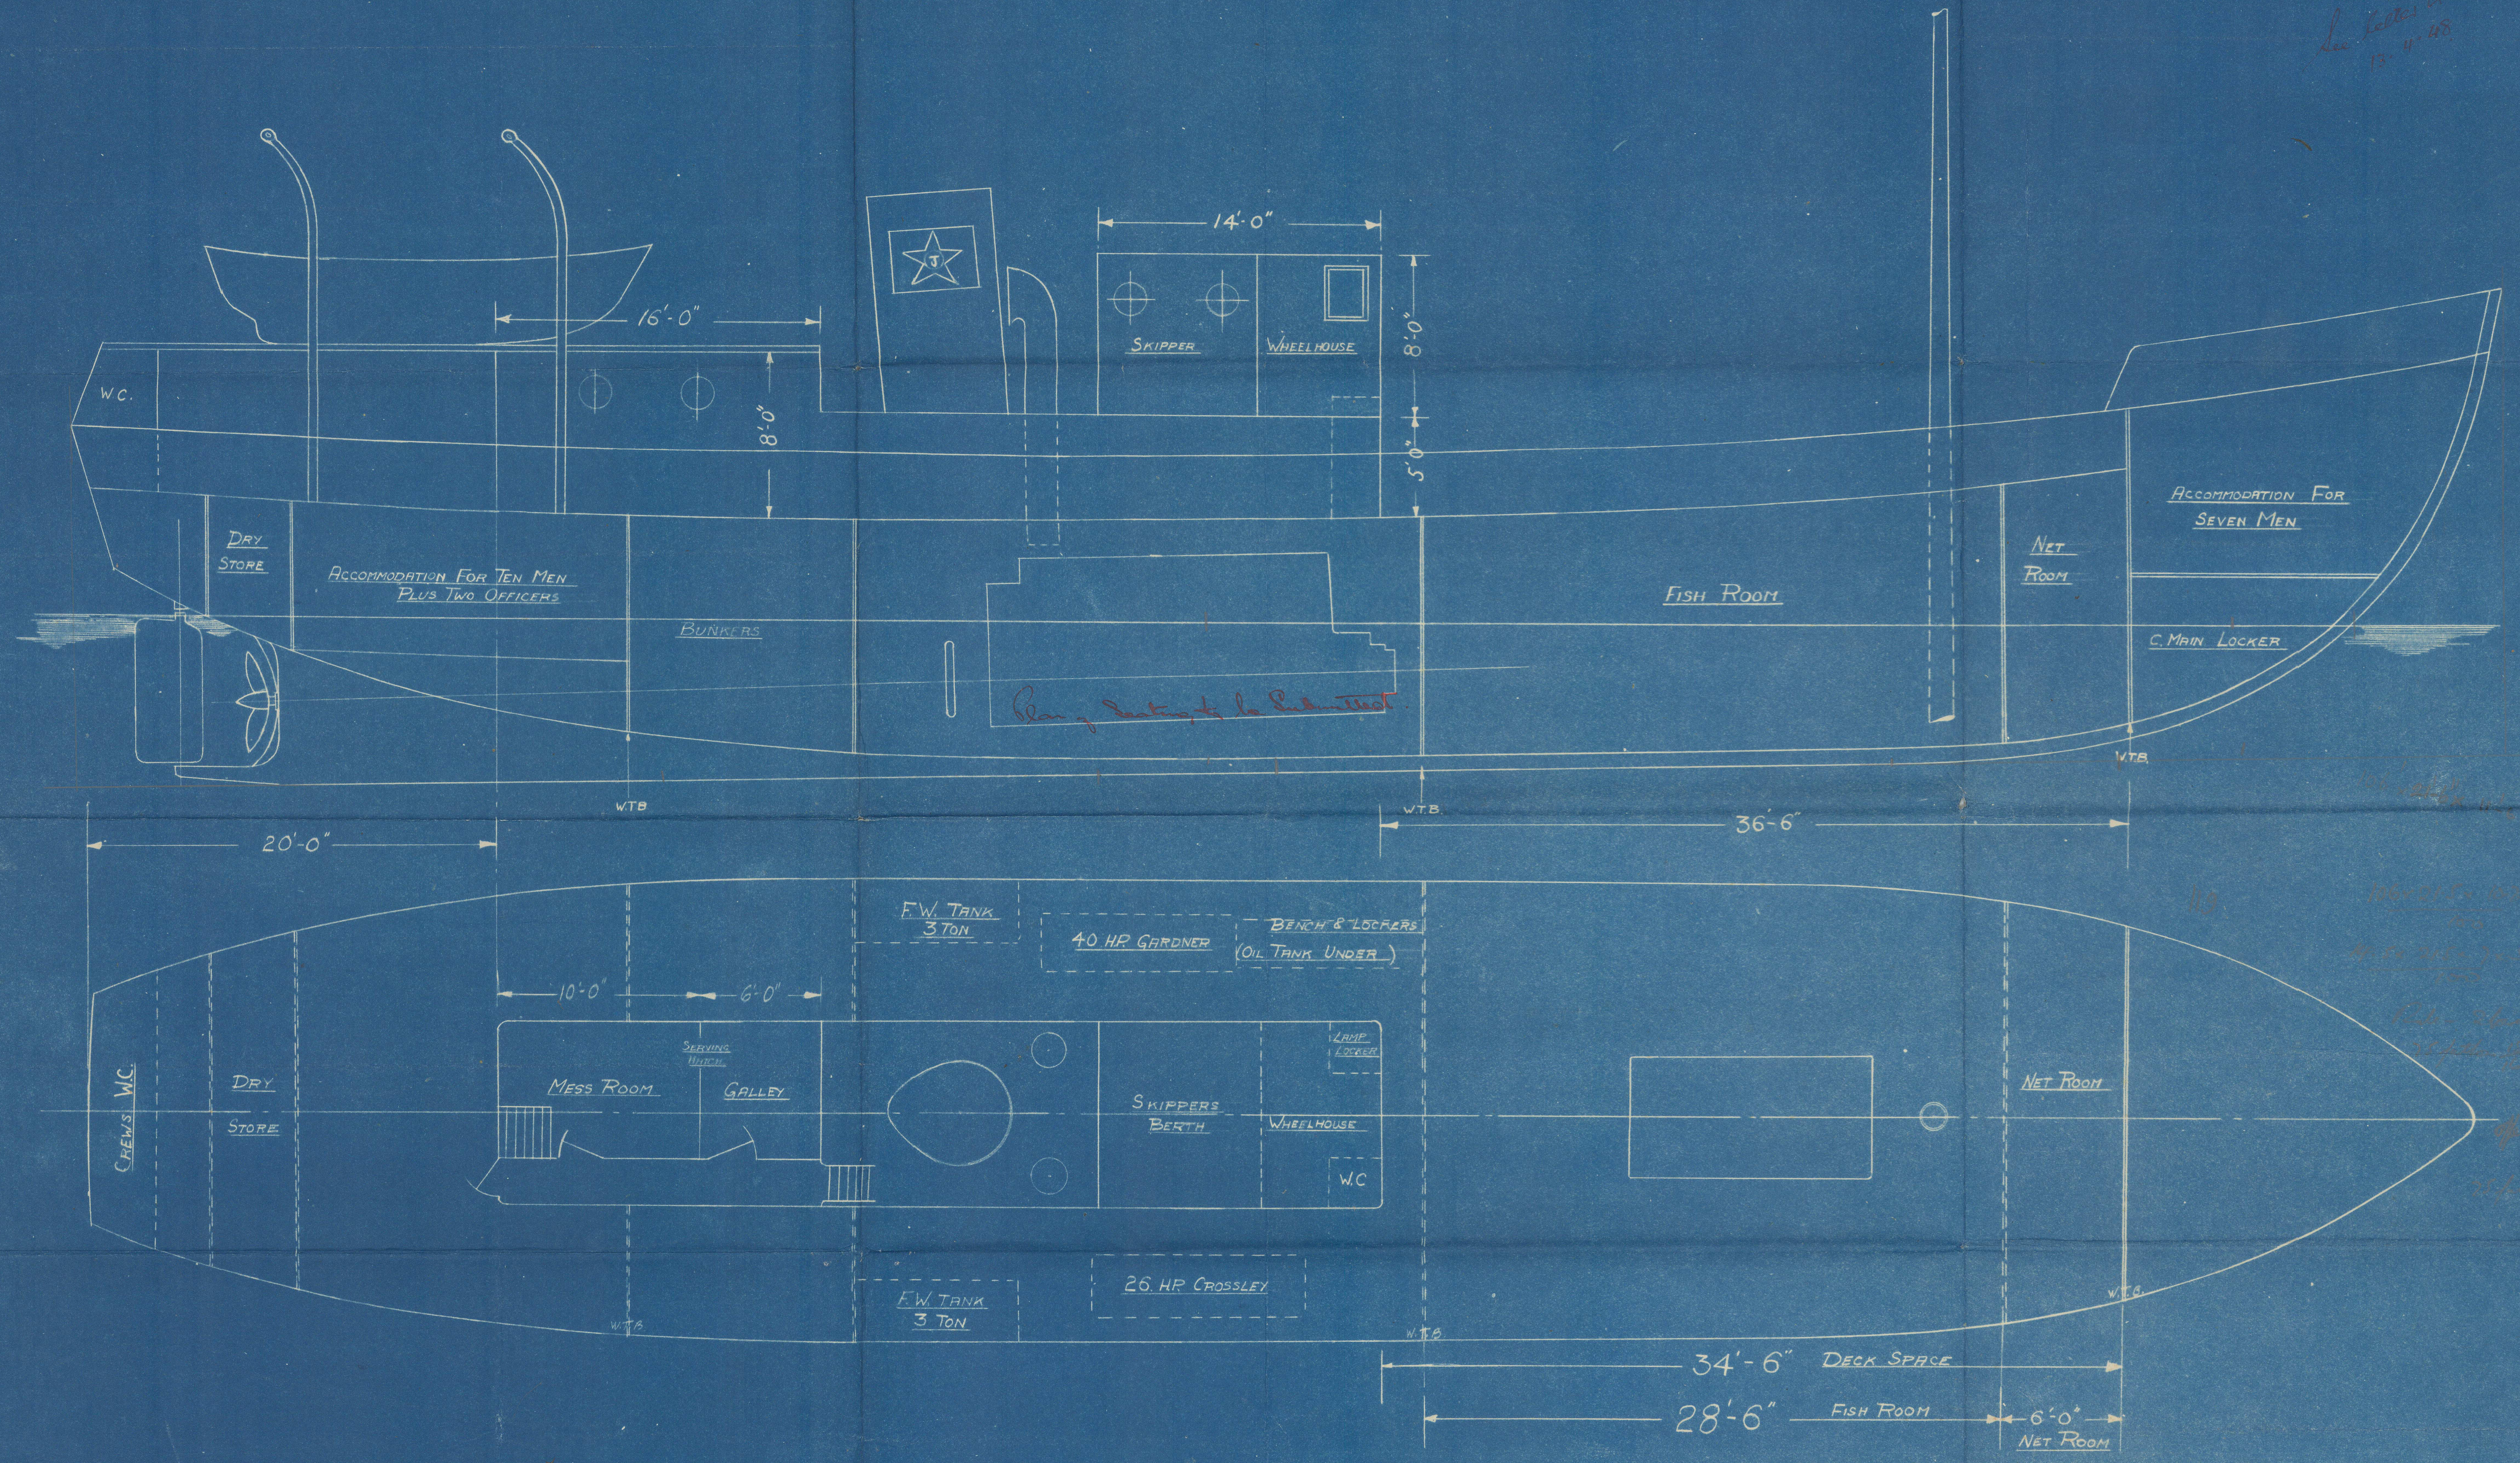

PROPOSED CONVERSION OF M.M.S 376
TO FISHING VESSEL FOR MESSRS ODDSEN & CO LTD.
GENERAL ARRANGEMENT.

SCALE 1/4" = 1 FOOT

LEAKE & WILSON
Consulting Engineers & Engineers Agents
120, ALBERT STREET, LONDON, E.C. 4
HULL
17-3-48

General Arrangement.

M.M.S. 376. conversion to fishing sm.

Hull - 12.1.18.

now Aftanes

R

19 MAR 1948

Hull -

M.M.S. 376/Conversion to fishing sm.

General Arrangement



10' 6" x 10' 9"

Lloyd's Register
Foundation