


Consider suitable for class B.S. p (Fishing Purposes)
 Subject condition of hull as found after survey.

19 MAR 1948

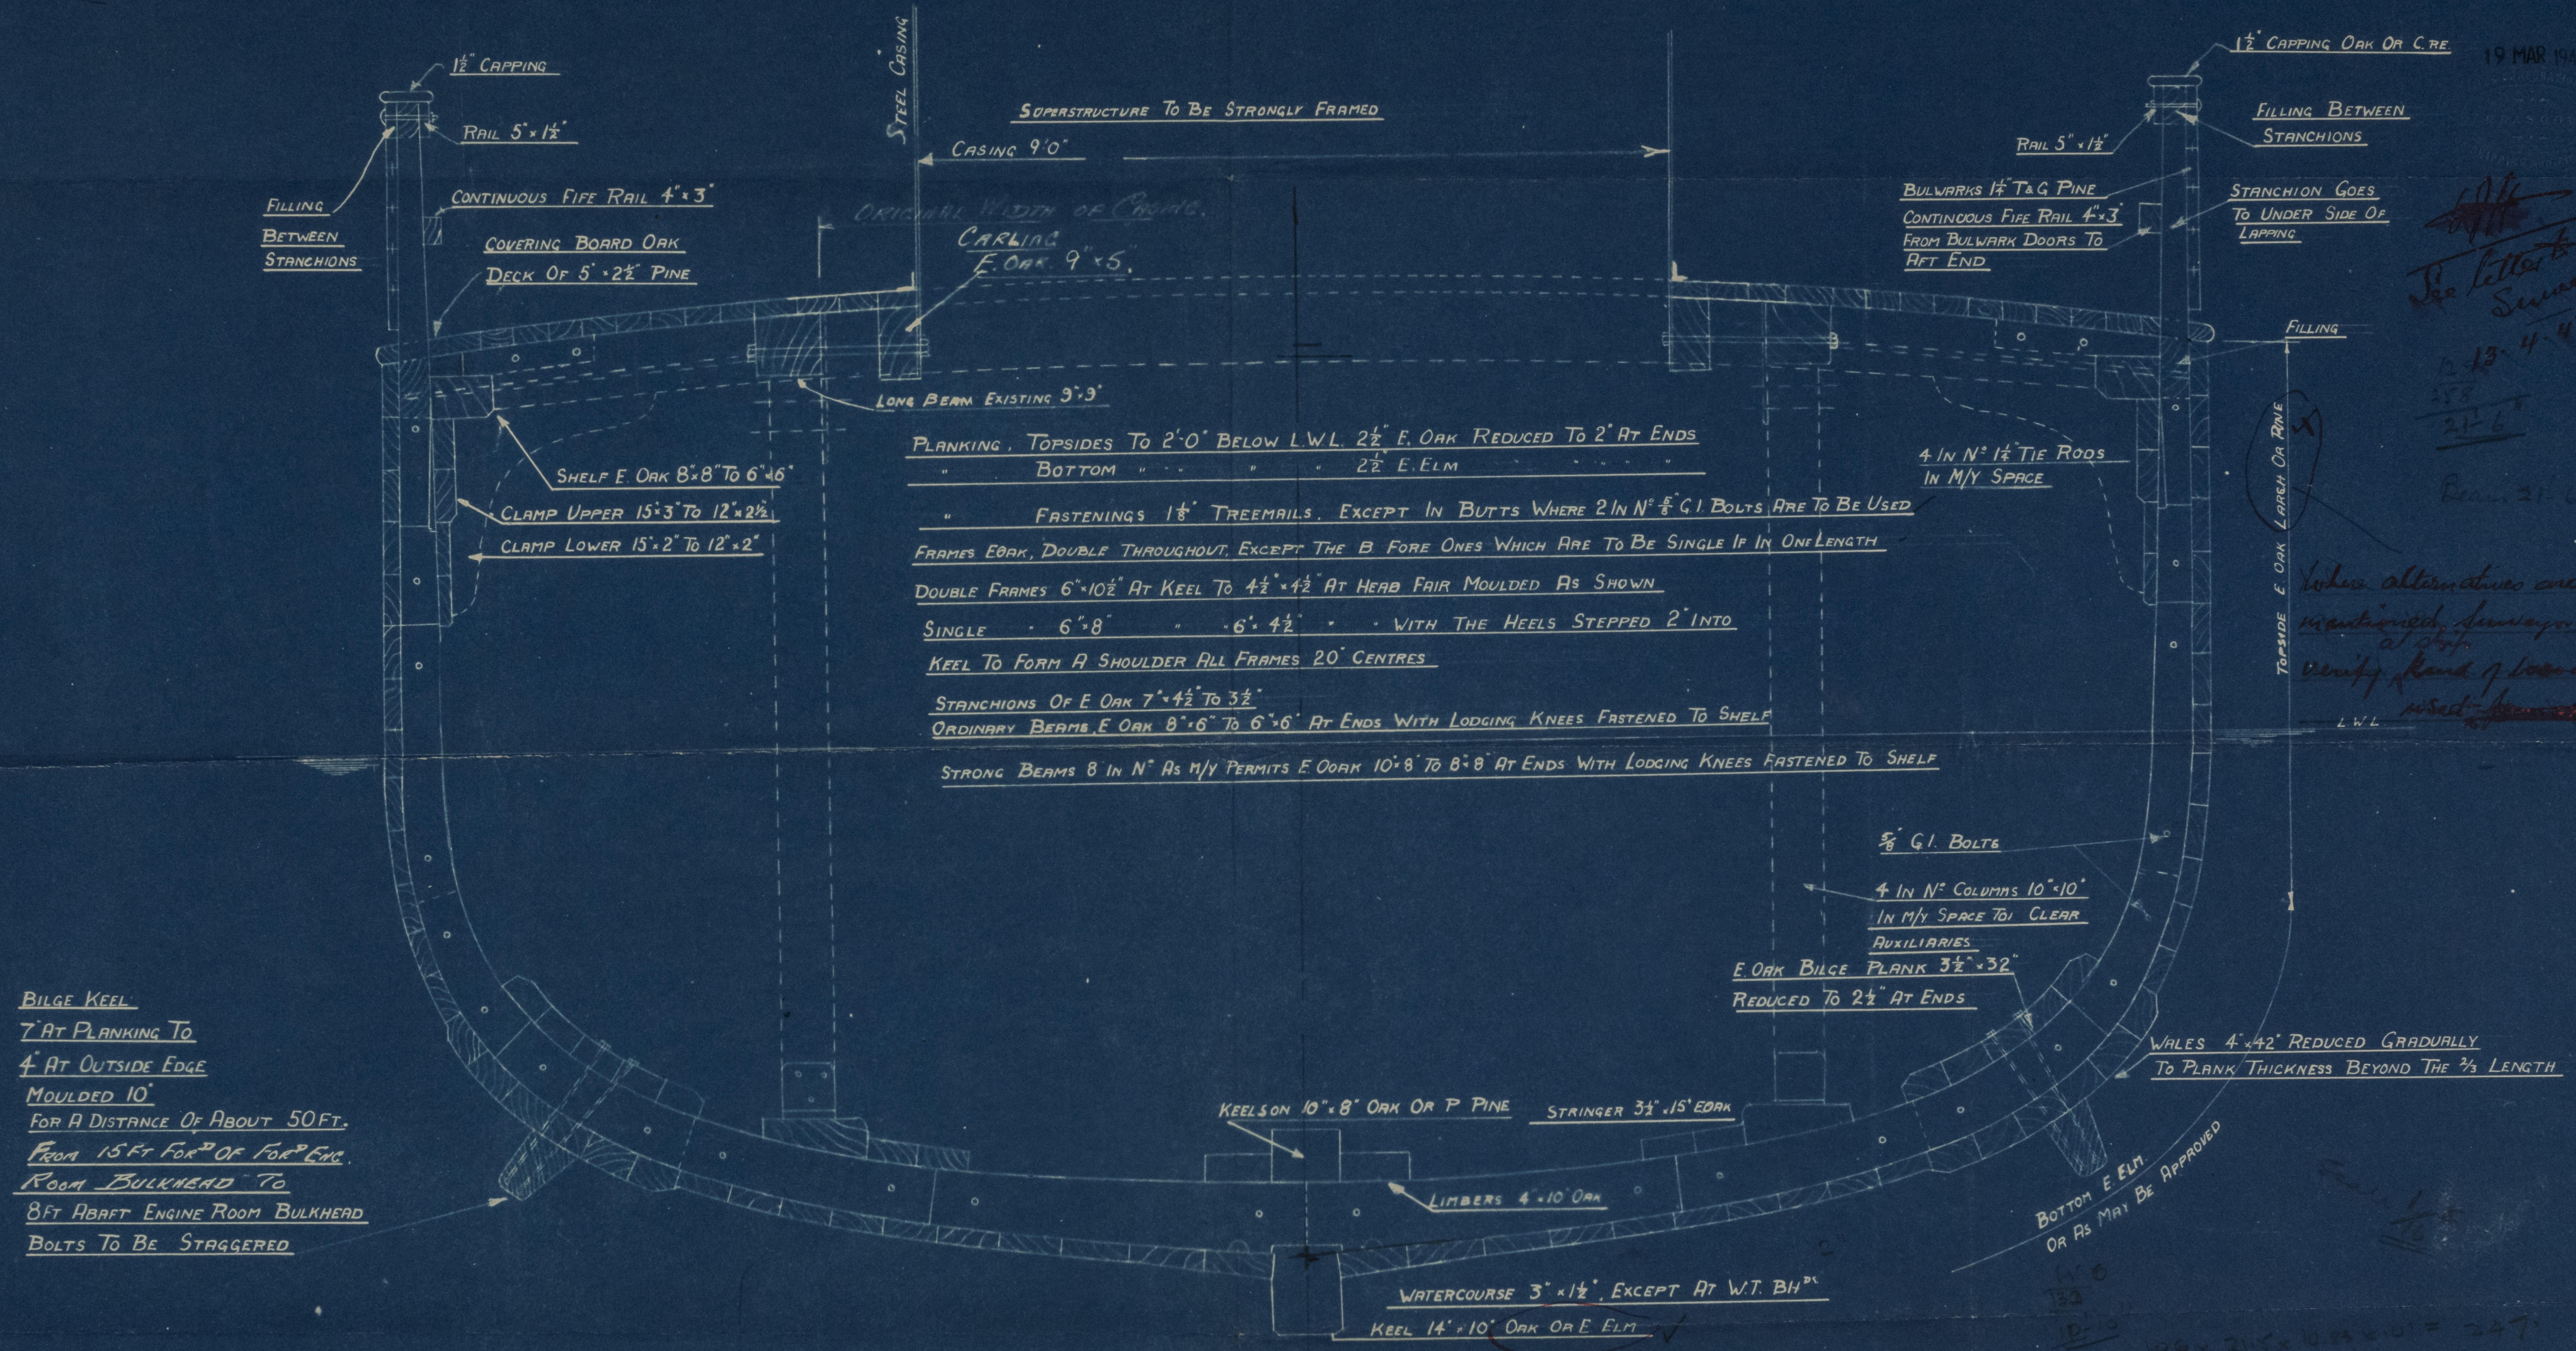

BILGE KEEL
 7" AT PLANKING TO
 4" AT OUTSIDE EDGE
 MOULDED 10"
 FOR A DISTANCE OF ABOUT 50 FT.
 FROM 15 FT FOR^W OF FOR^W ENG.
 ROOM BULKHEAD TO
 8 FT ABOARD ENGINE ROOM BULKHEAD
 BOLTS TO BE STAGGERED

PROPOSED CONVERSION OF M.M.S. 376 TO
 FISHING VESSEL FOR MESSRS. ODDSEN & CO LTD.
 MIDSHIP SECTION.
 SCALE 3/4" = 1 FOOT

LEAKE & WILSON
 Consulting Engineers & Lighters Agents
 120, MARK LANE, LONDON, E.C.3



© 2021
 Lloyd's Register
 Foundation

Midship Section

M.M.S. 576 conversion to fishing in

Hull 12. 1. 18.

now Aftanes

015424-015432-0043


R

19 MAR 1948

Hull

M.M.S. 310 conversion to fishing in

Midship Section

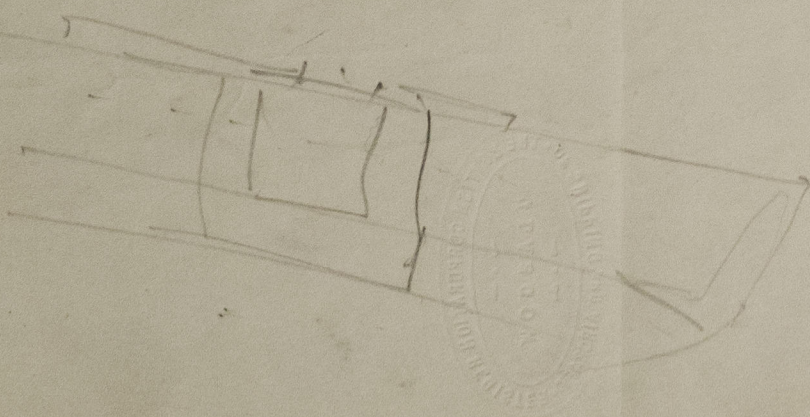

© 2021

Lloyd's Register
Foundation