



11052 P.D. 2
 2-2-22
 157
 11052 P.D. 2
 2-2-22
 157

No. 294 & 5
 Pumping Plan.
 Scale 1/8" to 1 Foot.
 Pomeron 294

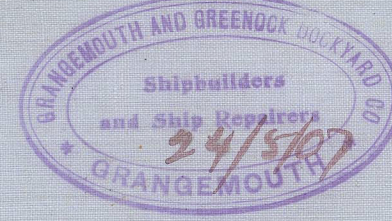

APPROVED
 27.5.22
 27.5.22

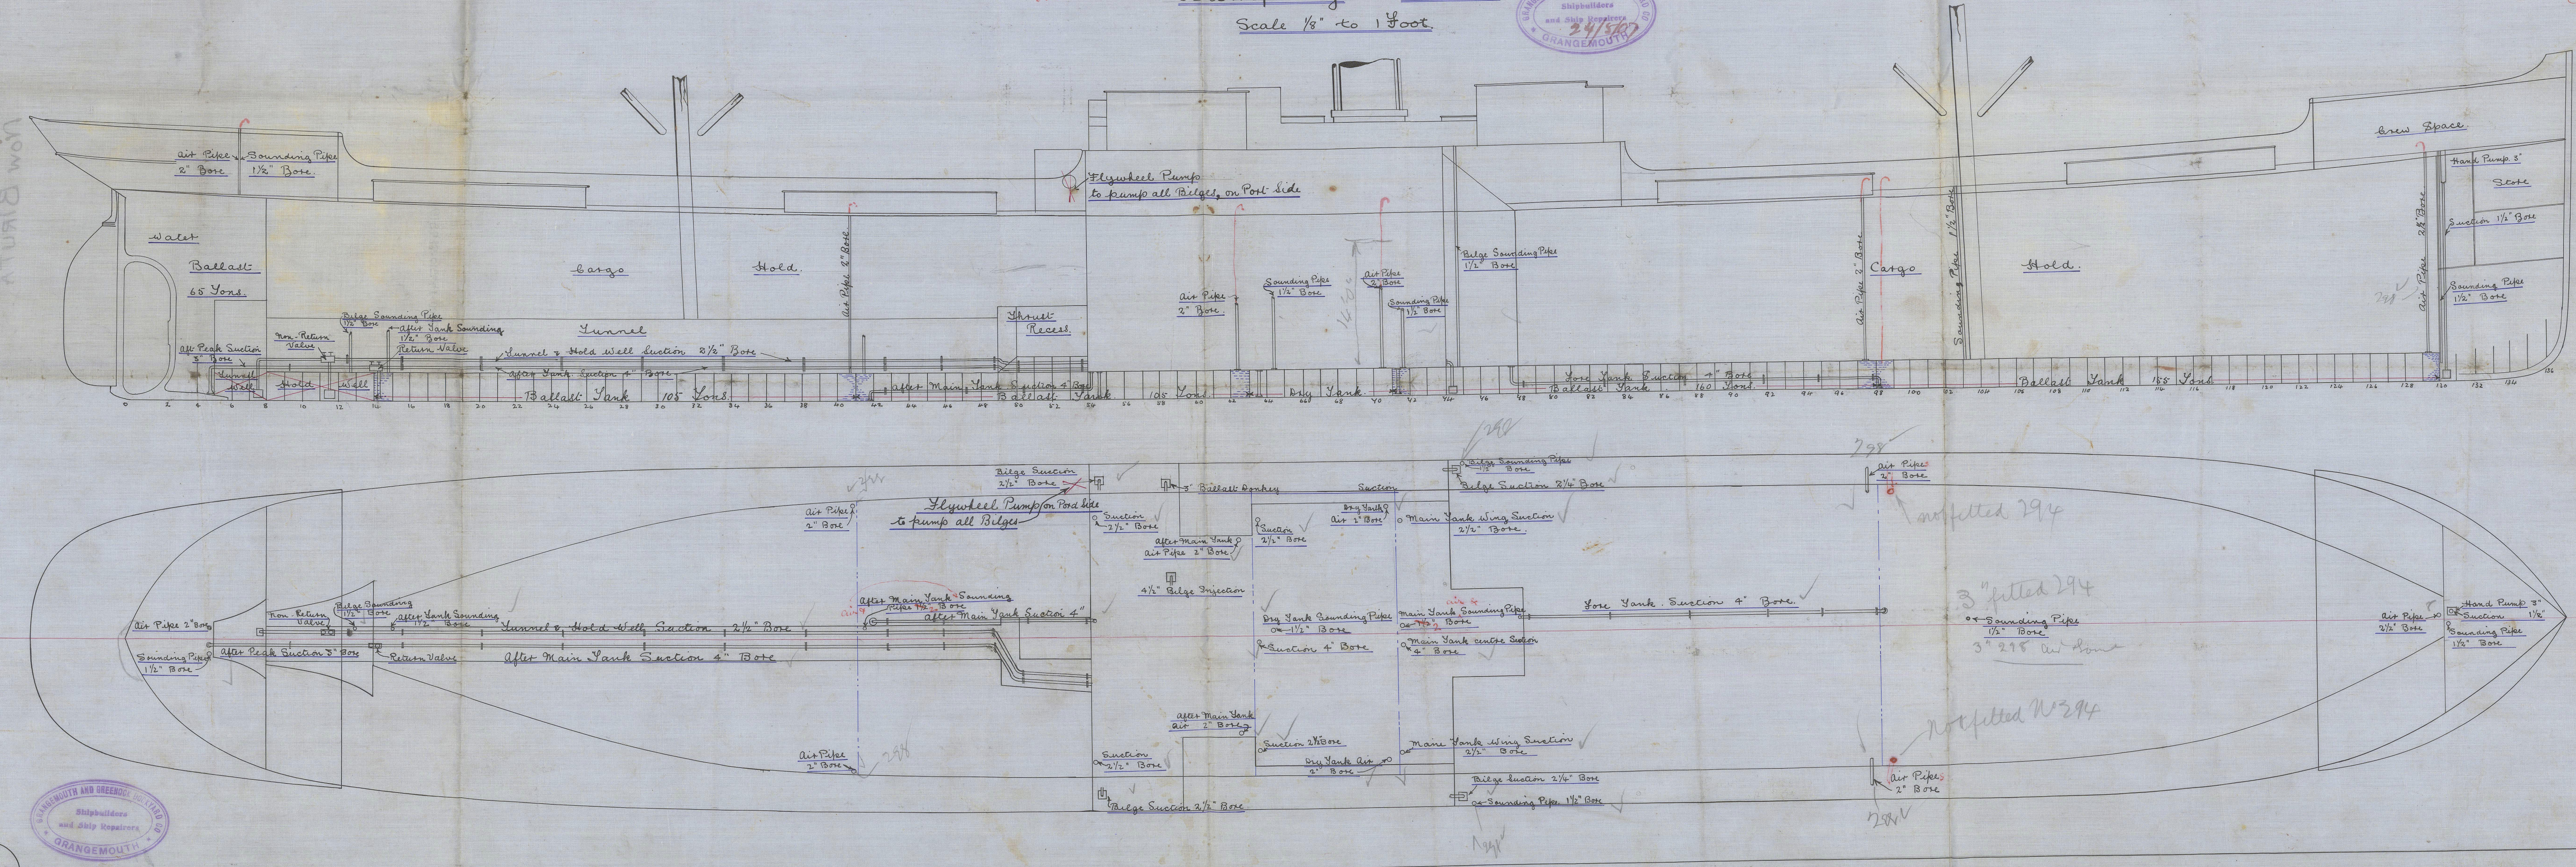

Grangemouth Greenocks
No 294 - S

Amended Pumping
Plan

SS POMERON

SS NORTON

Wraymore ex Pomeron
Now BIRUTA



© 2021

Lloyd's Register
Foundation

015433-015441-0070