


N^o 241 RUDDER AND STERN POST

SCALE $\frac{3}{4}$ " & 3" = 1 FT
TO BRITISH CORPORATION REQUIREMENTS
AREA OF RUDDER TO L.W.L. ABAFT $\frac{1}{4}$ OF PINTLES 53.4"
CENTRE OF GRAVITY OF RUDDER 3.16"
SERVICE SPEED OF SHIP 9 KNOTS AT SEA ✓
RUDDER AND STERN FRAME OF FORGED STEEL ✓
CENTRE LINE OF MAIN PIECE PARALLEL TO $\frac{1}{4}$ OF PINTLES ✓

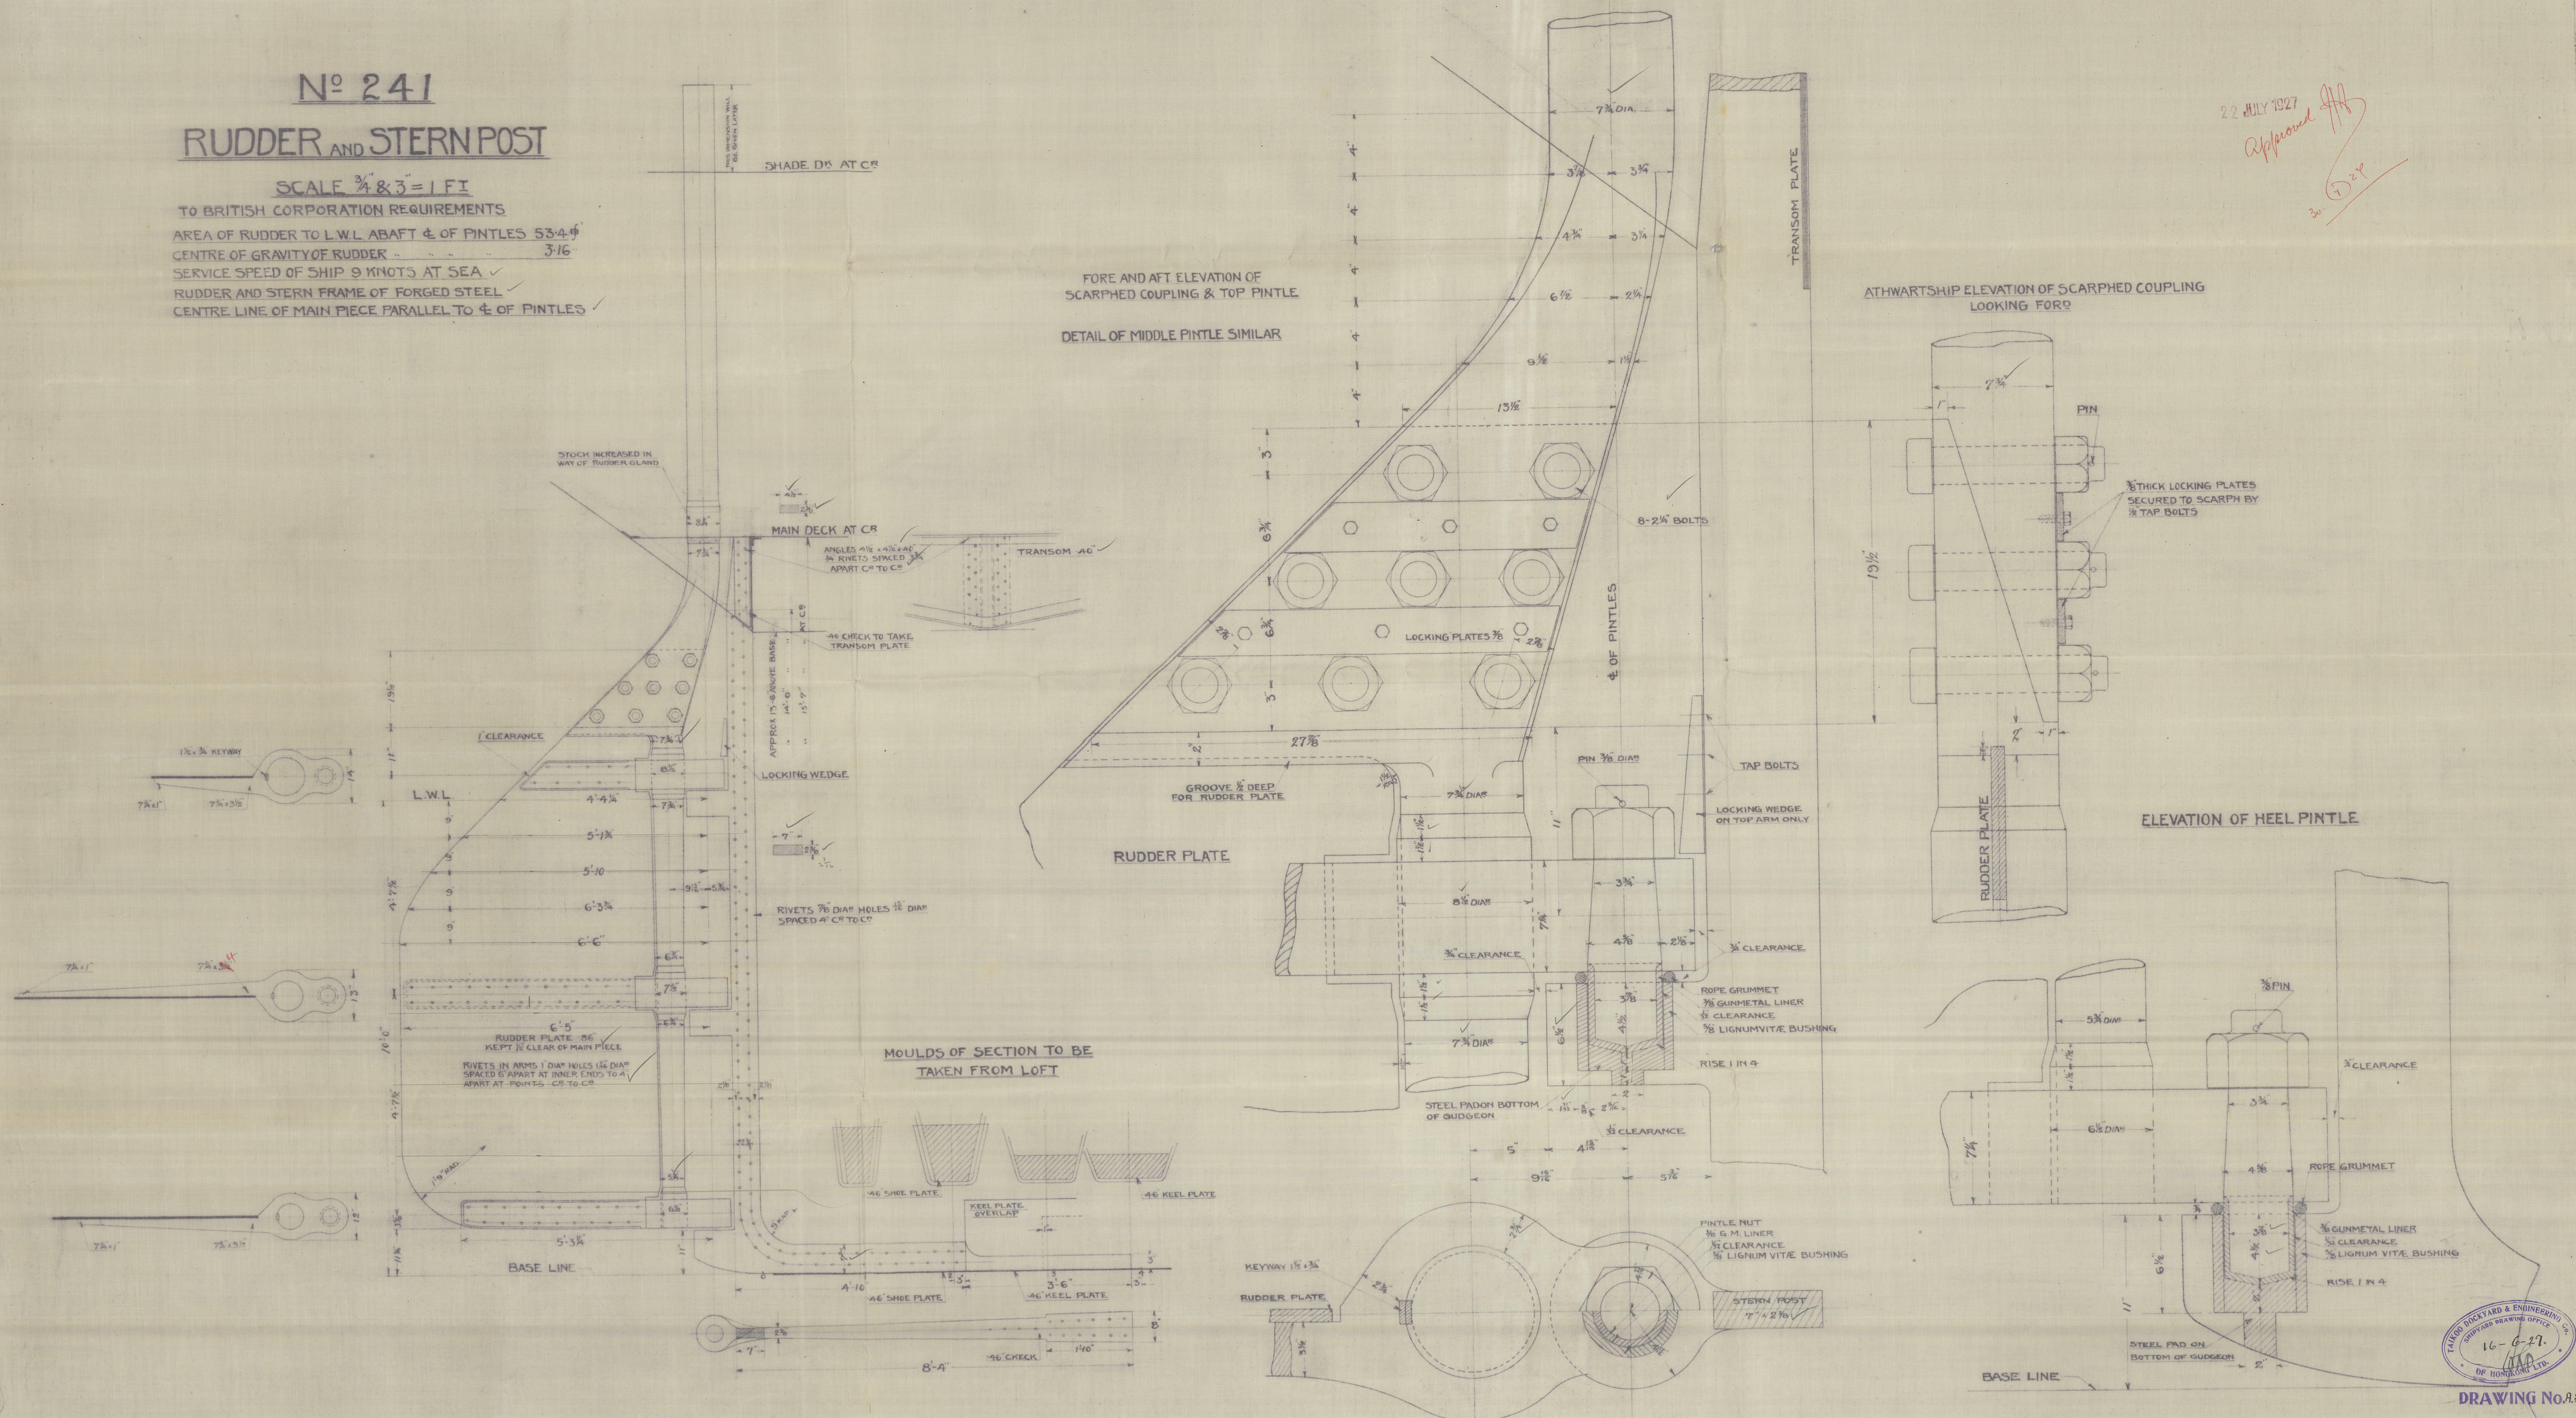

22 JULY 1927
Approved *[Signature]*
30 128

16-6-27
110
DRAWING No. A.8707

015433-016441-0030

5

Rudder & Sternpost

Yaikee Dkd. Co.

N.H.

30.7.27.

"Matang"

Boat