

MIDSHIP SECTION.

S.S. N^o 34-15.

DIMENSIONS.

LENGTH B.P. 313'-6"
BREADTH M^d 45'-0"
DEPTH M^d TO UPPER DE. 21'-0"
DEPTH M^d TO SHELTER DE. 30'-0"

SCALE 1/2" = 1 FOOT.
TO CLASS B.S.*



Approved 9/2

Rule area

*60 x 44 = 2640
44 x 44 = 1936
117 x 44 = 5148
79*

22'0"

22'0"

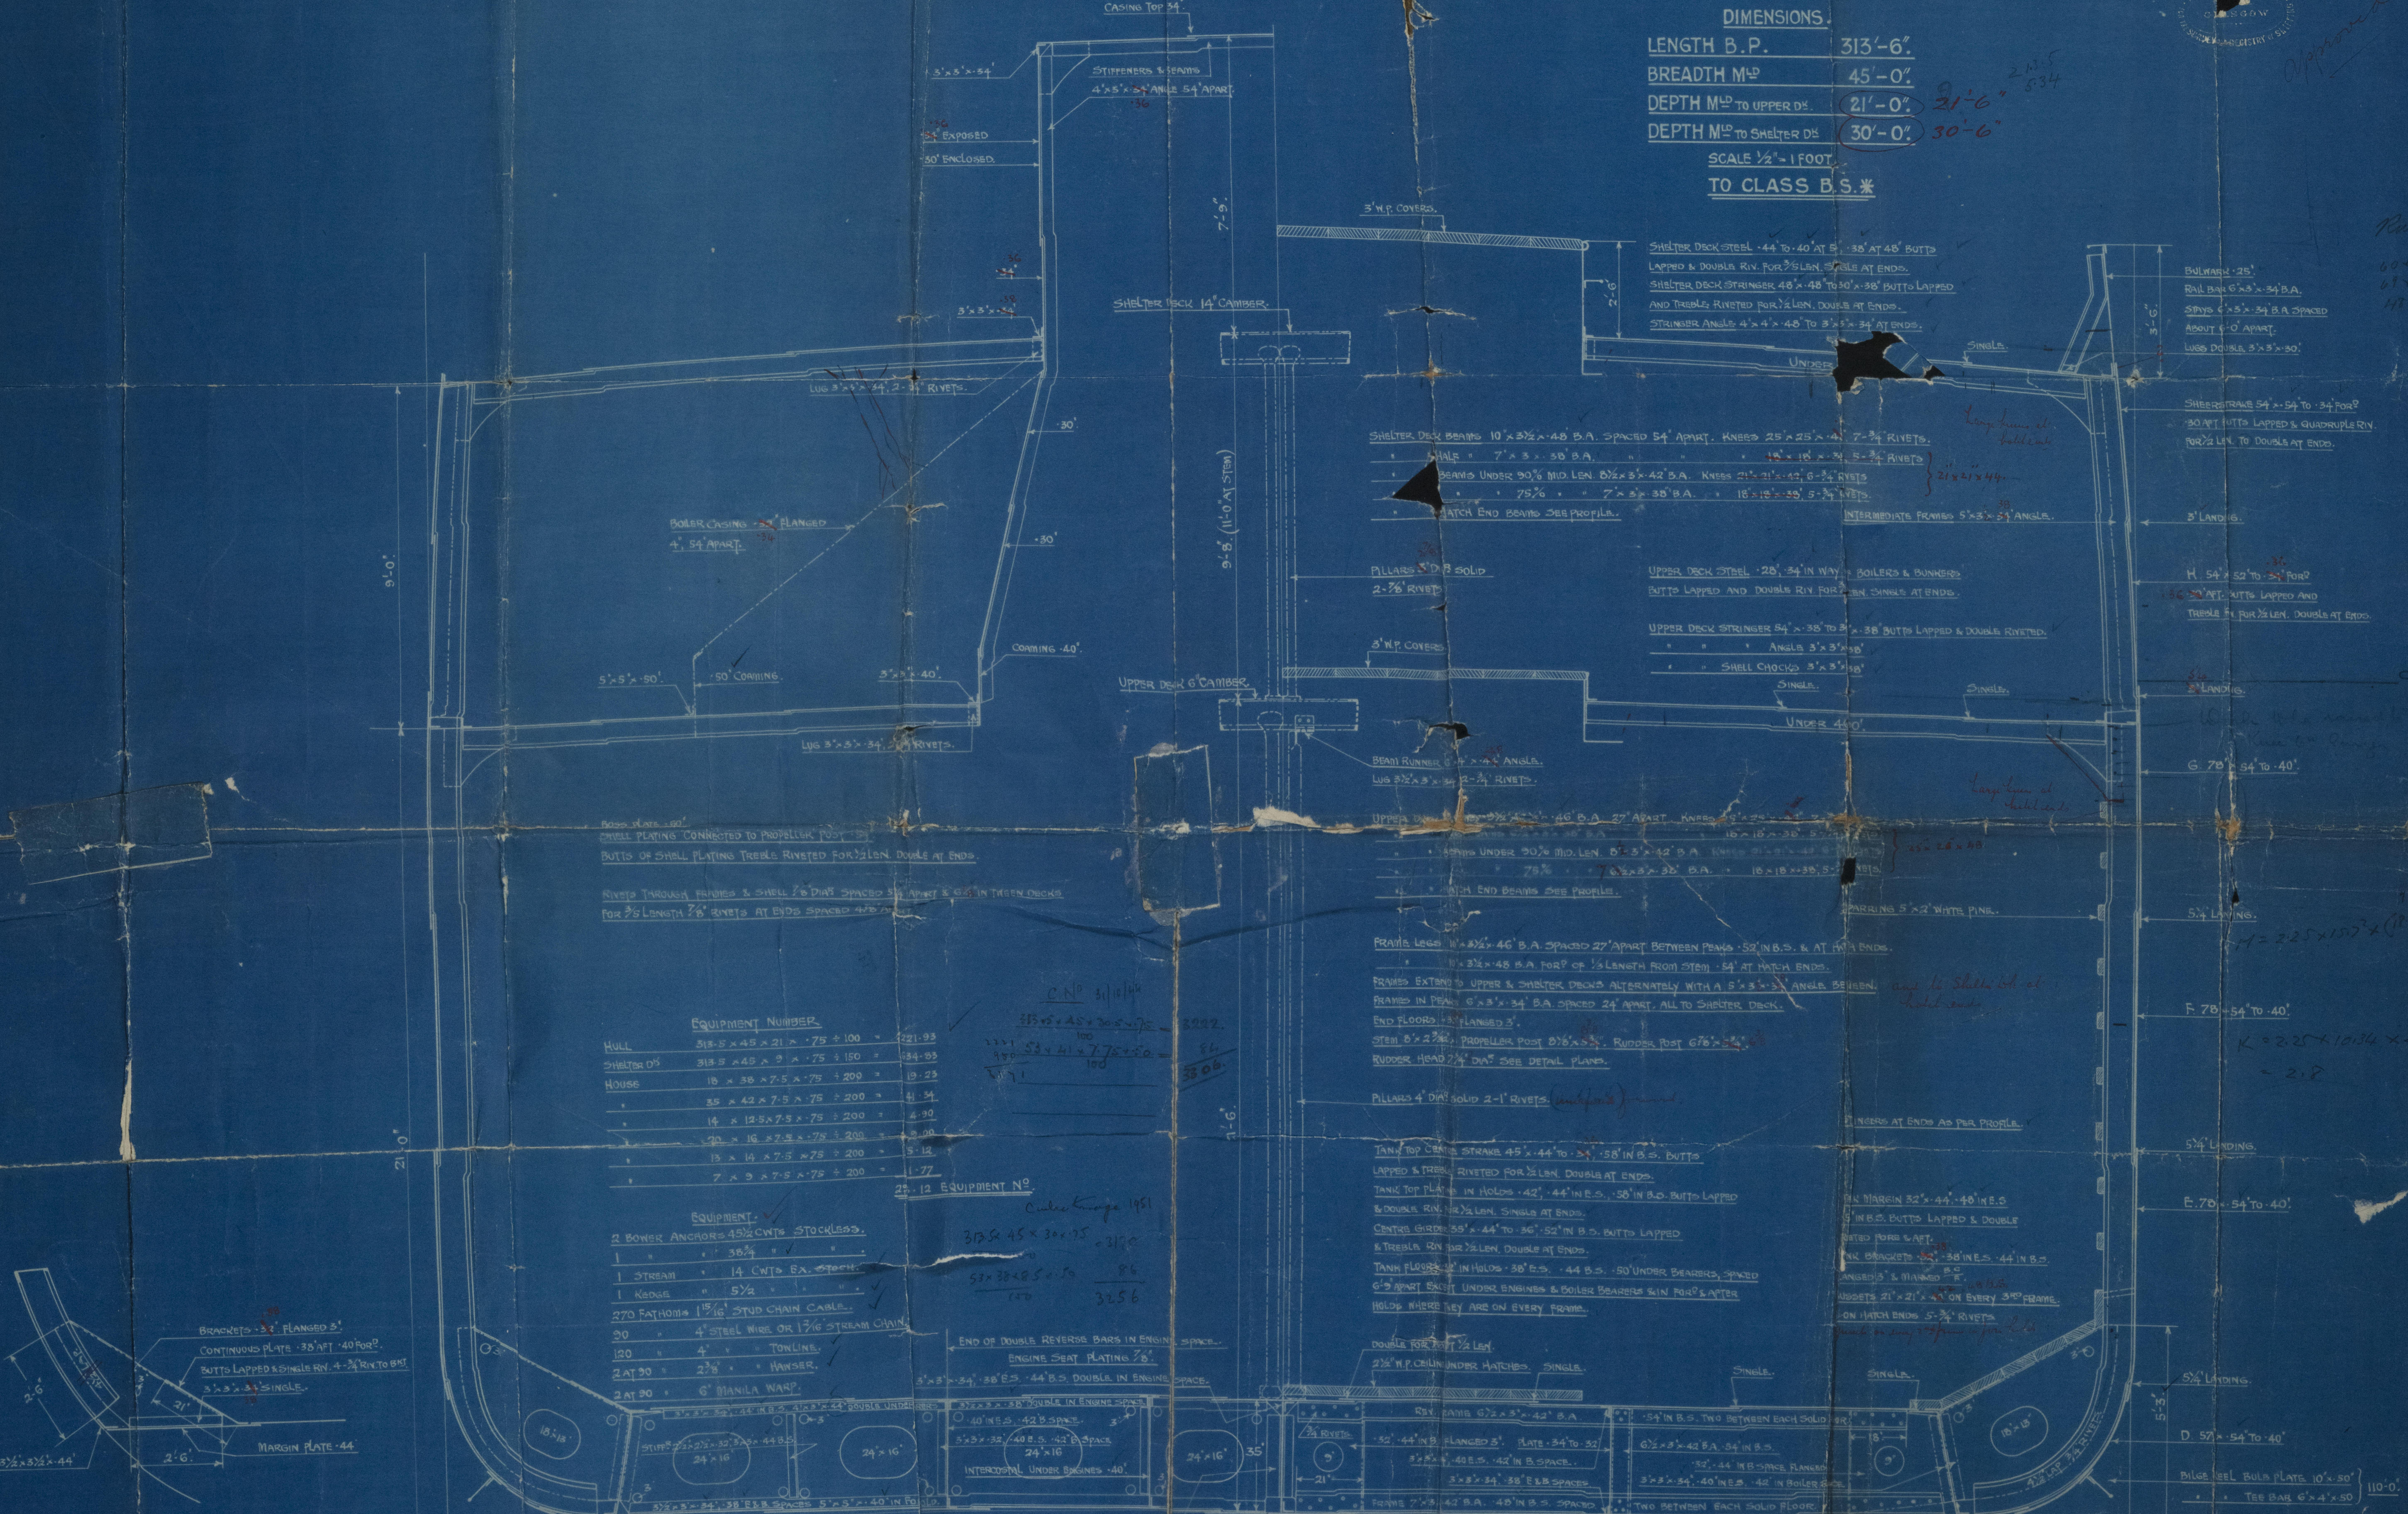

FRAME BRACKET WHERE TANK TOP IS CARRIED TO SHIPS SIDE.

EQUIPMENT NUMBER	
HULL	518-5 x 45 x 21 x .75 x 100 = 221.93
SHUTTER DE	518-5 x 45 x 21 x .75 x 150 = 332.89
HOUSE	10 x 36 x 7.5 x .75 x 200 = 19.23
	35 x 42 x 7.5 x .75 x 200 = 41.34
	14 x 12.5 x 7.5 x .75 x 200 = 4.90
	13 x 14 x 7.5 x .75 x 200 = 3.00
	7 x 9 x 7.5 x .75 x 200 = 1.77
2. EQUIPMENT N ^o	
EQUIPMENT	

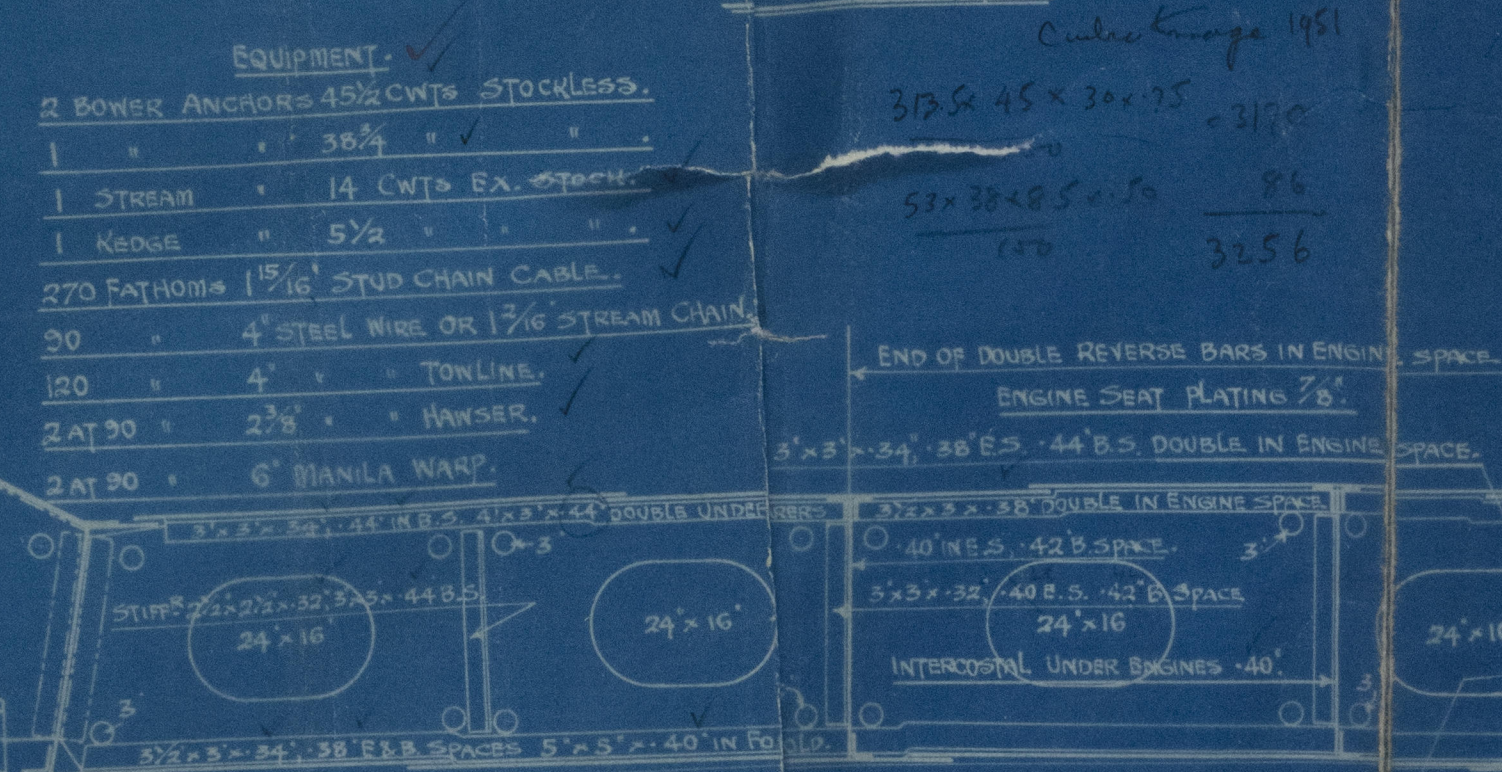

NOTES: A.B.C. STRINGS OF SHELL PLATING TO BE .58" IN FOR HOLD FLAT OF BOTTOM. CLOSELY SPACED INTERCOSTALS FOR ABOUT 33" APART.


015450-015460-0282

514-15

313'-6" x 45'-0" { 21'-8"
30'-0"

Midship Section

$\frac{L}{B}$ BC

T. C. 21" 2" 17

10

Deertran
ex

SS
SS

DESTROYED
DIDO

015450-015460-0282



© 2021

Lloyd's Register
Foundation

22'0"

31.5
2.75
35.75

6
28.7
1.16
27.54

015450-015460-0282

2.58.00
10.32.55



© & COY LTD.
Lloyd's Register
Foundation
3453