

Alon No 2369

Sept 21 of Hold 21


Tonnage under Deck 865.

W Hoad & Co Compo Ship

Rec. 4/9/66



Deborah Lier
on beams of
W. R. Lier

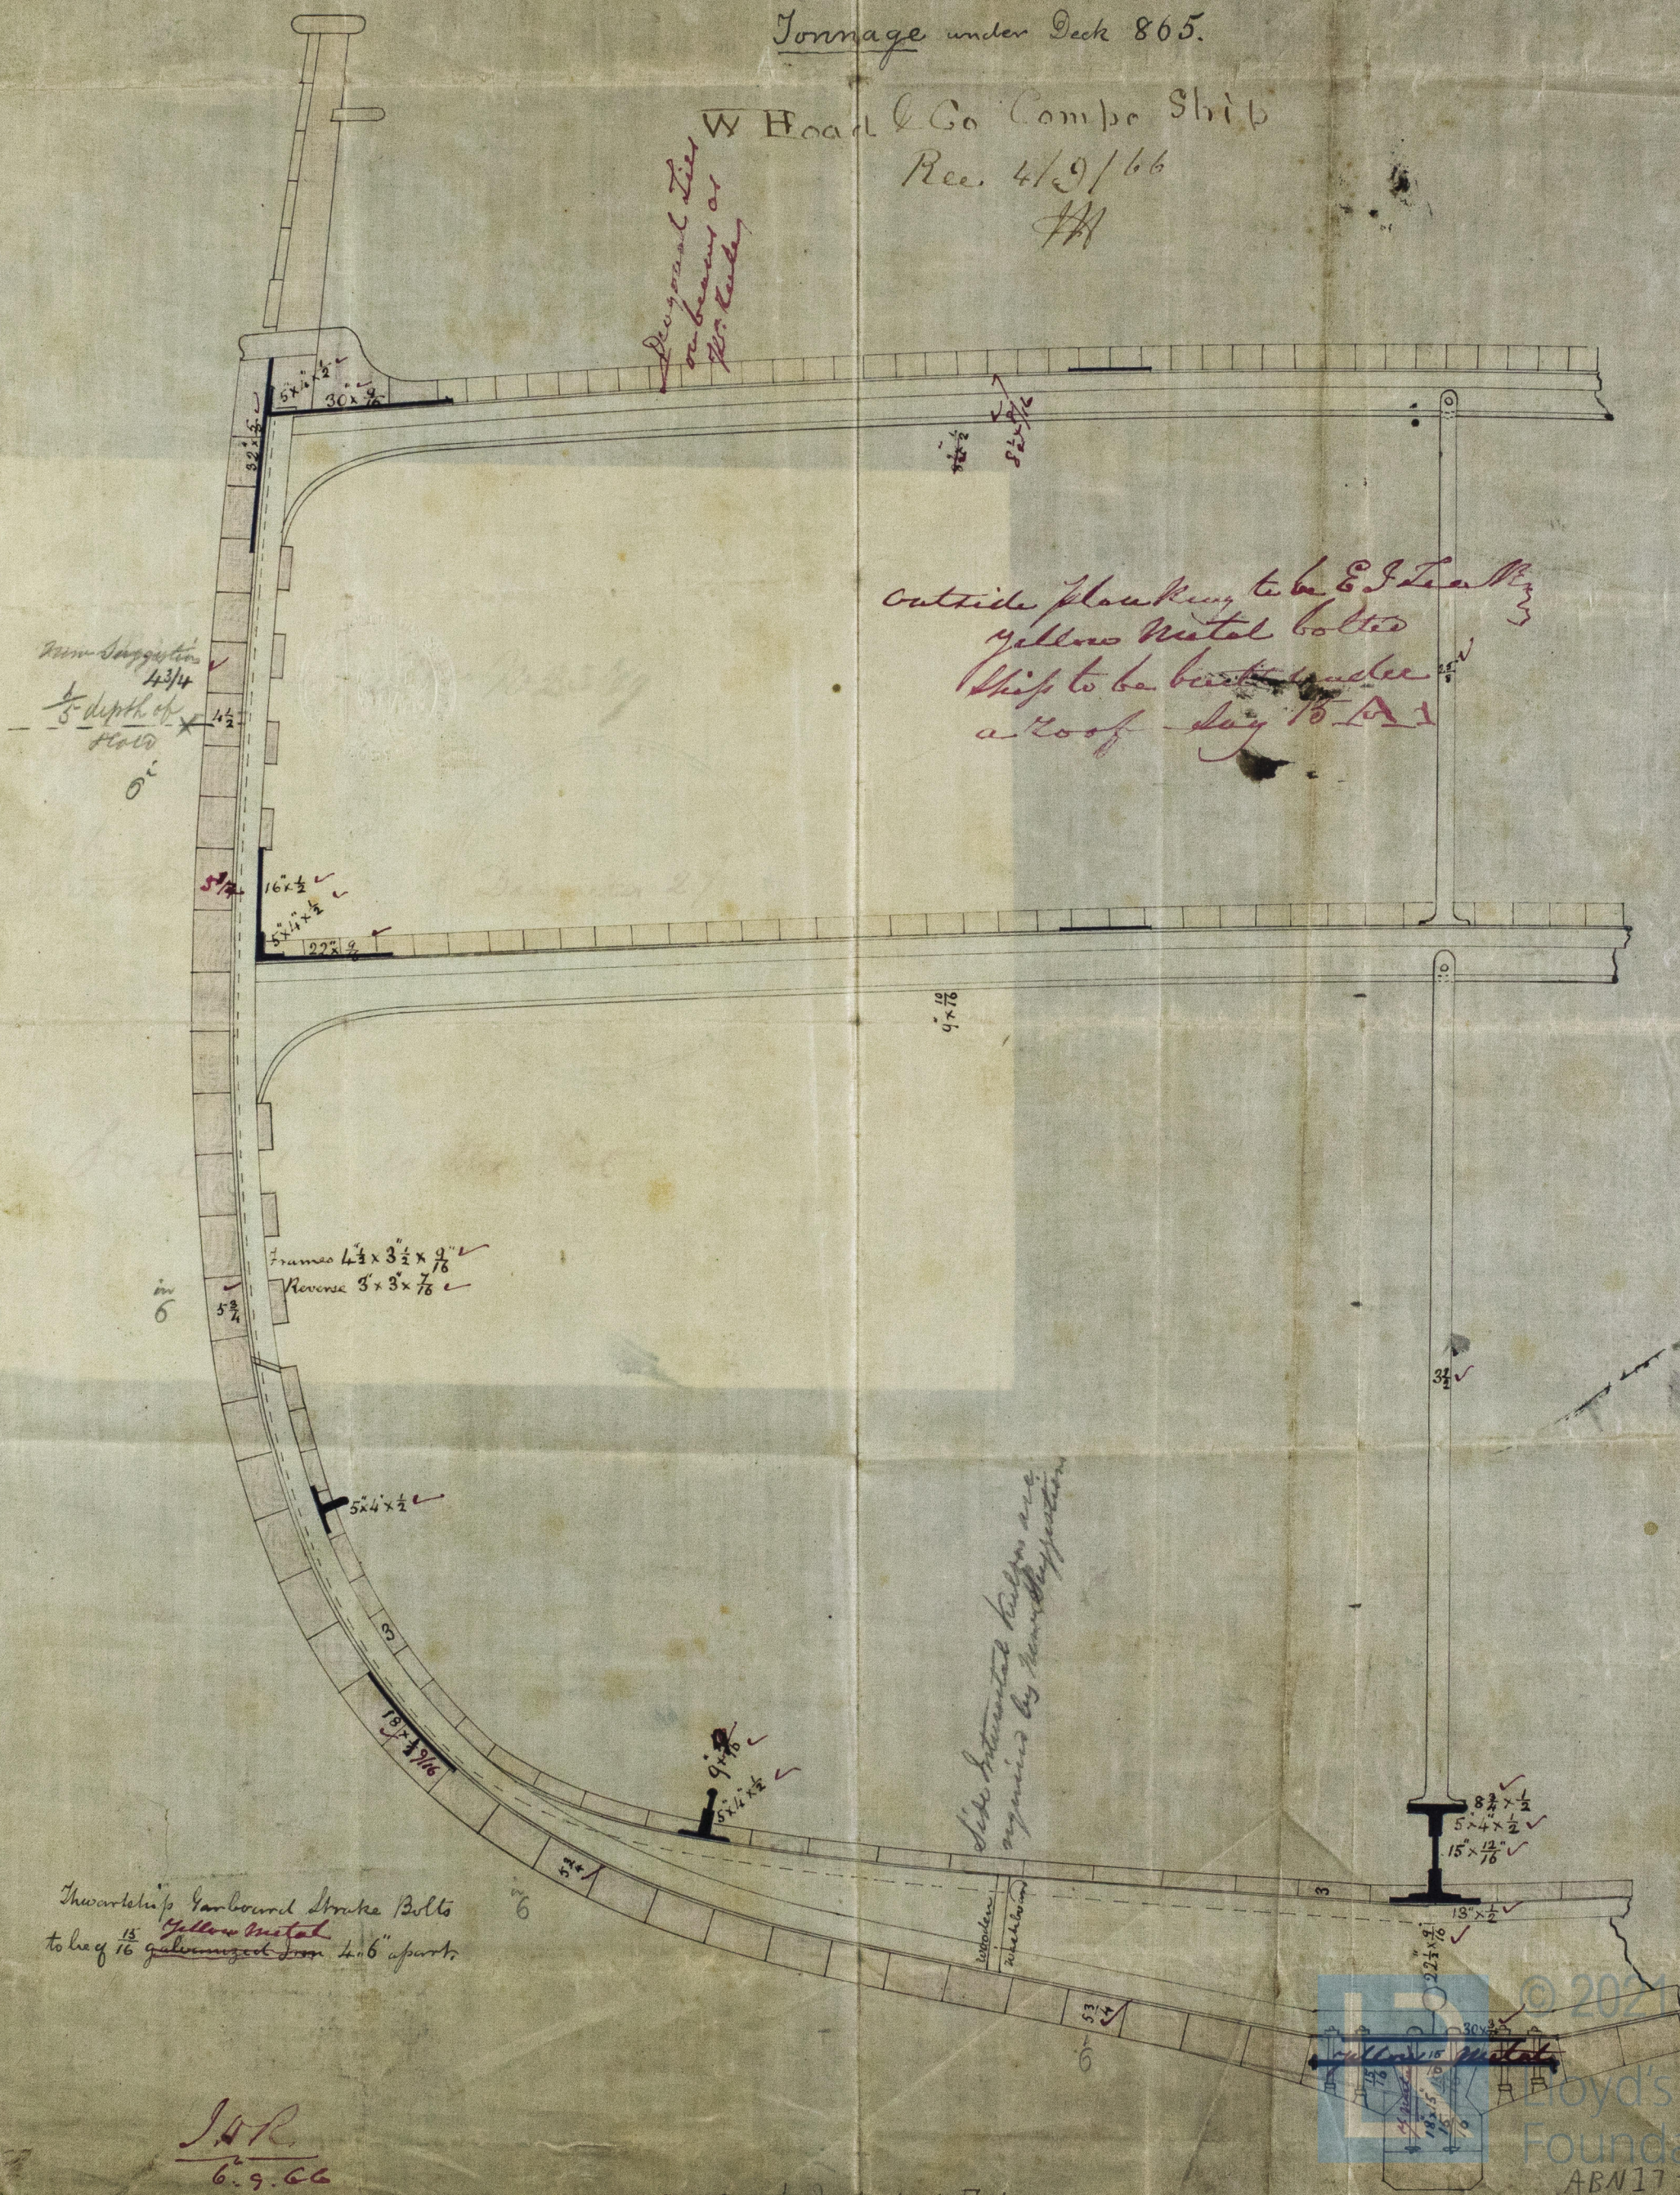

Outside Plank King to be E. J. Lee
Yellow Metal Bolted
Ship to be built under
a Roof - Day 15 A1


The workship Galvanized Strake Bolts
to be of $\frac{15}{16}$ Yellow Metal galvanized iron 4.6" apart.

J. H. R.
6.9.66

Scale $\frac{1}{2}$ inch to 1 Foot

ABN 17-0022