Orlando

Abn
No 2056

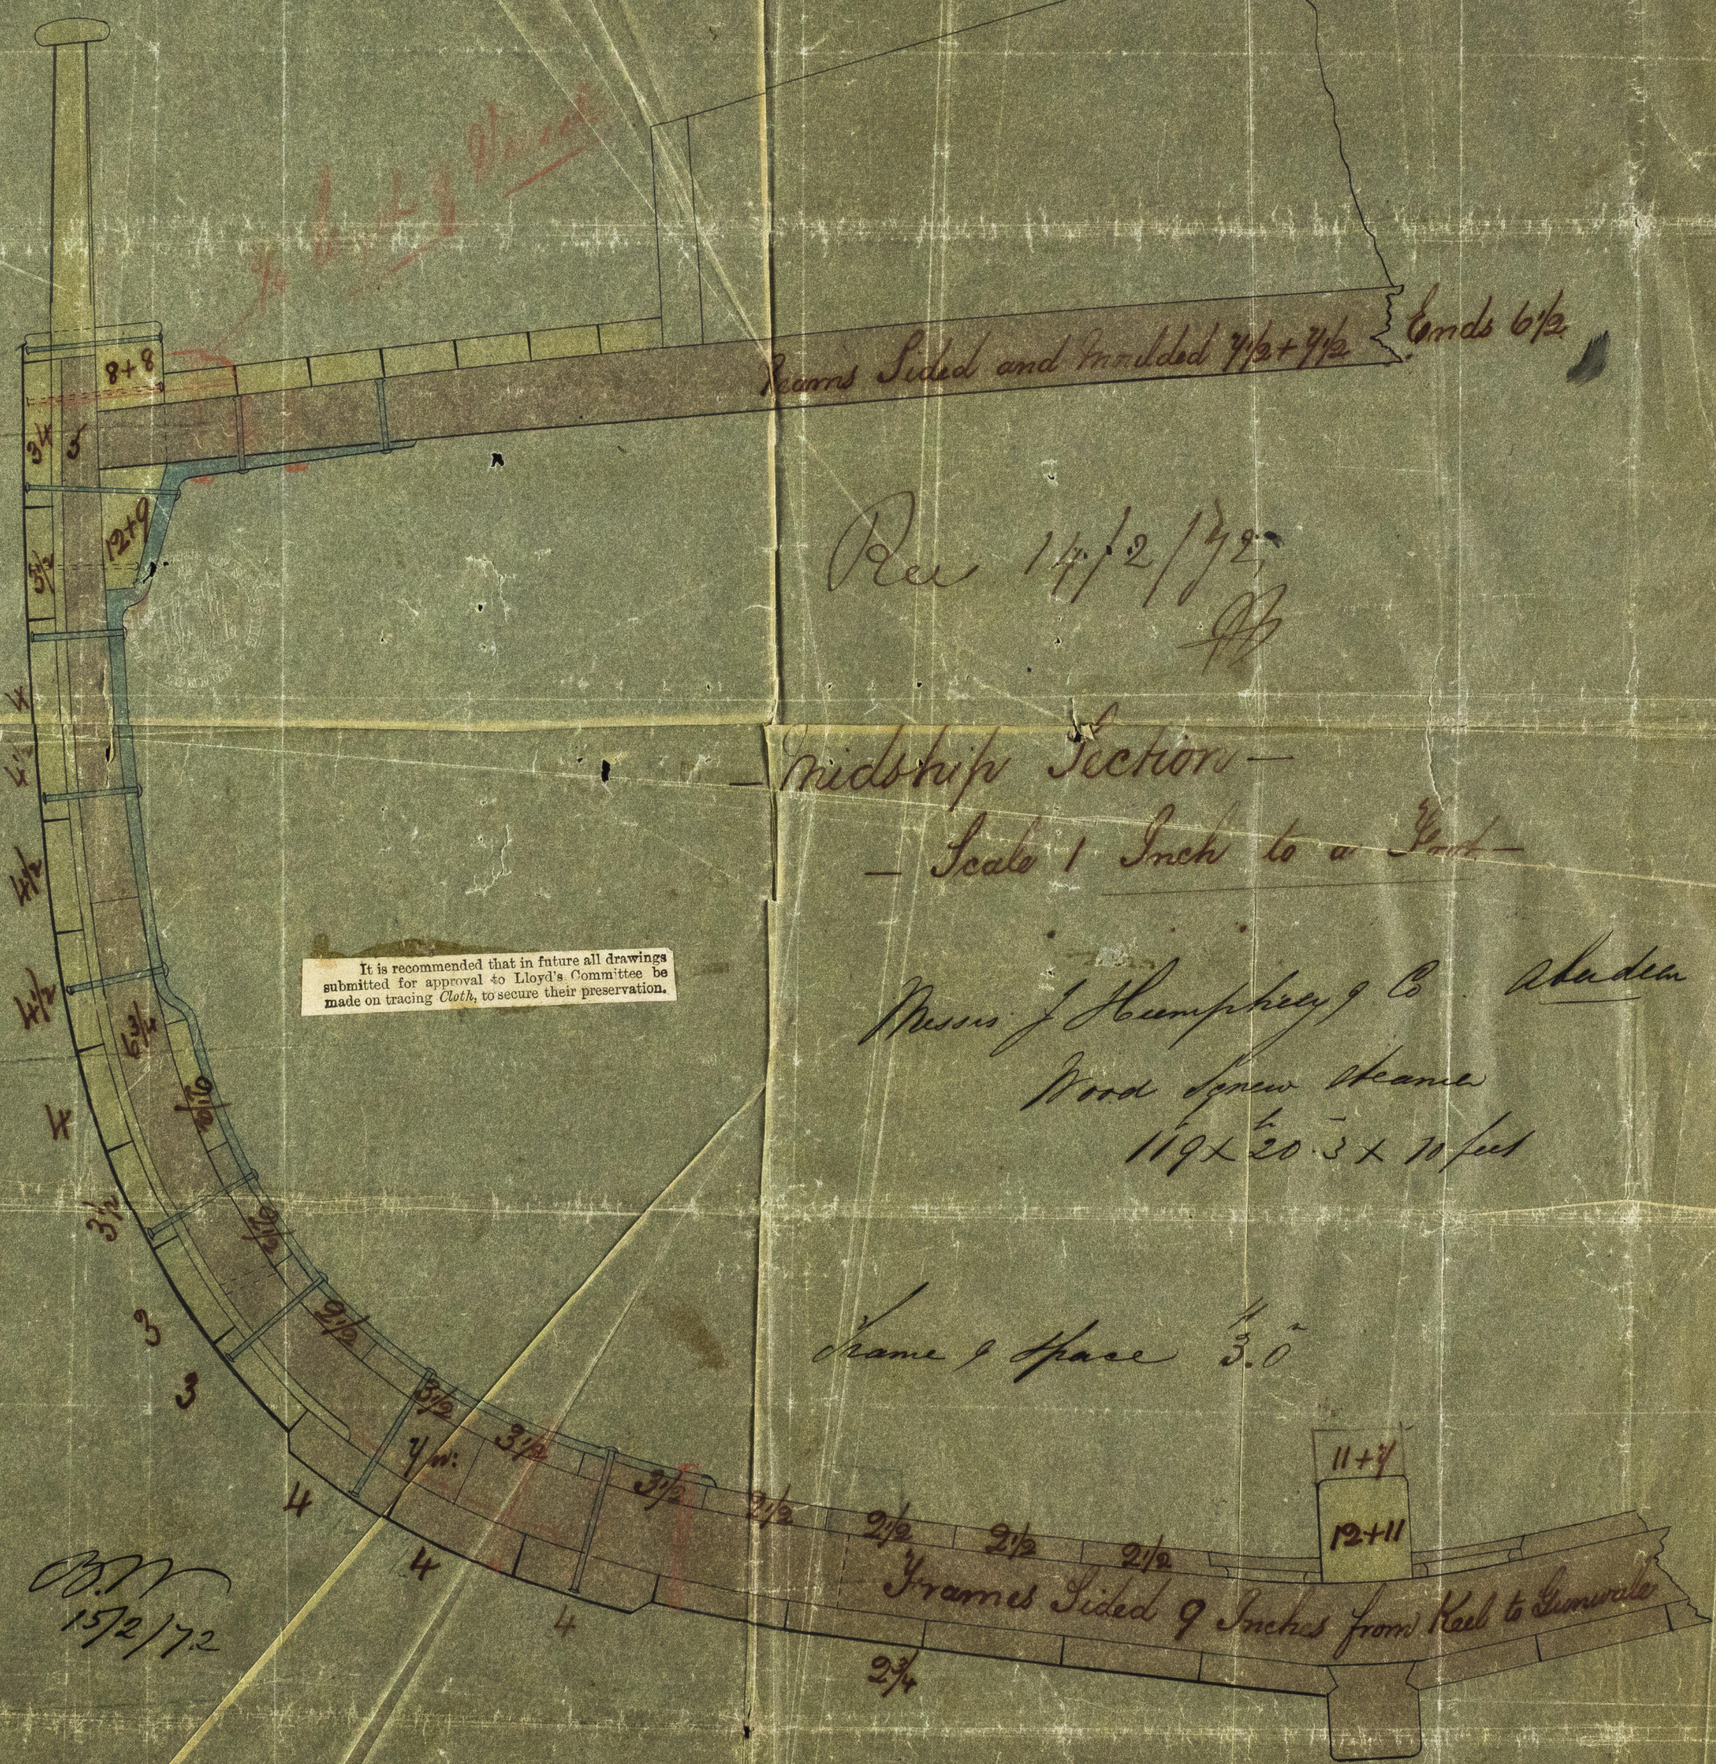

Rec 14/2/72

Midship Section —
— Scale 1 Inch to a Foot —

Messrs J Humphreys & Co Aberdeen
Wood Screw Steamer
119 × 20.3 × 10 feet

Frame & Space 3.0

Orlando
15/2/72

It is recommended that in future all drawings submitted for approval to Lloyd's Committee be made on tracing *Cloth*, to secure their preservation.

15/2/72

© 2021 Lloyd's Register Foundation
ABN17-0078