

MIDSHIP SECTION


of Smack

DRYAD OF LERWICK

Dimensions

Length from fore part of stem to after side of stern post 64-0
 Breadth Extreme 16-4
 Depth in Hold 10-5
 Tonnage Register 52 tons

Rec 17/12/77

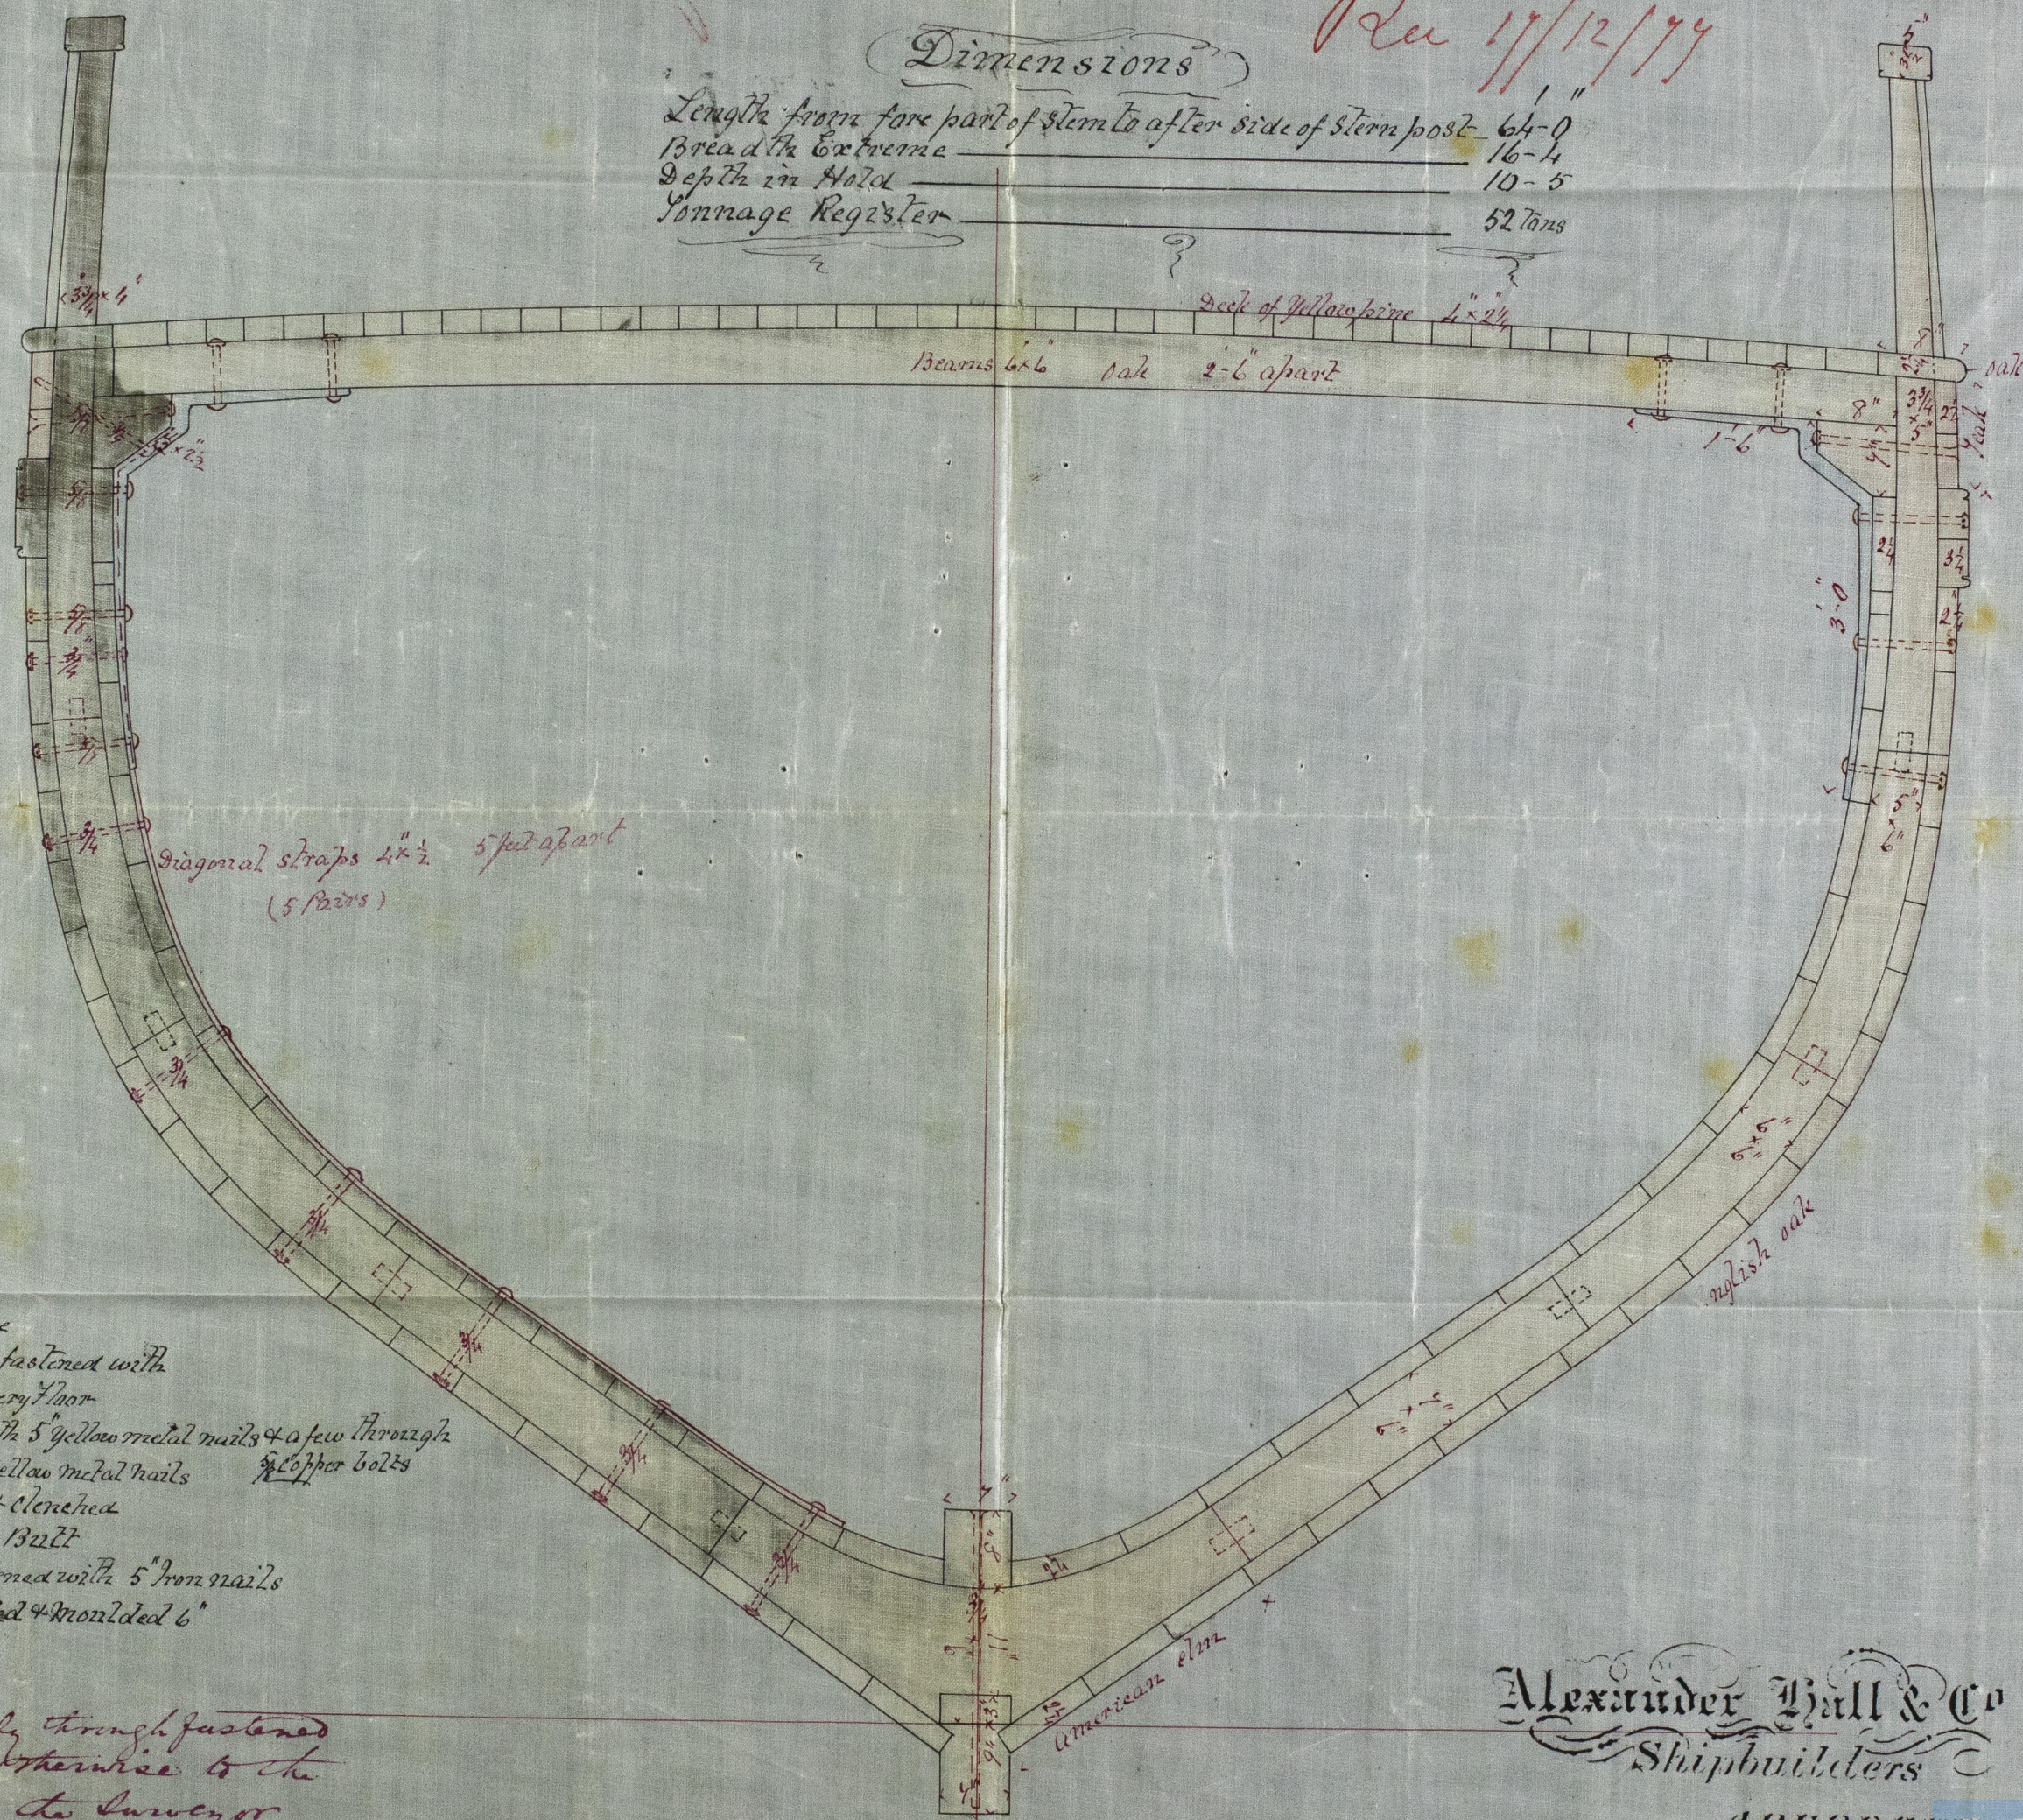

Size of Scantlings:
 Keel of American elm 9 x 4
 Frames of English oak
 Spaced 21" from centre to centre
 Keelson of English oak 8 x 4 fastened with
 3/4" Copper bolts one through every floor
 Plank lining 2 1/2" thick fastened with 5" yellow metal nails & a few through
 Butts secured with two 5" yellow metal nails & Copper bolts
 & one 5/8" Copper bolt through & clenched
 in the timber before & abaft the BUTT
 Ceiling of oak 2 1/2" thick fastened with 5" iron nails
 Beams of English oak sided & moulded 6"
 Spaced 2-6" apart
 Hanging knees (3 pairs)

To be additionally through fastened
 at the Butts & otherwise to the
 satisfaction of the Surveyor

Alexander Hall & Co
 Shipbuilders
 ABERDEEN.

17/12/77

SCALE 3/4" INCH TO A FOOT