

LENGTH OF KEEL ^{feet} 53

BREADTH MOULDED 18 ^{feet}


DEPTH FROM TOP OF FLOORS ^{ft in} 4 7/8

about 50 ⁱⁿ gross

Ketch rigged

Ree 23/5/78

HH

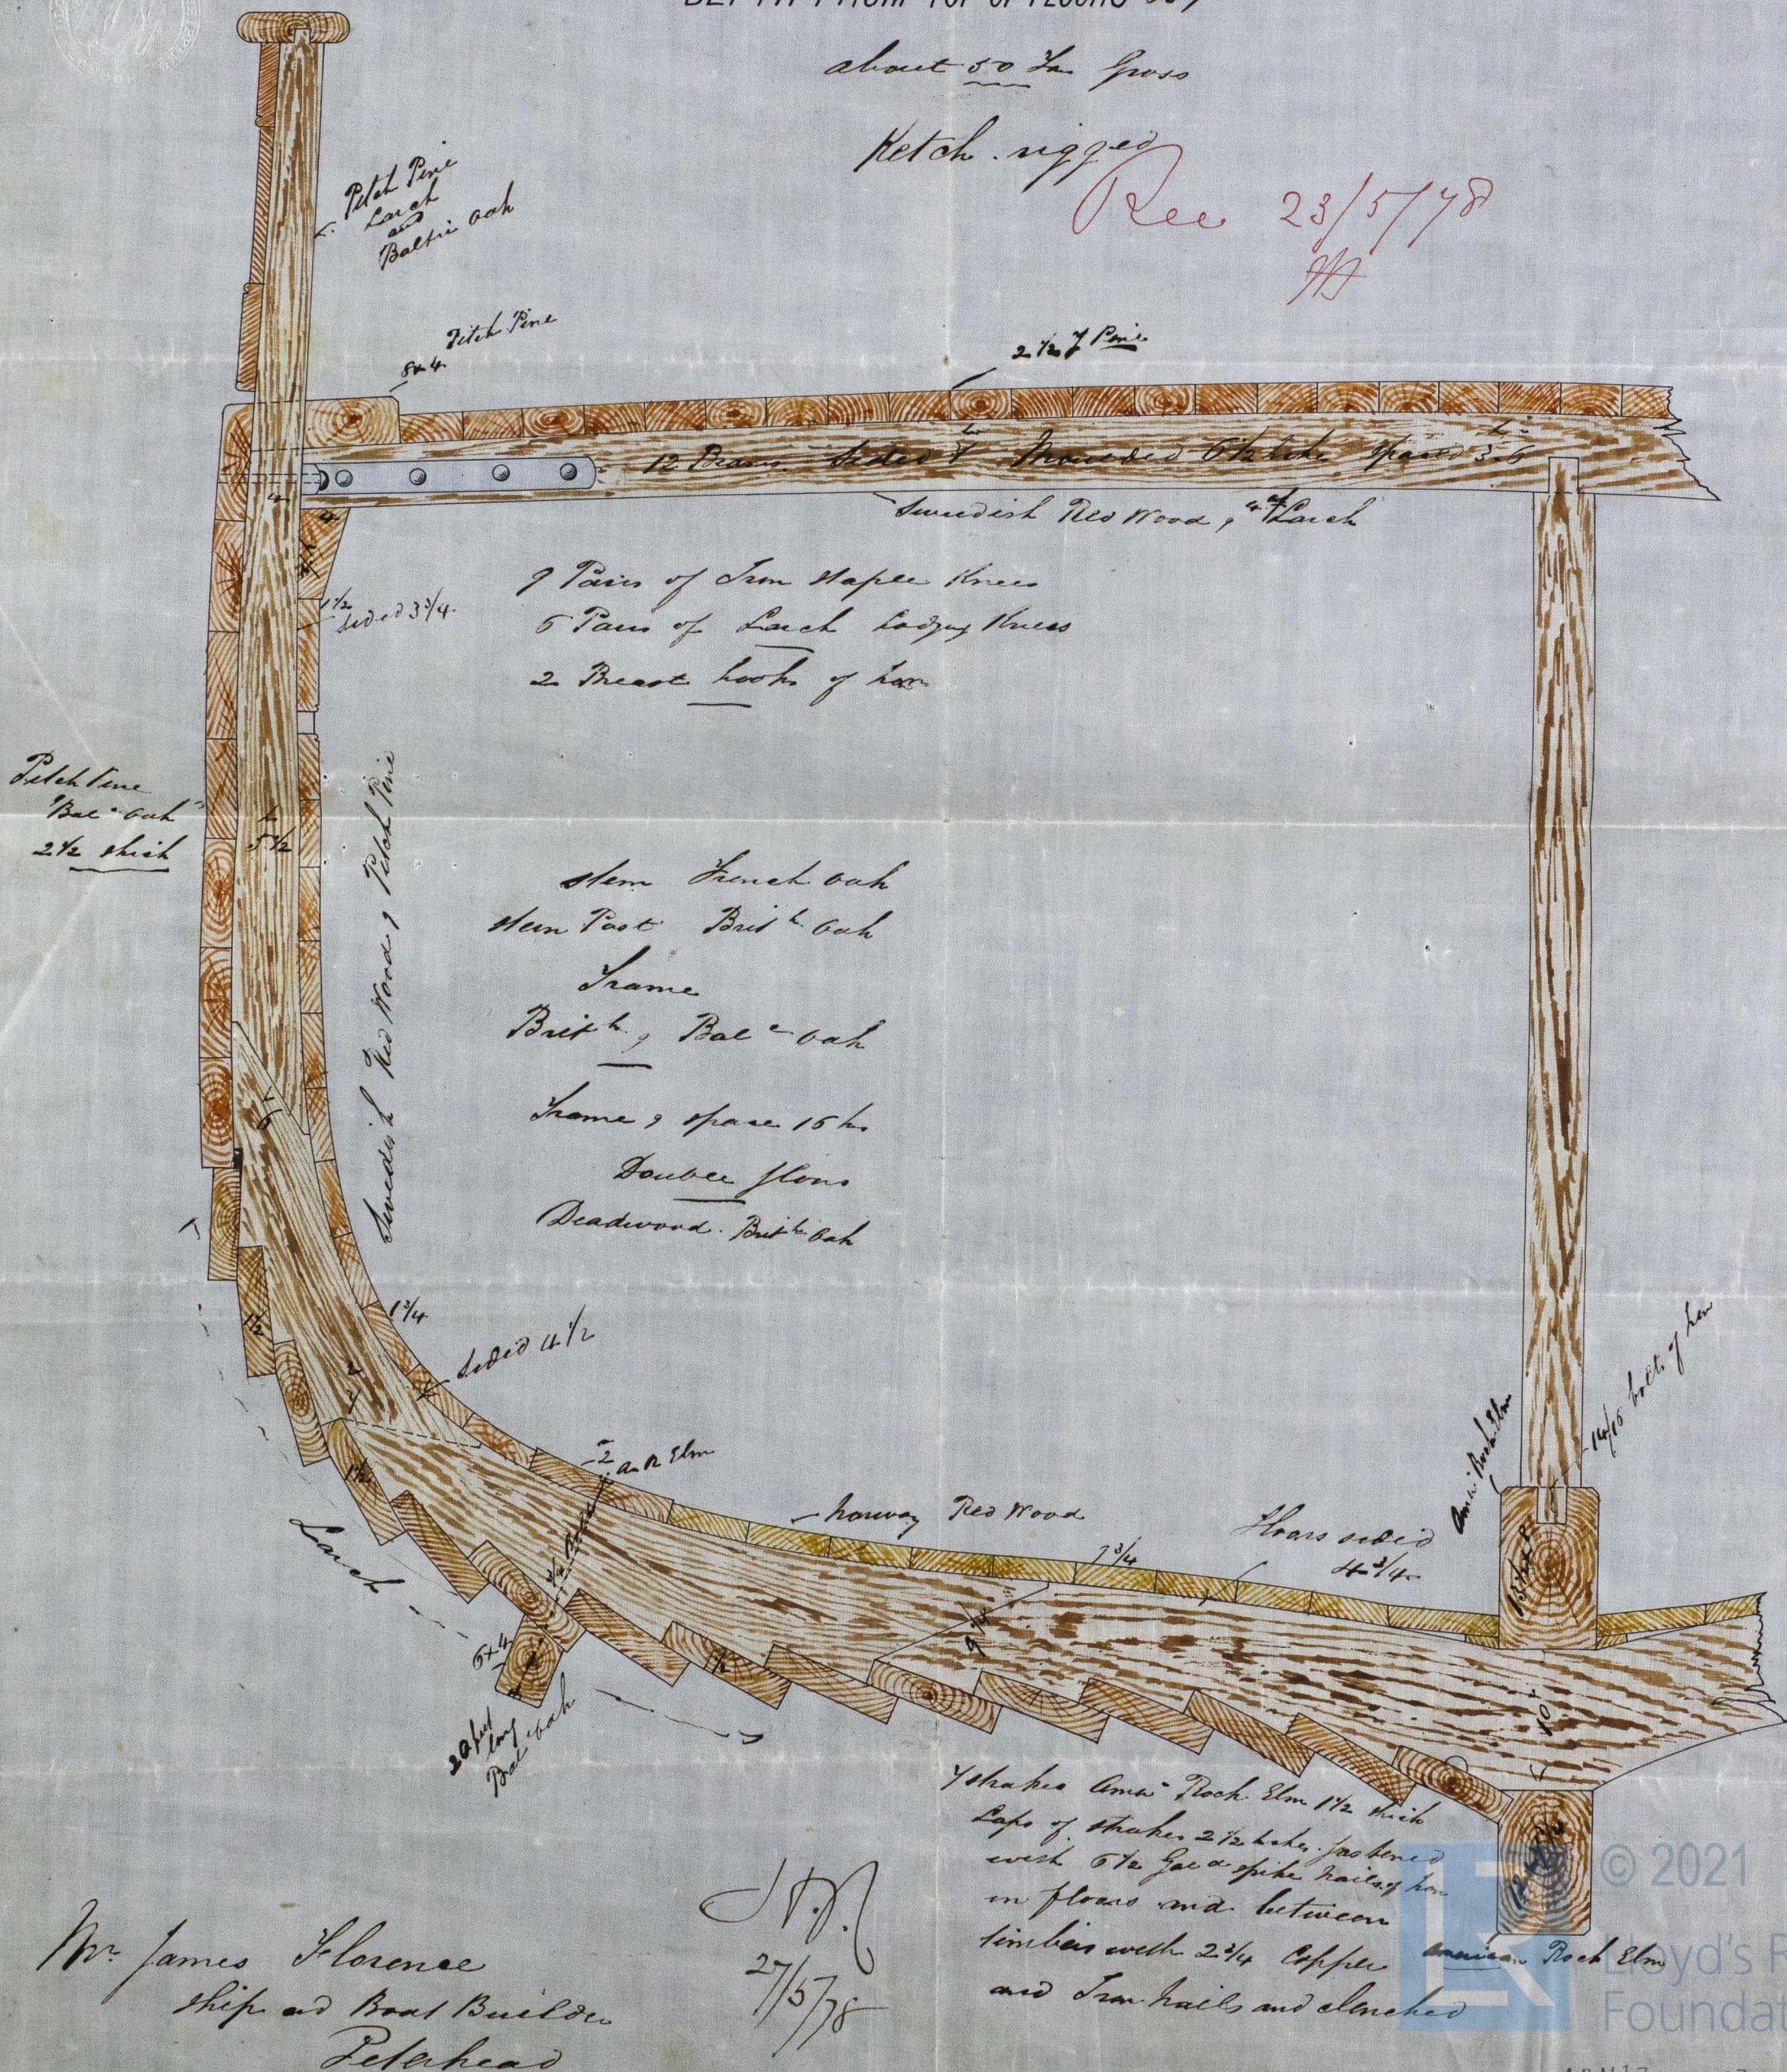

Mr. James Florence
Ship and Boat Builder
Peterhead

J.F.
27/5/78

Shakes Am. Rock Elm 1 1/2 thick
Laps of shakes 2 1/2 inch, fastened
with 6 to 8 inch spikes nailed
in floors mid between
timbers with 2 3/4 copper
and iron nails and clinched

© 2021
Lloyd's Register
Foundation

ABN17-0103