



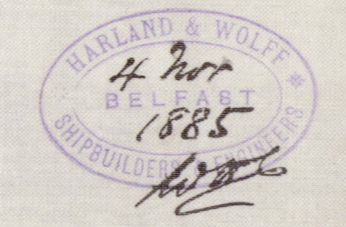

*ditto to Belfast
10/11/85.*

*D.R.
Pres. 9/11/85.*

— Nº 186. —
— PUMPING ARRANGEMENT —
Saint Tillans (now "Larne")
Belfast Report Nº 2212
Scale $\frac{1}{16}$ " = 1 ft

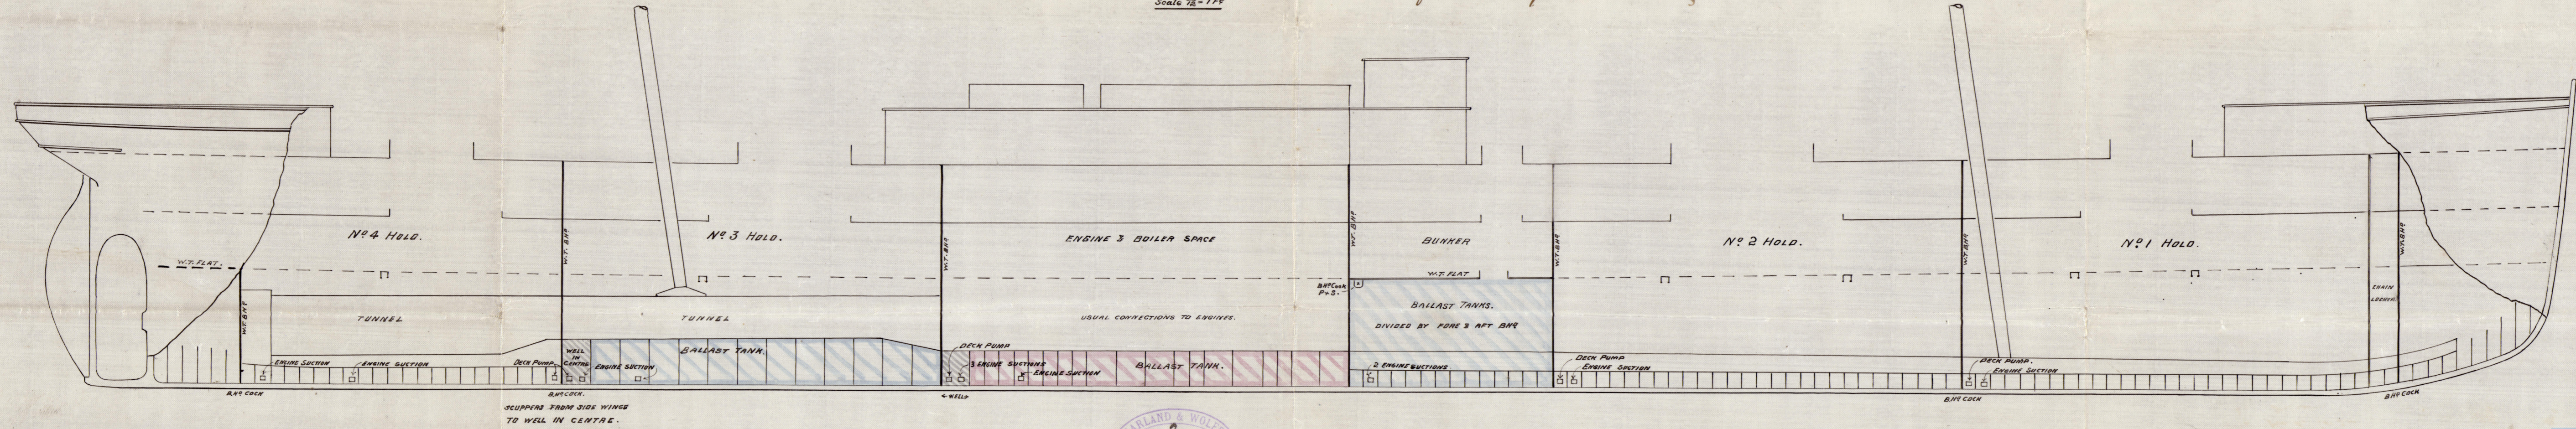

*D.R.
10/11/85*

6.11.86



© 2021
Lloyd's Register
Foundation

ABN17-0105