

2/5/78

Materials to be used in this vessel

Stem, apron, stem post, stanchion, French oak

19 ft. French oak

14 do. Scotch fir

1<sup>st</sup> fut 24 " " "

" 3 Larch

" 4 French oak

2<sup>nd</sup> fut 23 Scotch fir

" 11 French oak

" 4 Larch

3<sup>rd</sup> fut 22 Larch

50 of Larch

20 of French oak

Keel American Rock Elm

Kelson Pitch Pine

Deadwood Pitch Pine & French oak

Beams, Larch, Pitch Pine

Watways French oak, Pitch Pine

Deck string w. Pitch Pine

all ceiling Pitch Pine

Covering boards Bat oak

Upside planking Bat oak

or Pitch Pine

The remainder of outside planking Pitch Pine

Fells binder & sides of beams, Larch Loopy knees at ends


8 Pairs of diagonal plates

outside same 3 ft x 4 ft

4 Pairs of long large knee pieces

4 L  
46 x 21.5 x 9.4

Large press 80 lbs 5 x 9

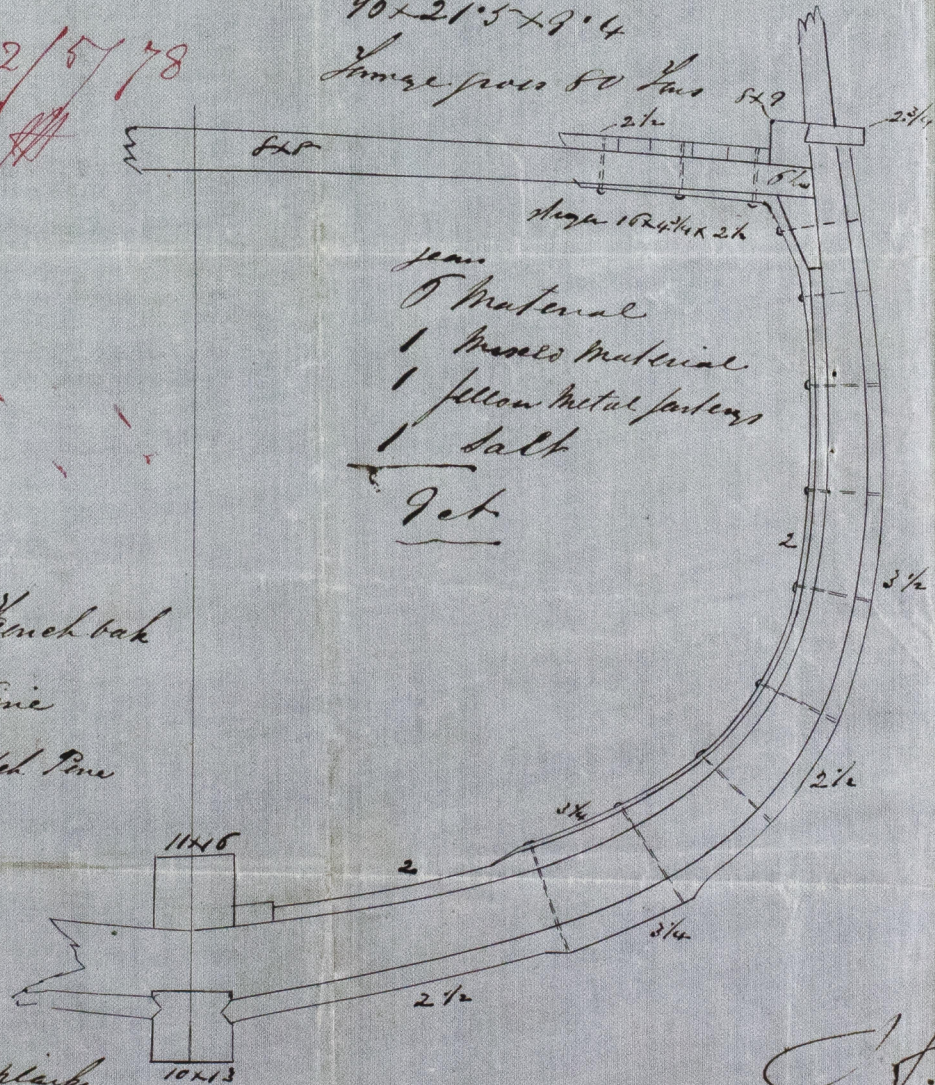

year  
0 Material  
1 Moulds Material  
1 yellow metal fastenings  
1 salt

9 ft

C.A.  
2/3/78

Wm. Smith & Ritchie  
Portsmouth