

Received at *Belfast* Office, *Nov-16th* 18*05*

Lloyd's Register of British and Foreign Shipping.

(Report on Vessel No. *186* Port *Belfast*)

No. *1046* SHIP FORGINGS OR CASTINGS.

The words FORGINGS or CASTINGS, IRON or STEEL, should be struck out as may be required.

I have to report that the undermentioned Iron ~~or Steel~~ Forgings ~~or Castings~~, manufactured by *The Lancefield Forge Co.* of *Glasgow*.
 for the Vessel No. *186*, being built by *Messrs Harland & Wolff*.
 of *Belfast*. have been inspected by me as set forth below, and found
 to be, so far as can be seen, *sound and efficient*.


Mark on Forgings.

Lloyd's
 No. *1046*
G. N.

George Newcomb
Glasgow. *14/11/85.*

	STERN FRAME.	RUDDER FRAME.	STEM.
Material*	/	<i>Scrap iron</i>	/
How made		<i>Forged</i>	
Dimensions		<i>8 1/2 dia</i>	
Progress on Inspection		<i>Forging & smithing</i>	
Dates when Inspected		<i>5.25.28.30/9/85.3.9.23.30/10/85 2.6.10/11/85.</i>	

SKETCHES OF FRAMES SHEWING POSITION AND DESCRIPTION OF WELDS OF FORGINGS, OR PARTICULARS OF TESTS APPLIED TO CASTINGS.

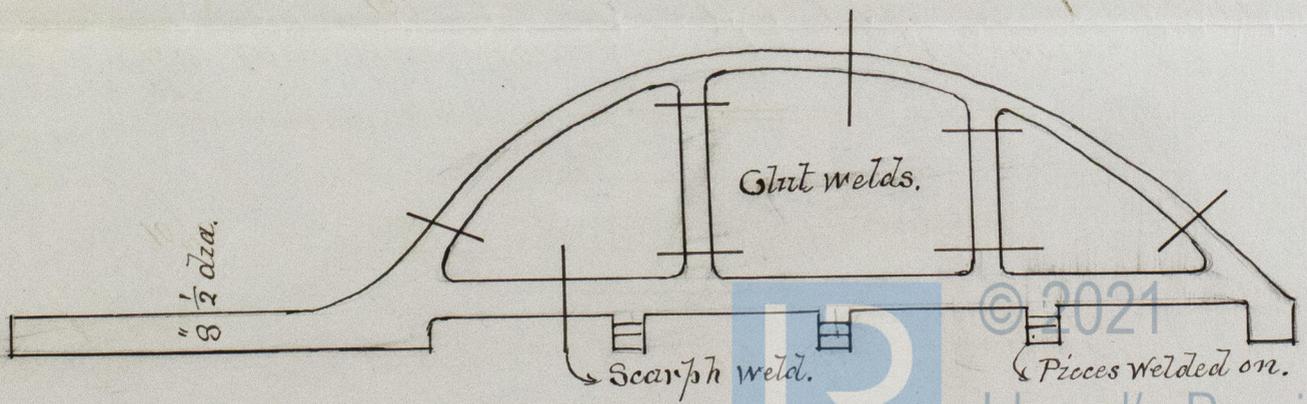

* If of Iron, state whether scrap or puddled Iron.

