


RECEIVED FEB. 82.

MIDSHIP SECTION

of
S.S. Express

DIMENSIONS

LENGTH BETWEEN PERPENDICULARS	102
BREADTH EXTREME	18.85
DEPTH IN HOLD	10.5

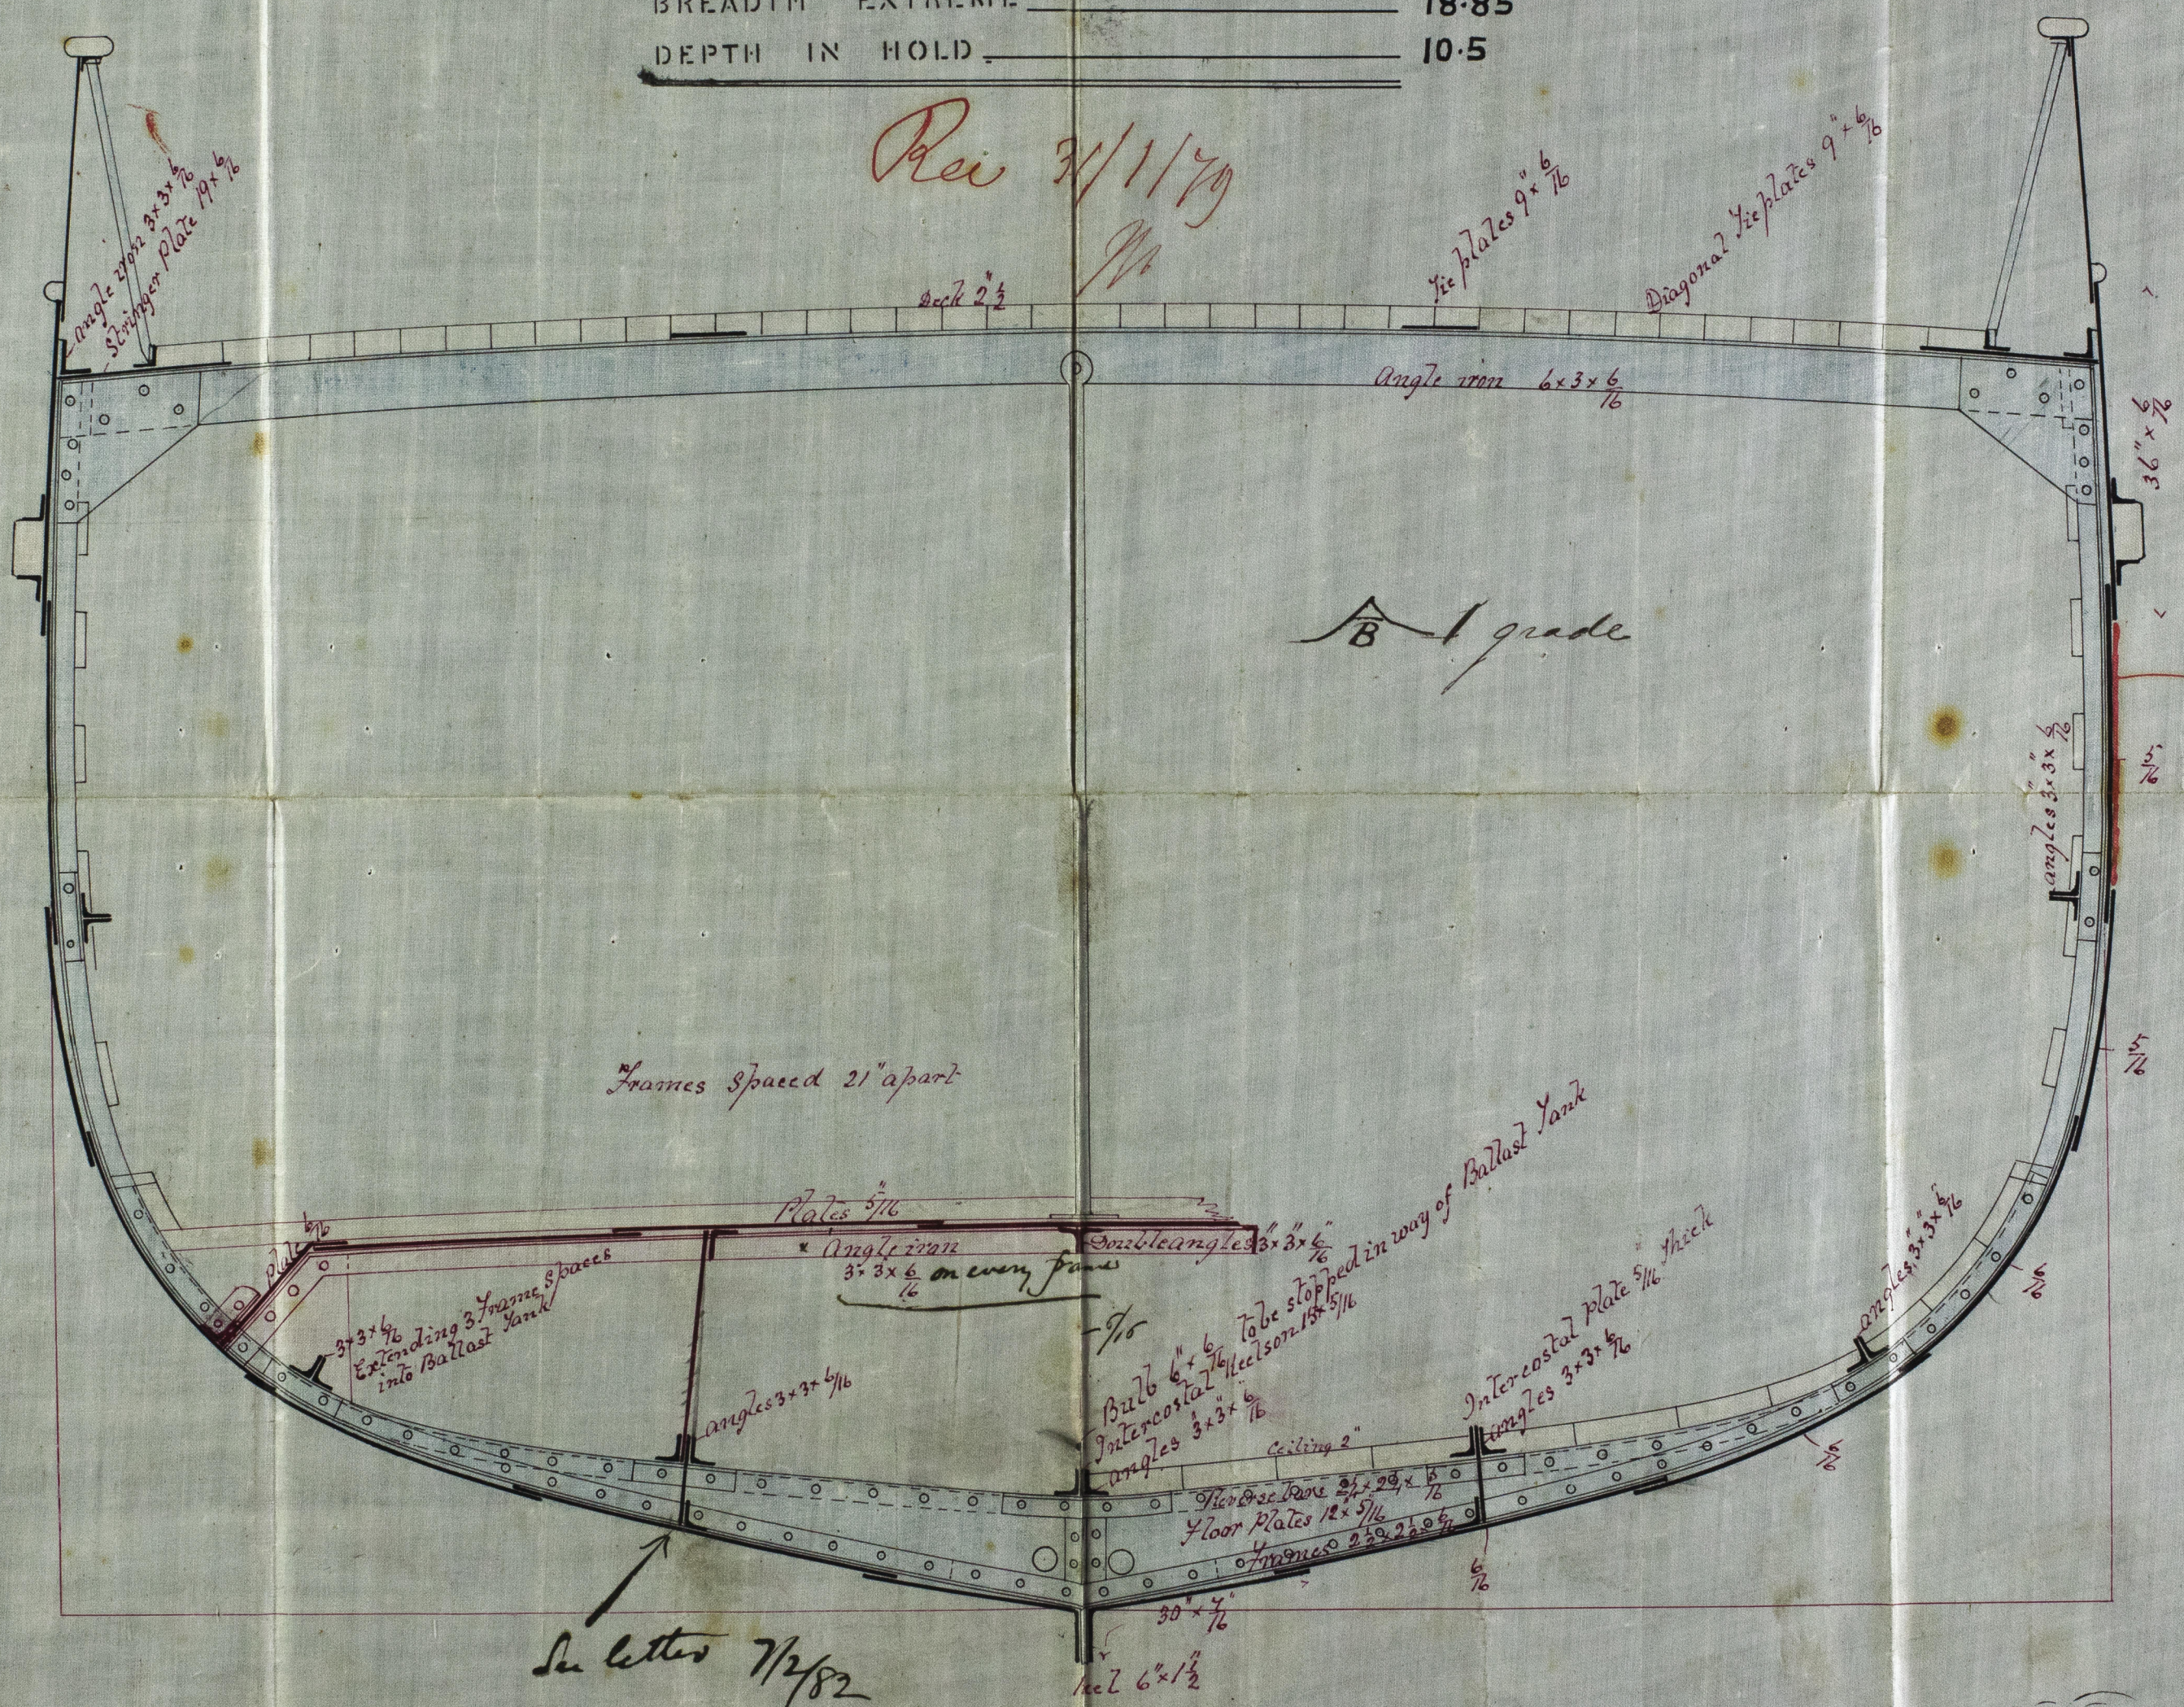

Rec 3/1/79

B grade

*Doubled with 9/16
plating for
100 feet amidships*

See letter 7/2/82

SCALE 3/4 INCH TO A FOOT

Alexander Hall & Co
Shipbuilders
ABERDEEN

*J.H.
1/2/79*