Dr. to Dundee
18/10/87.

PROPOSED.

DONKEY BOILER.

No 227

WORKING PRESSURE 80 LBS PER □"

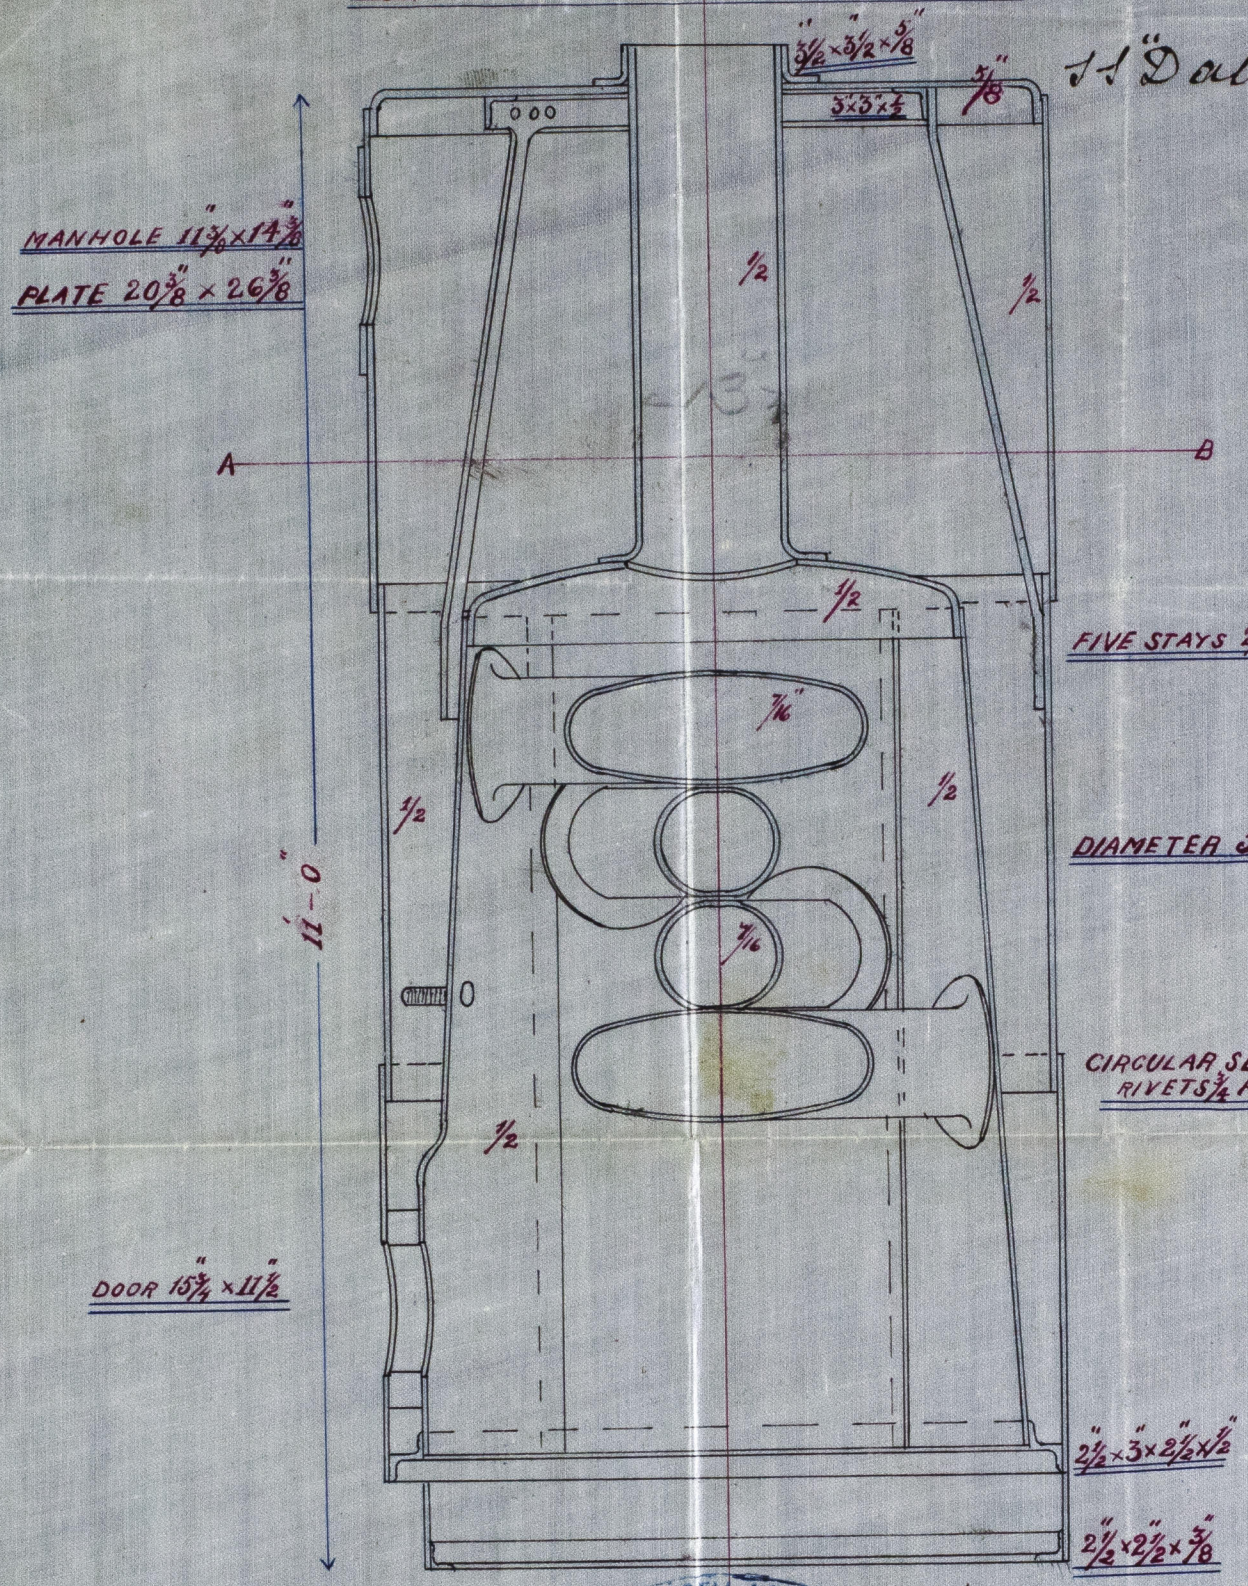

S.S. "Dabulamanzi"
Aberdeen
7/6/82
E.S.

R. RUSSELL & Co ABERDEEN
ENGINEERS
AND IRON
SHIP BUILDERS

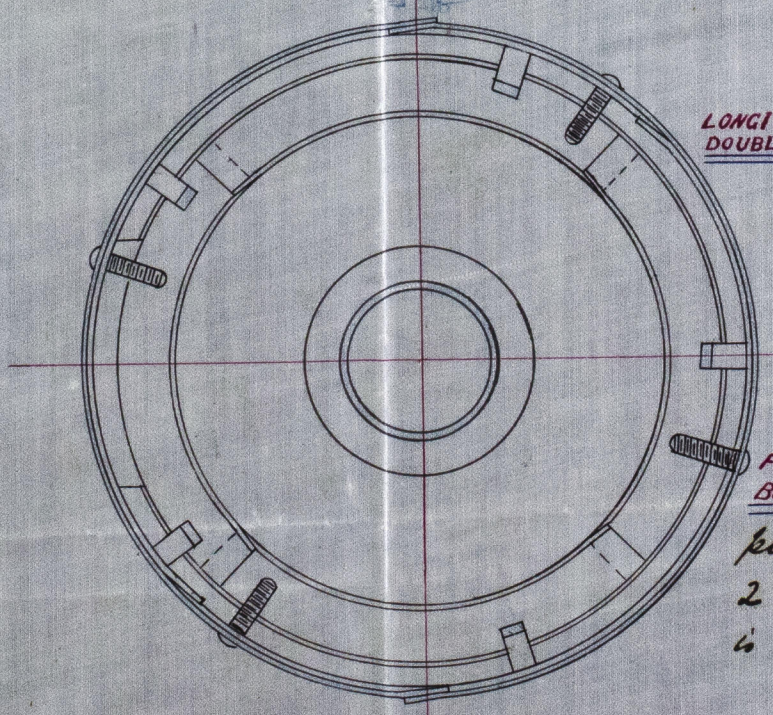

positions to be such that with 2 lower tube ends the furnace is supported all round

SECTION ON LINE A. B.

17/12/87

Scale 3/4 Inch to one Foot

Rec'd 14/10/87
E.S.

© 2011 Lloyd's Register Foundation
ABN 17-0115