


№ 227

*This boiler taken from the
% "Sabulamami" in Feb 1889 &
given on board % "Redgown"
(See Ann. p. 4080)*

DIAMETER 13"6"

WORKING PRESSURE 90 LBS □"

SCALE $\frac{3}{4}$ INCH TO ONE FOOT





double rivetted

Seam	75%
Rivets	77"
Shells	92 lb
central furnace	97 ~
$\frac{1}{2}$ length to iso	146 ~
Covering plates	113 ~
$1\frac{1}{2}$ Steel Saw Shps	6181 ~
End plate S. Stone	105 ~
Bolt Shps	5792 ~
Saw Shps 10x8 $\frac{1}{2}$	6187 - steel
Doubt	
Rivets	83 %
Seam	67 ~
Shells	123 lb
	<hr/>
	25.

E RIVETED.

$\frac{16"}{76}$

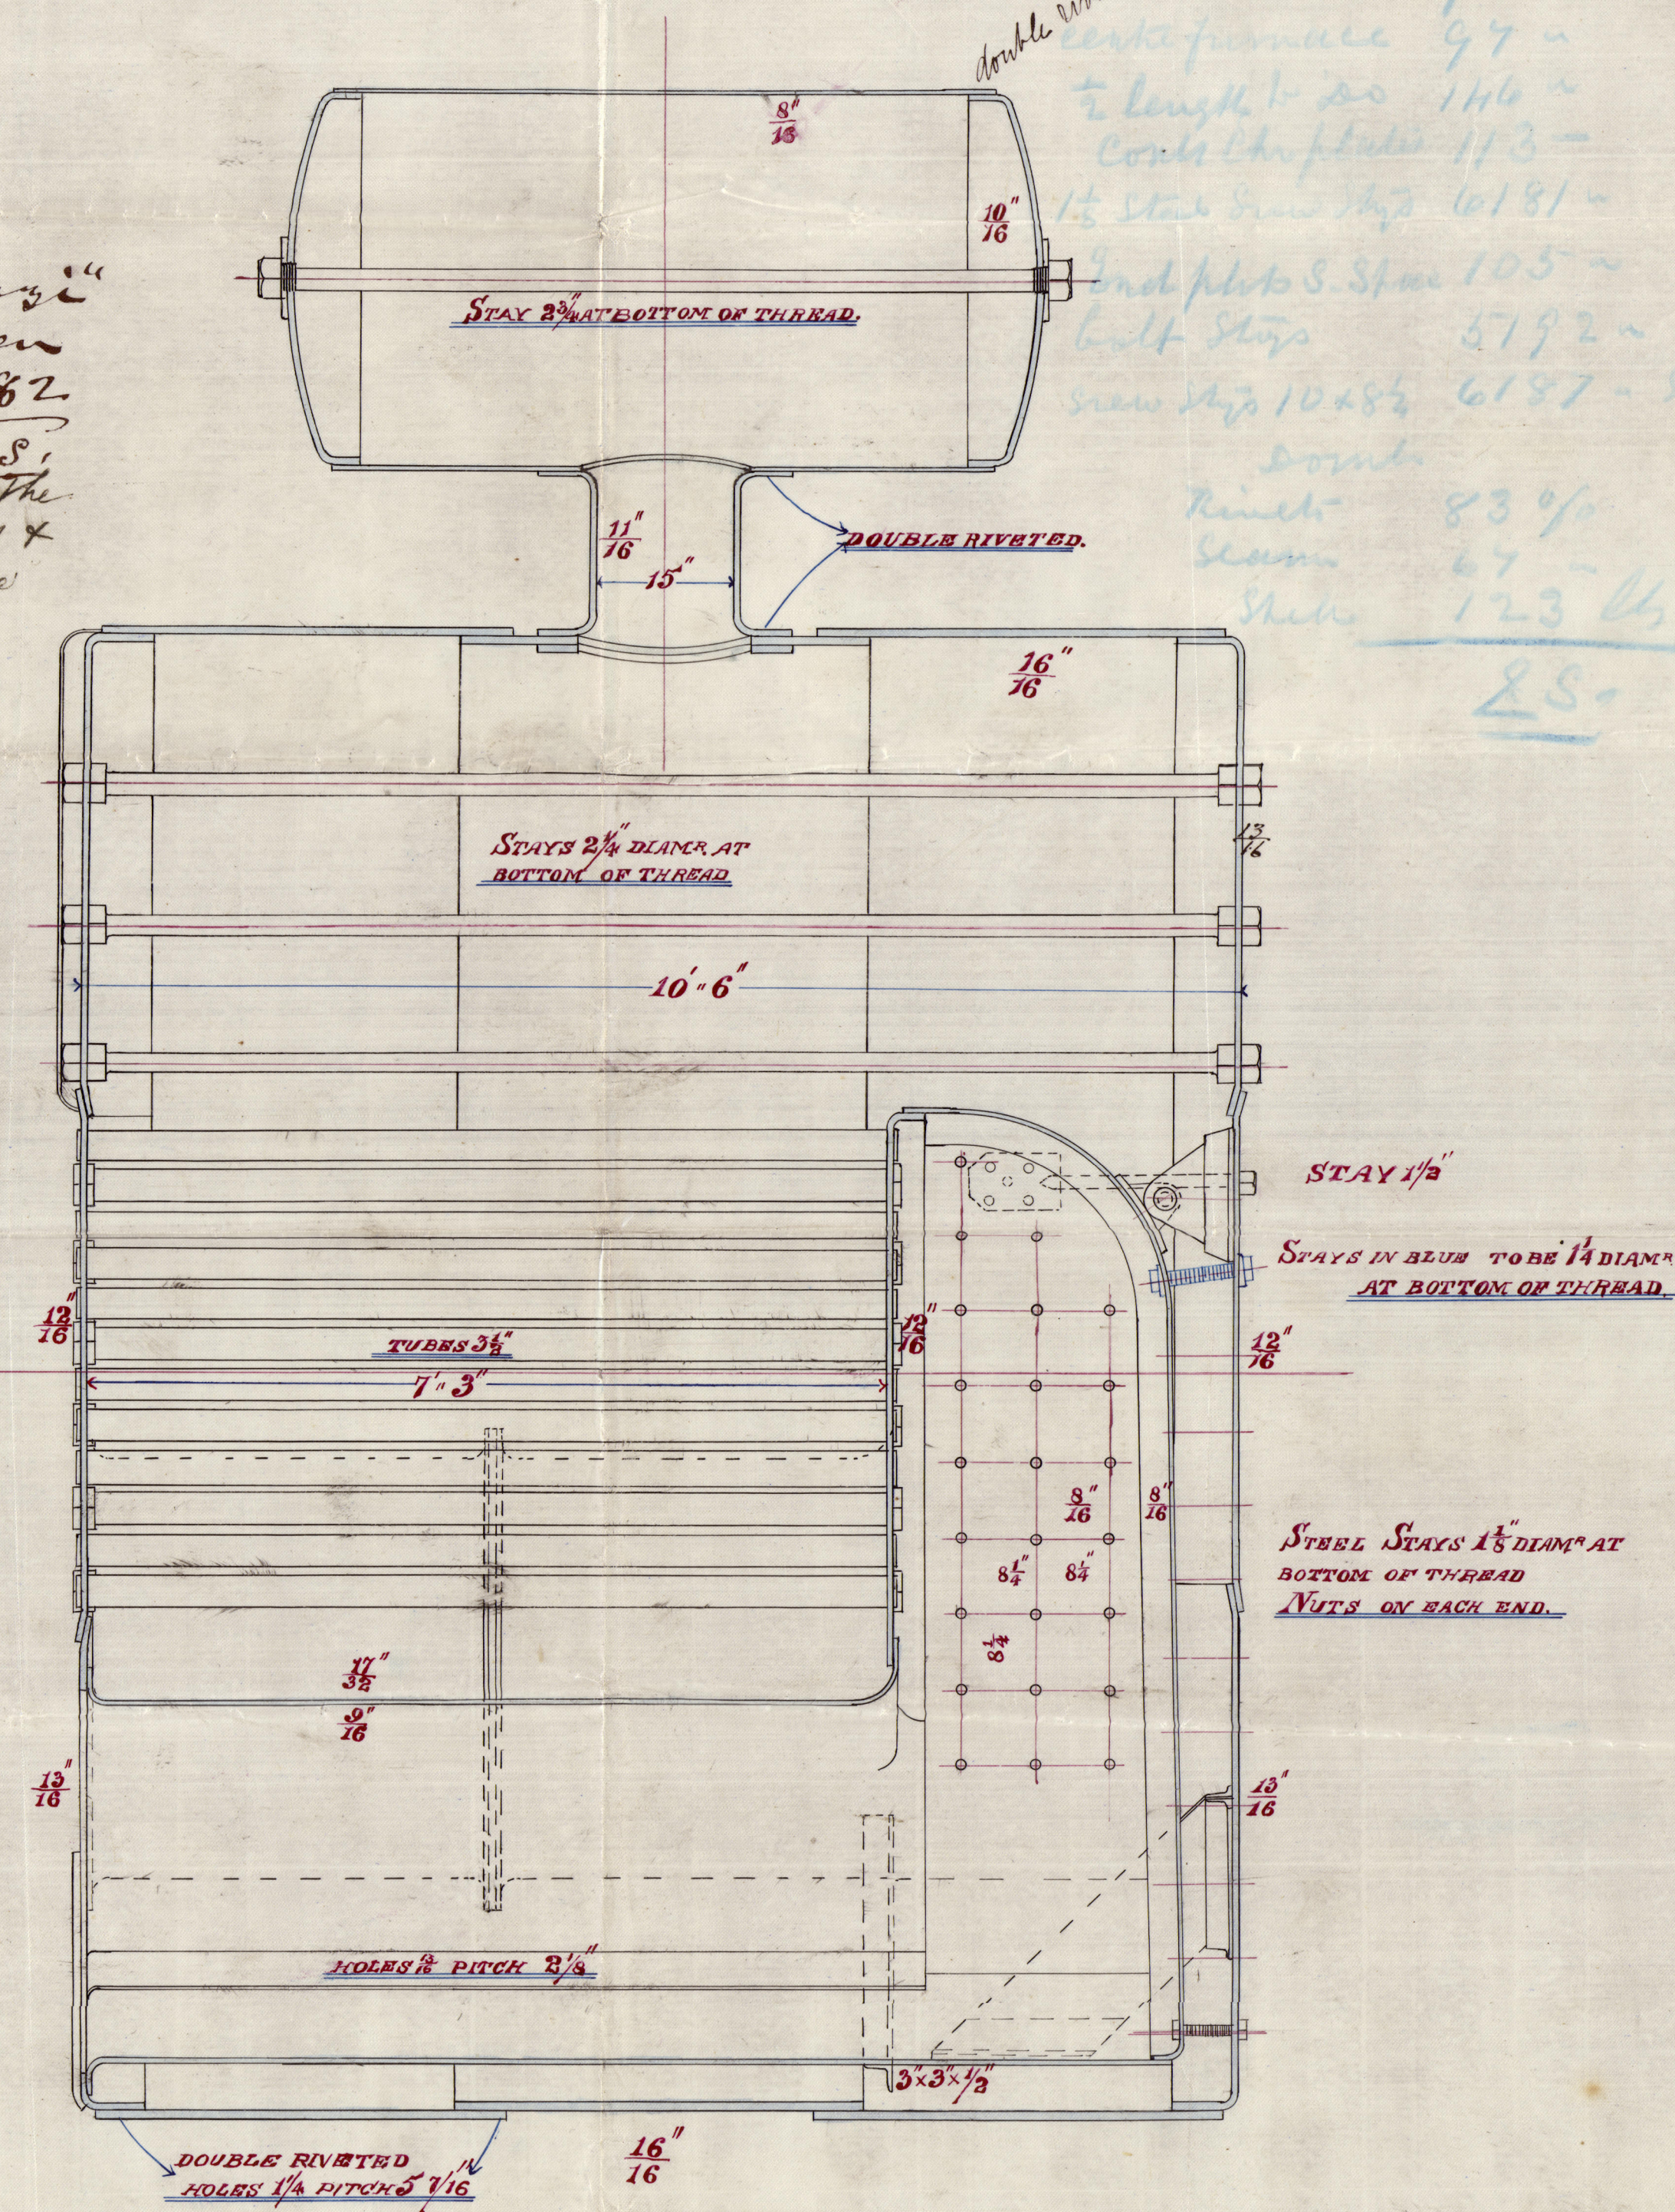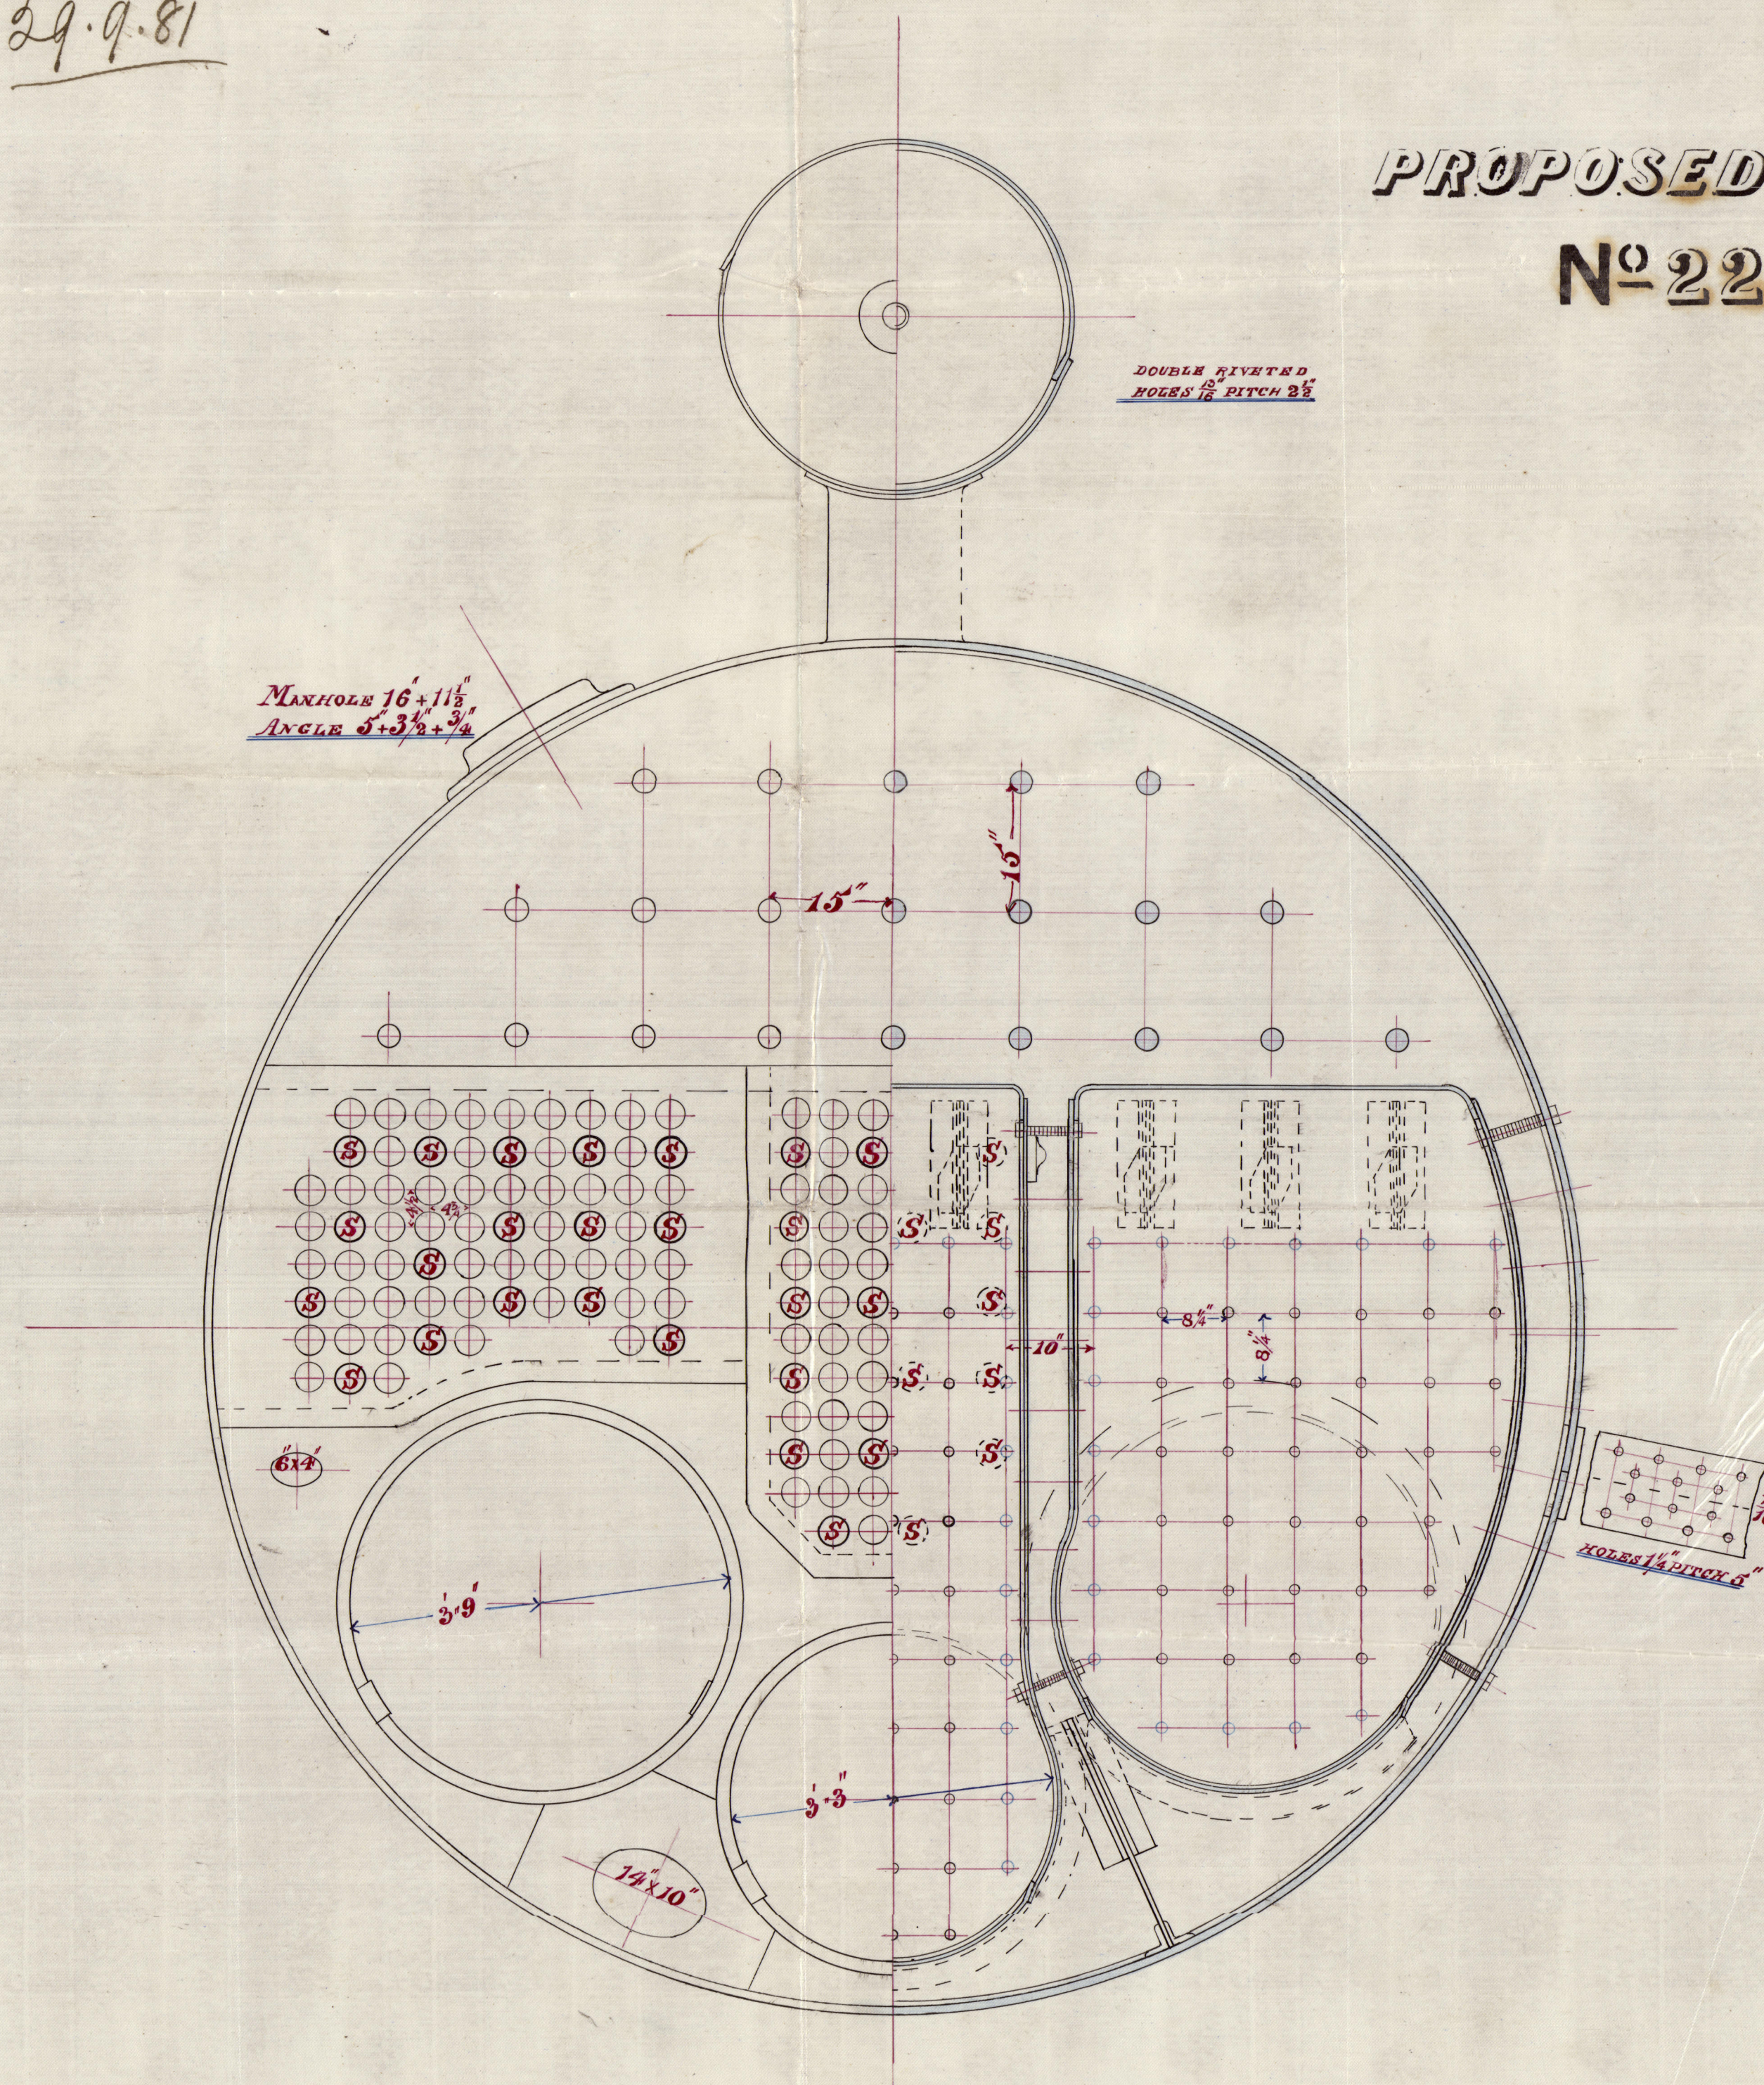

Reid
© 2026 26/9/81
J.M. 29/9/81
Lloyd's Register
Foundation

ARN 17-0181