


Str: to C. Wm.
14/3/83.

Wingiang
Aon 1476

14/3/83

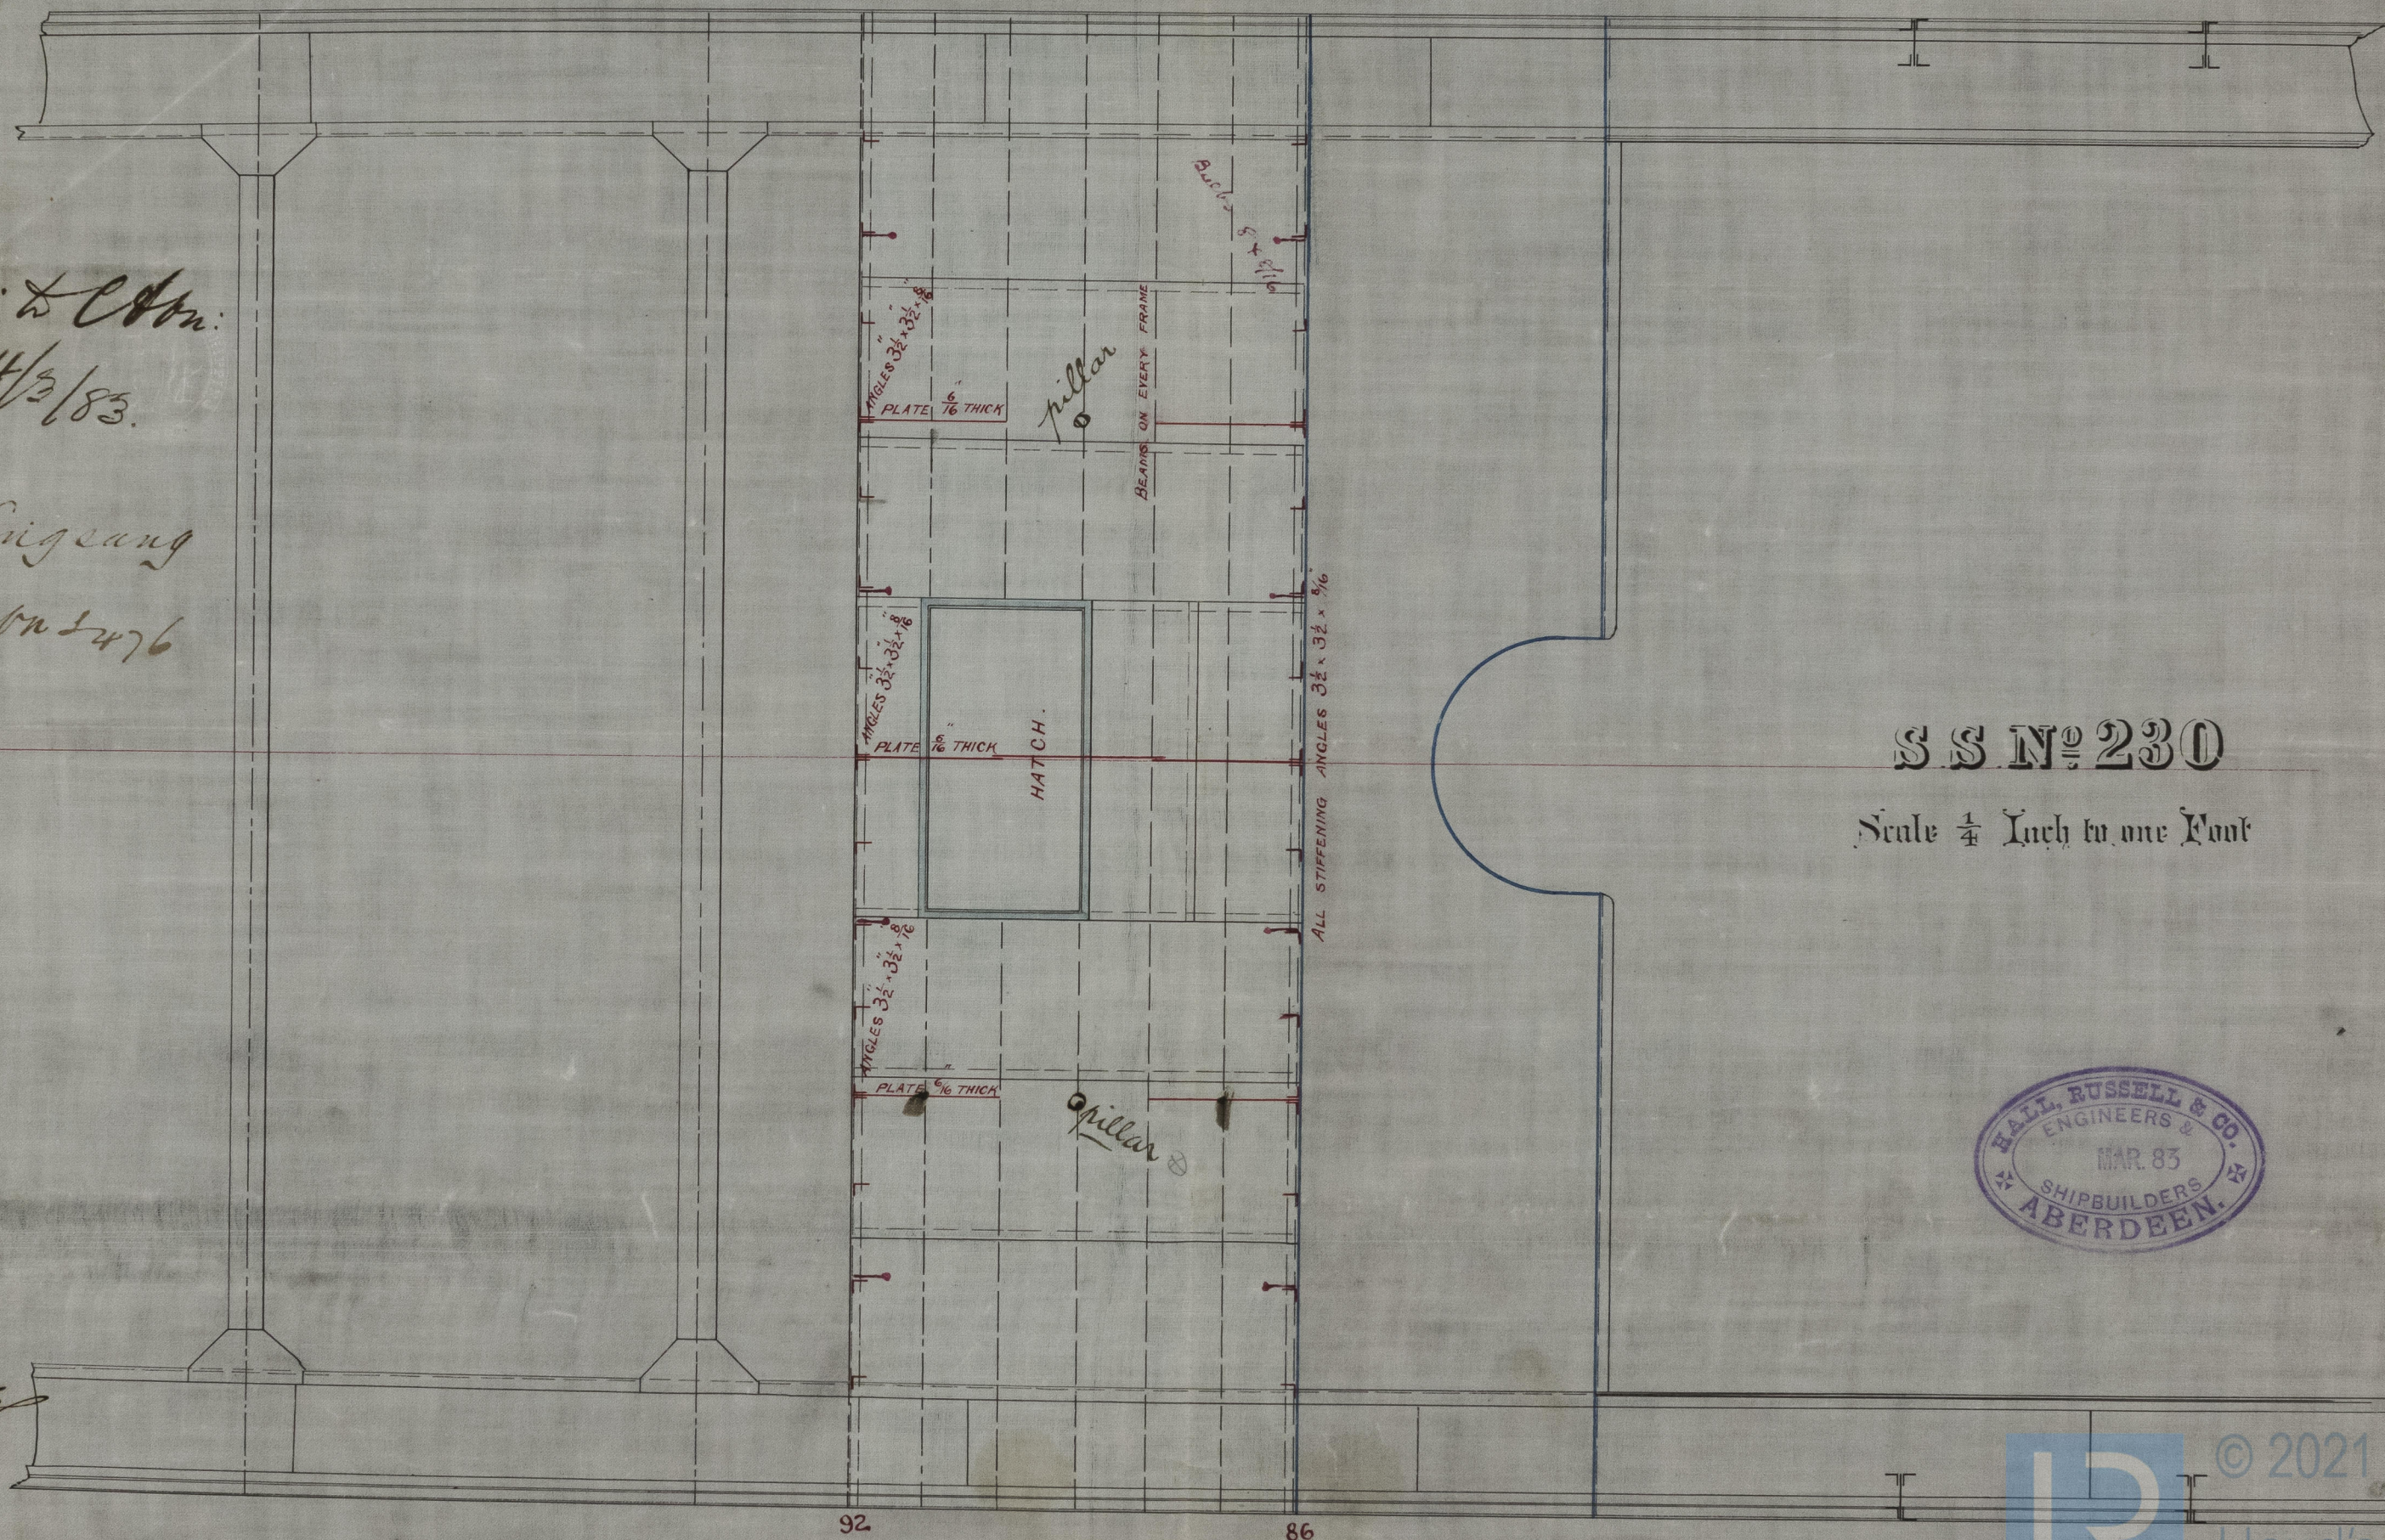

SS N^o 230

Scale $\frac{1}{4}$ Inch to one Foot

