


Somh  
Leom 130p  
Pineet 72 ~  
Shell 172 h  

---



9.51

**Nº 230**

SCALE  $\frac{3}{4}$  INCH TO ONE FOOT. Dundee report No 275

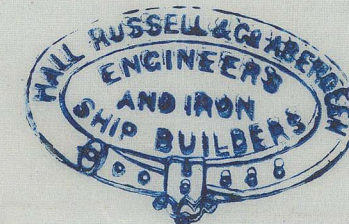

circle, seams of  
Holes in Shell to be punched  $1\frac{1}{8}$ " & annealed  
& drilled  $1\frac{1}{8}$ ".

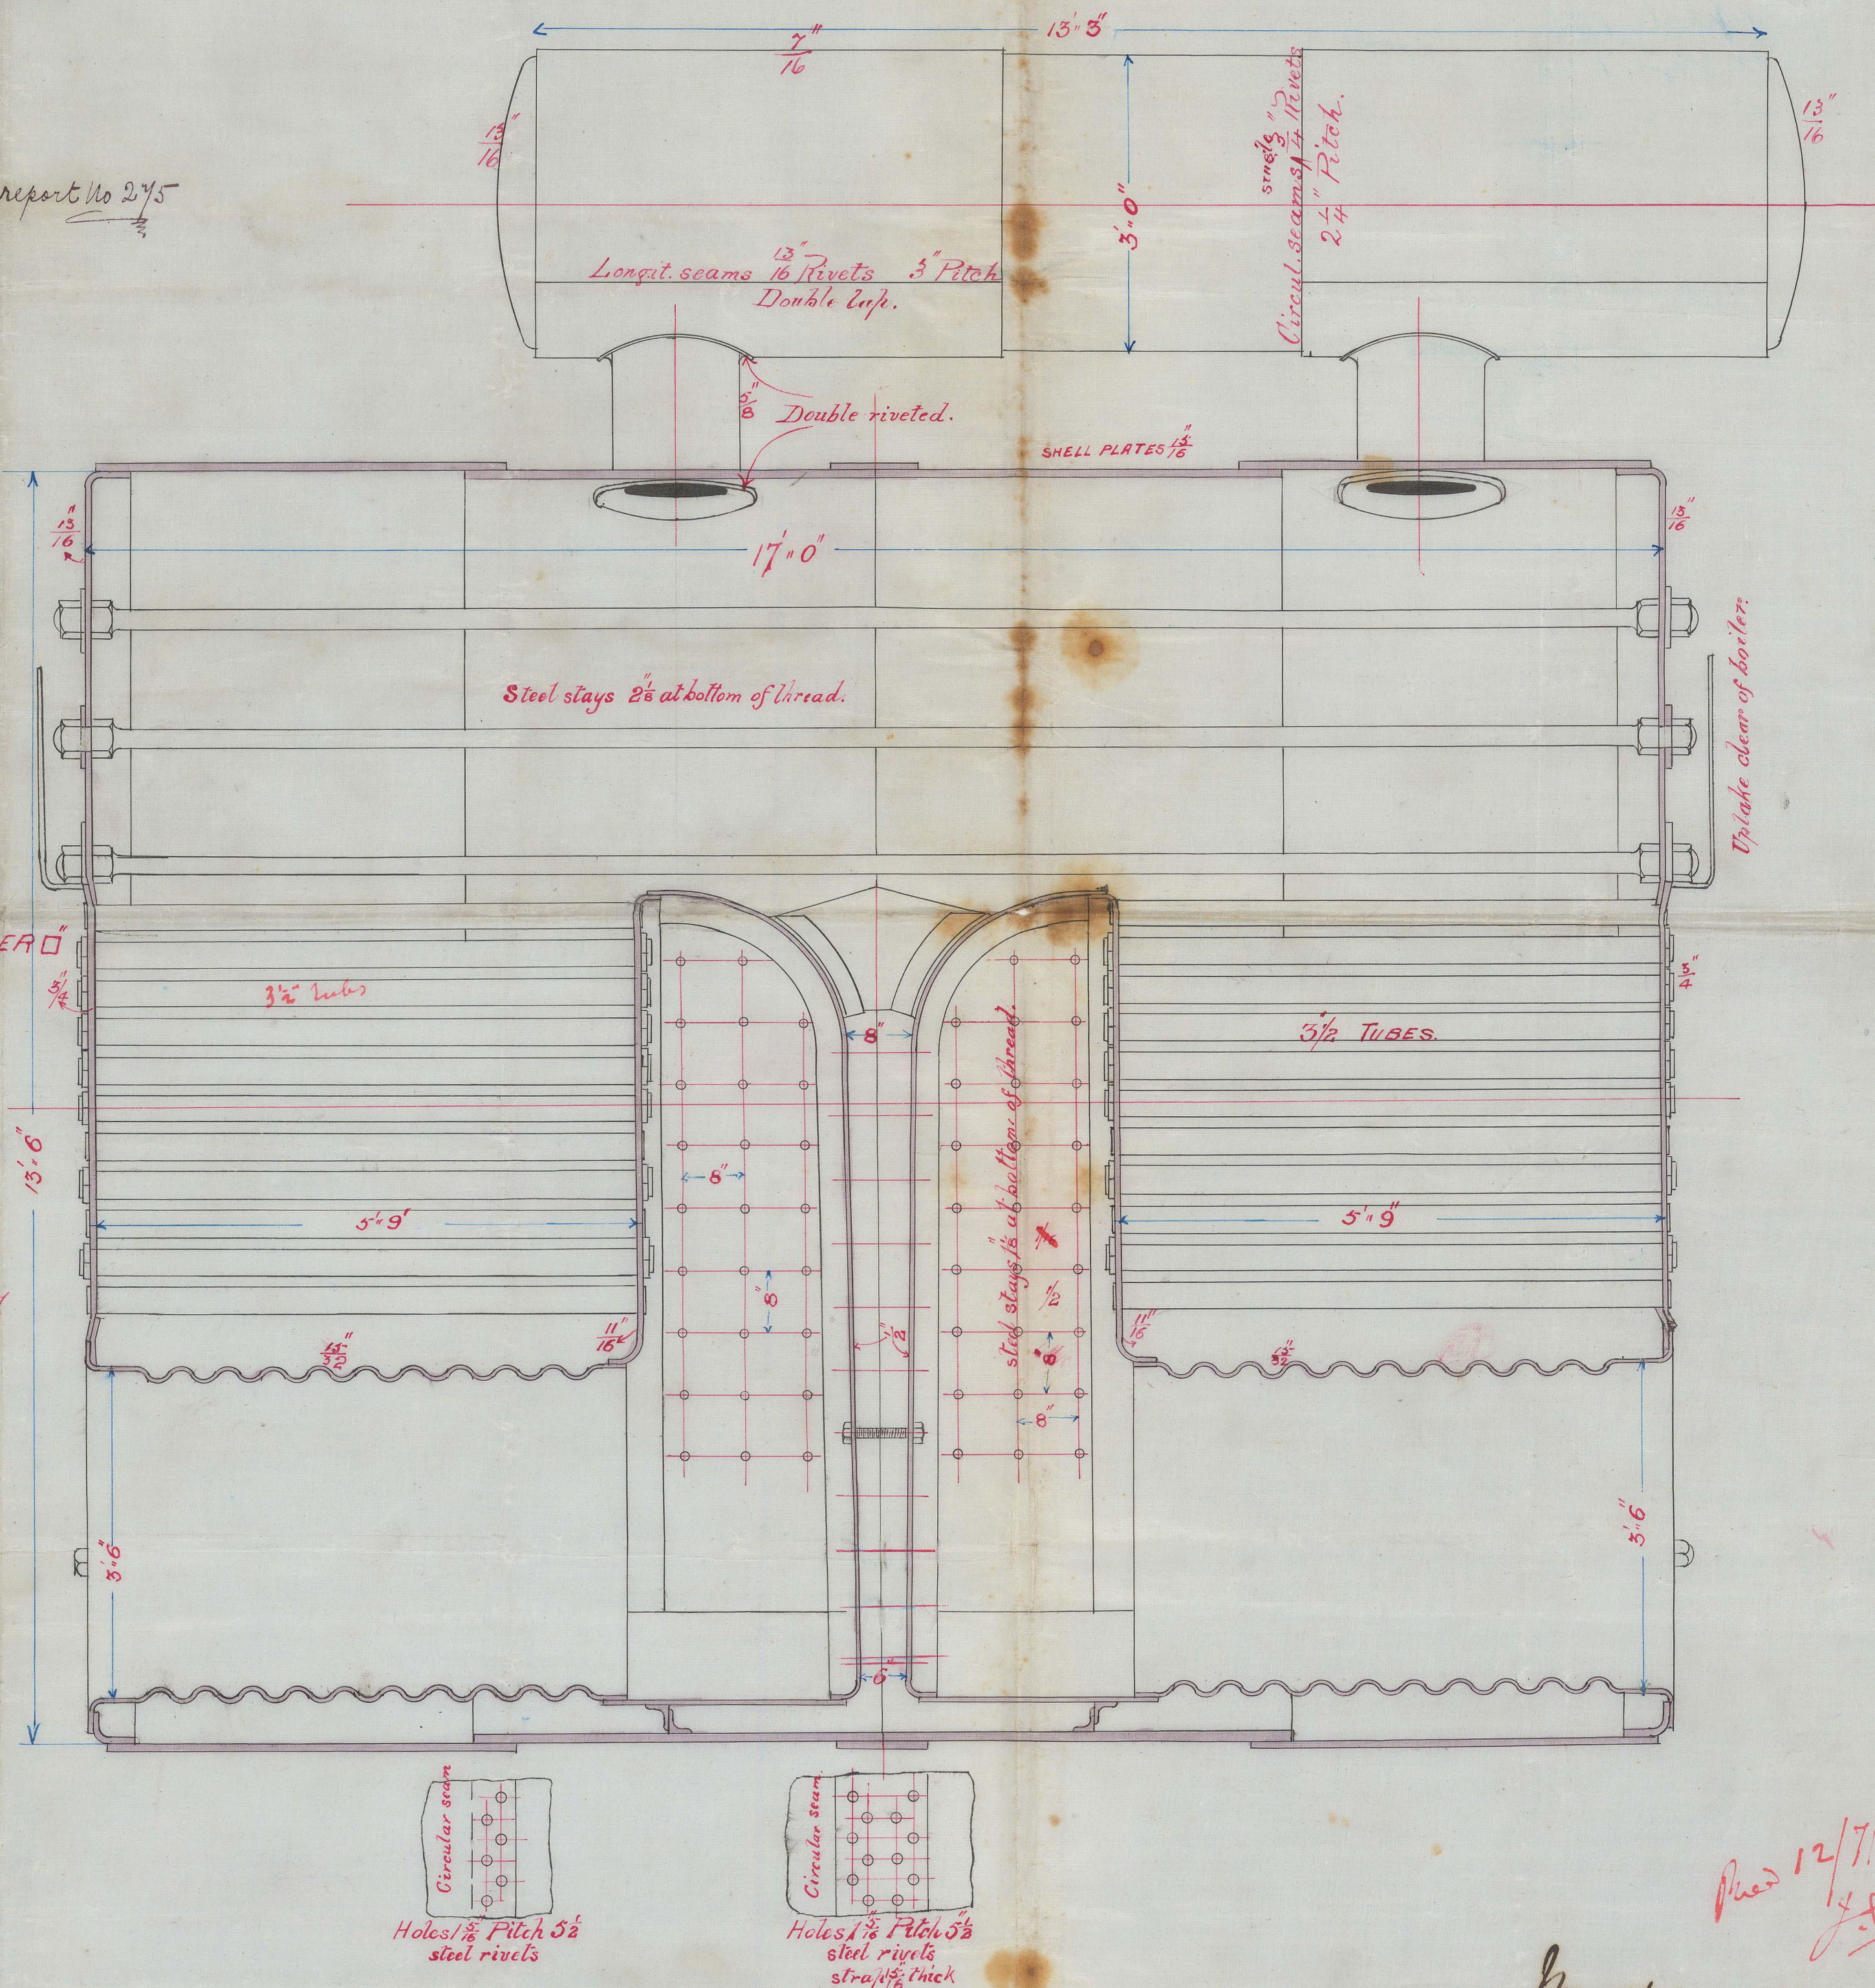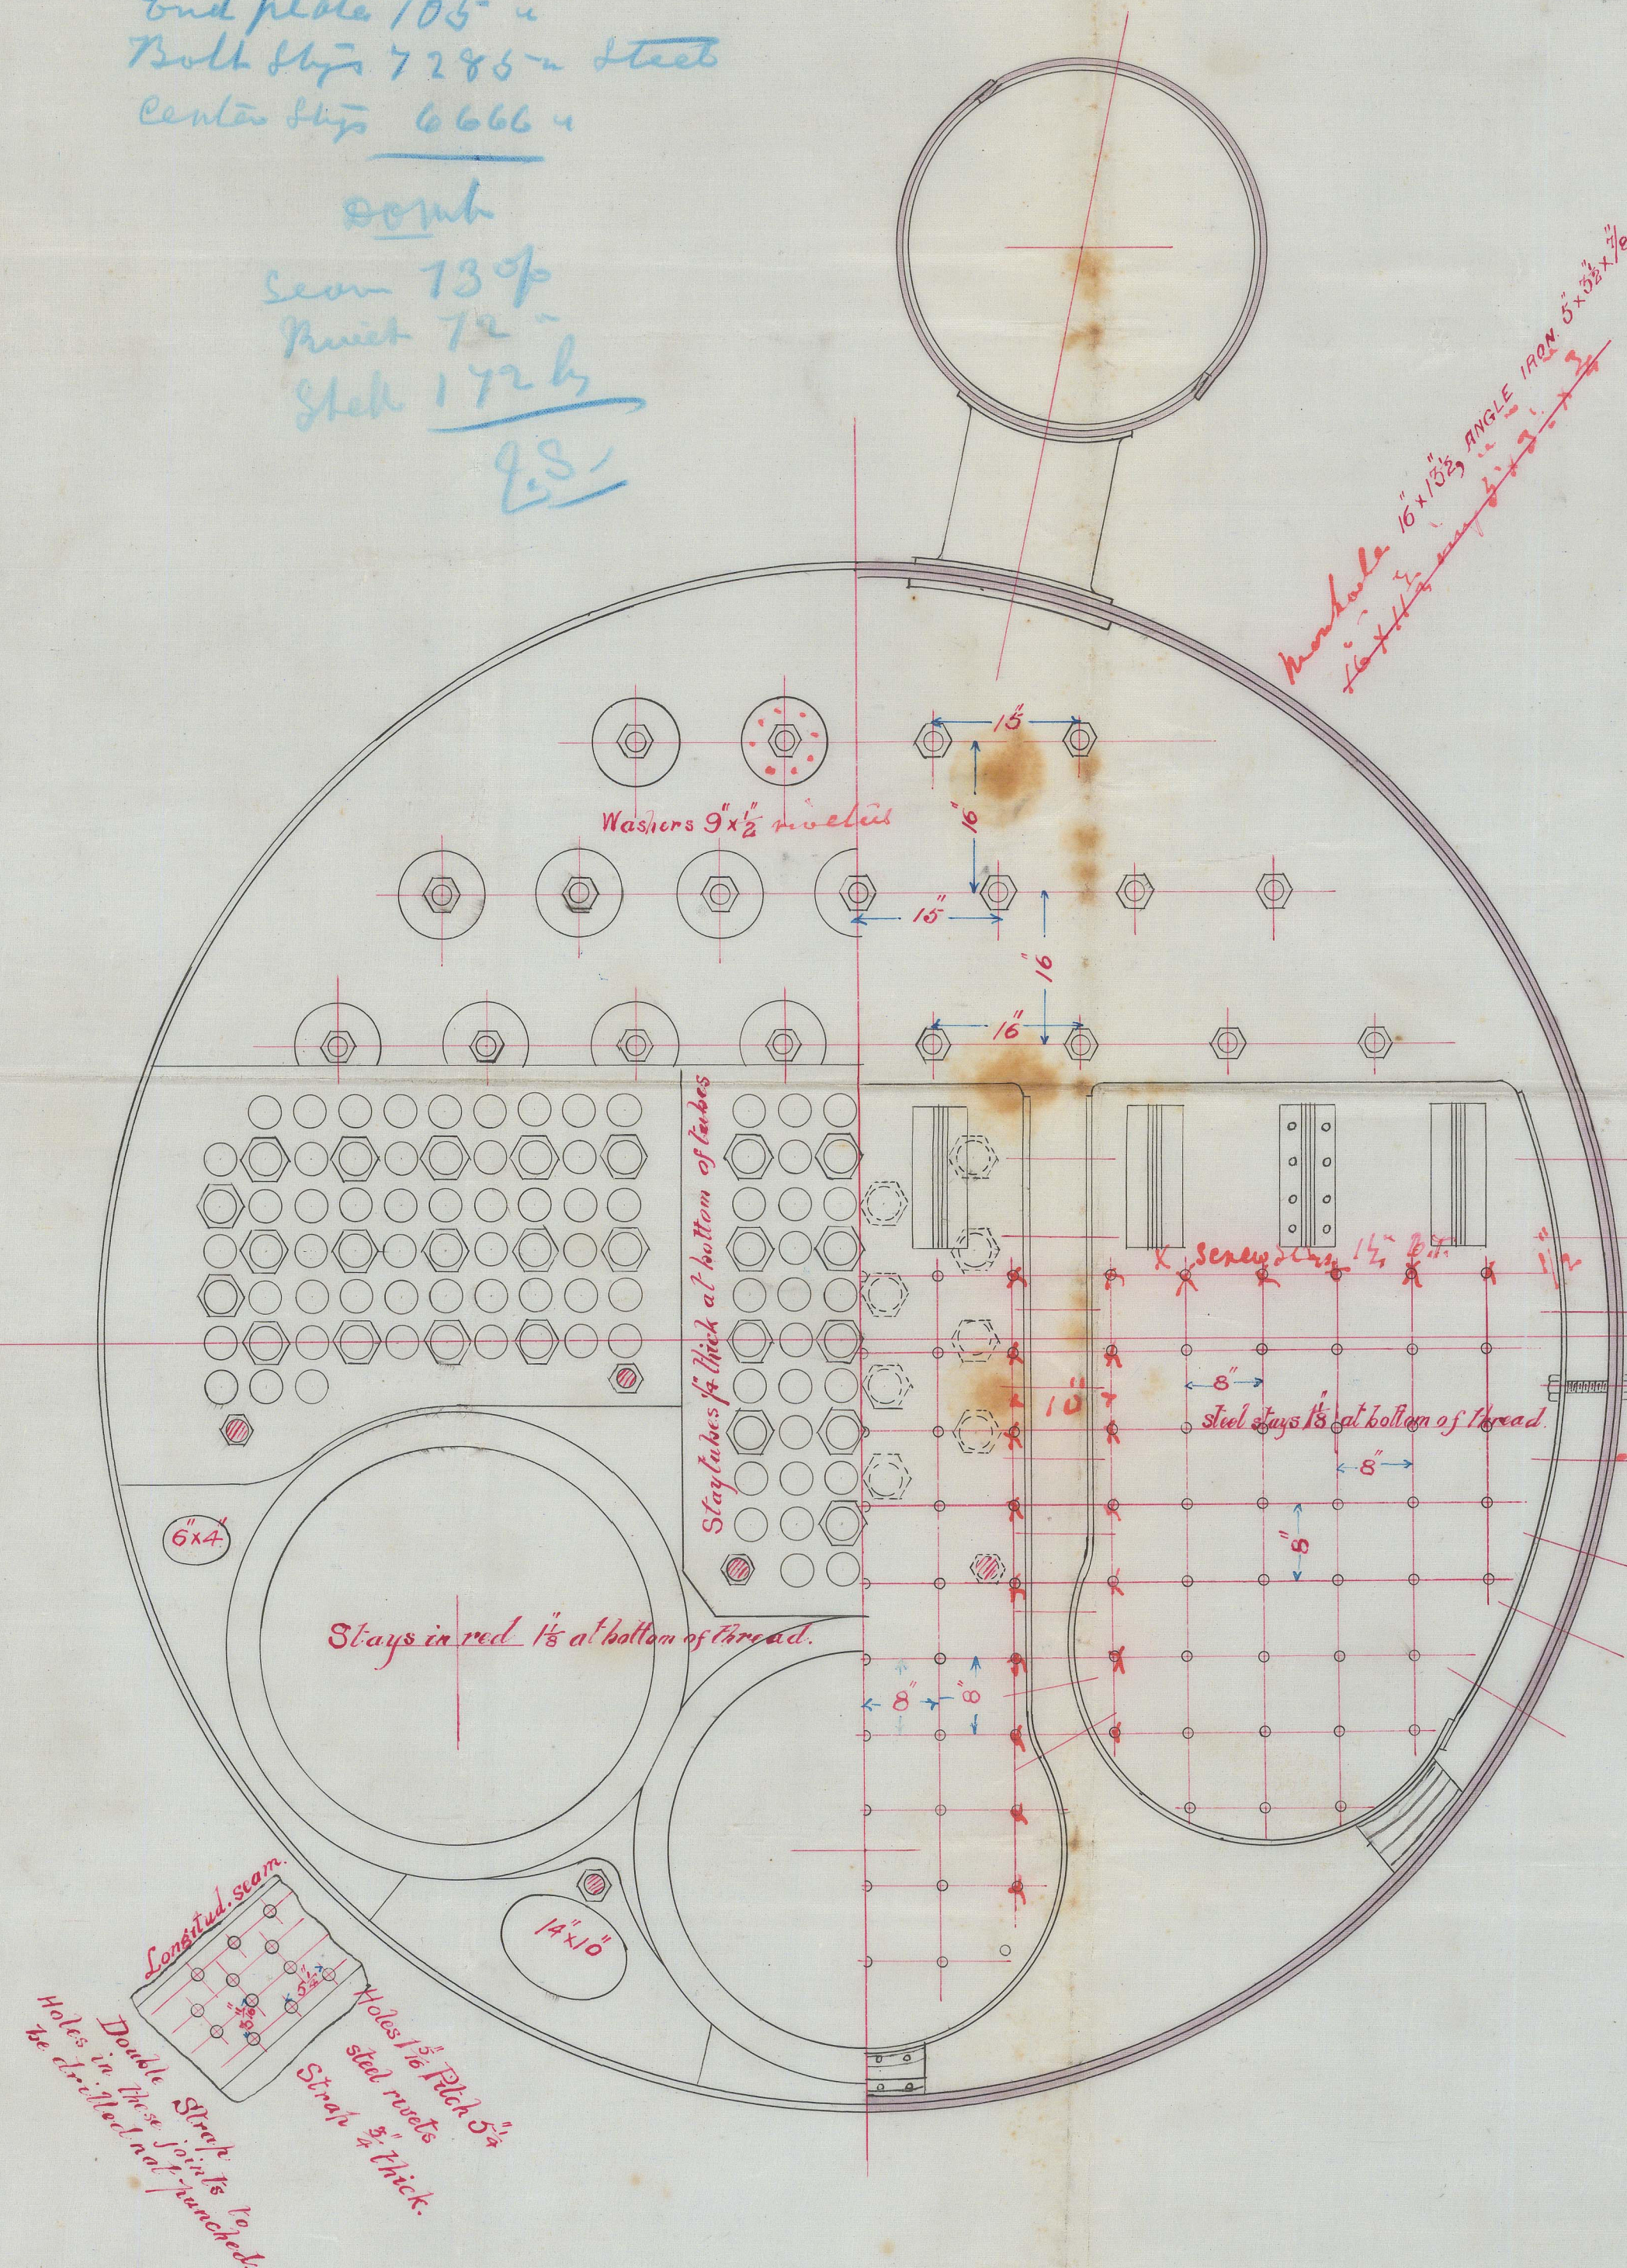

Recd 12/7/8

Im 15/7/8.



ABN18-1030

(Wing sang  
Apr 20 1876)

