


Let to Aberdeen
6/9/82.

"Gipsy"

"North Star"

Abn N^o 3488.
3489

S.S. Gipsy
carried up to red line
22/3/87.

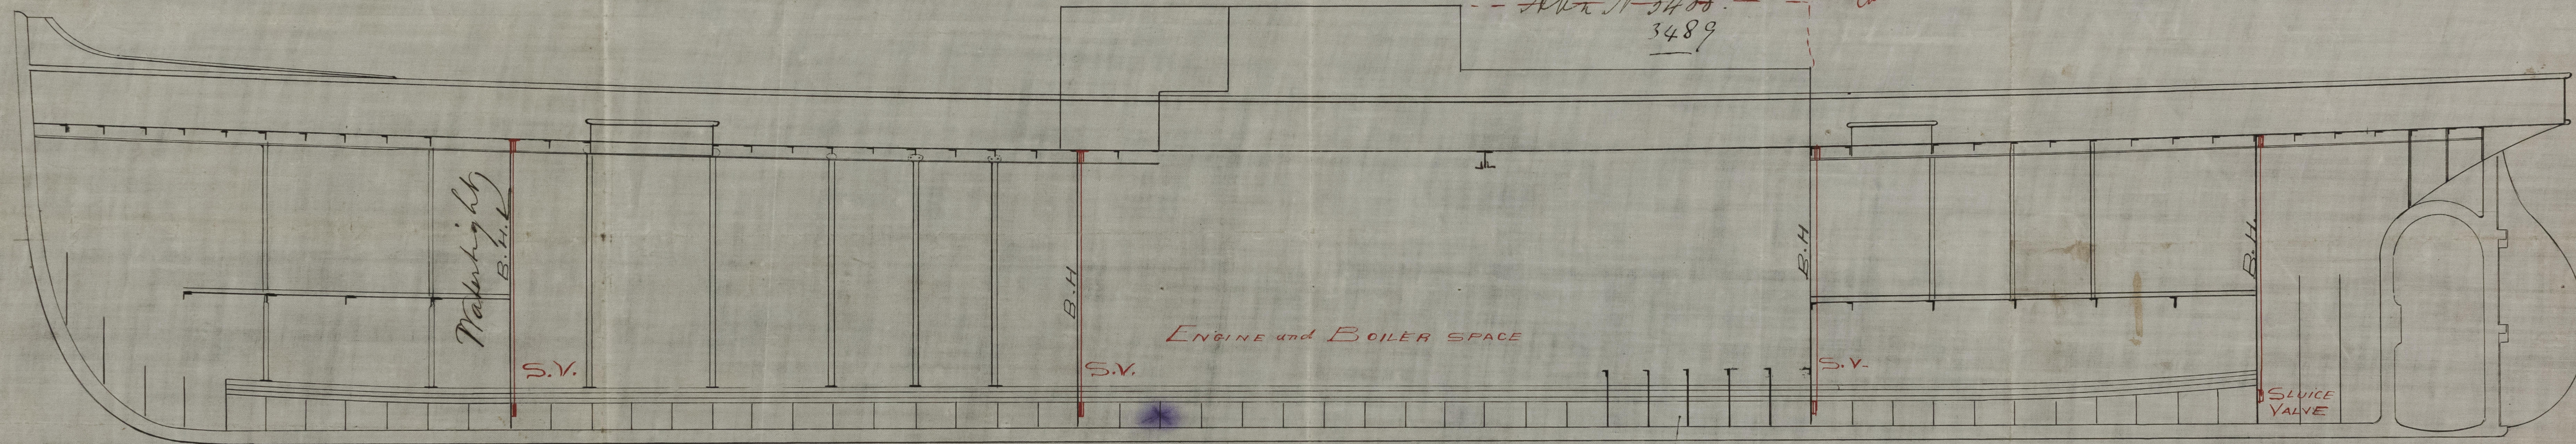

6/9/82

Scale $\frac{1}{4}$ inch = 1 Foot
N^o 164 & 165

John Duthie Sons & Co.
Shipbuilders
Aberdeen



© 2021
Lloyd's Register
Foundation
ABN18-0055