

Ltr. to Hon.  
25/6/83.

## MIDSHIP SECTION

OF


S.S. № 320

## DIMENSIONS

LENGTH	BETWEEN	PERPENDICULARS	250
BREADTH	EXTREME		33
DEPTH	IN HOLD	to Main Deck	17-6
DEPTH	IN HOLD	" Spar Deck	24-6



John Nani Spedeked Jan 11  
No of Report 3554

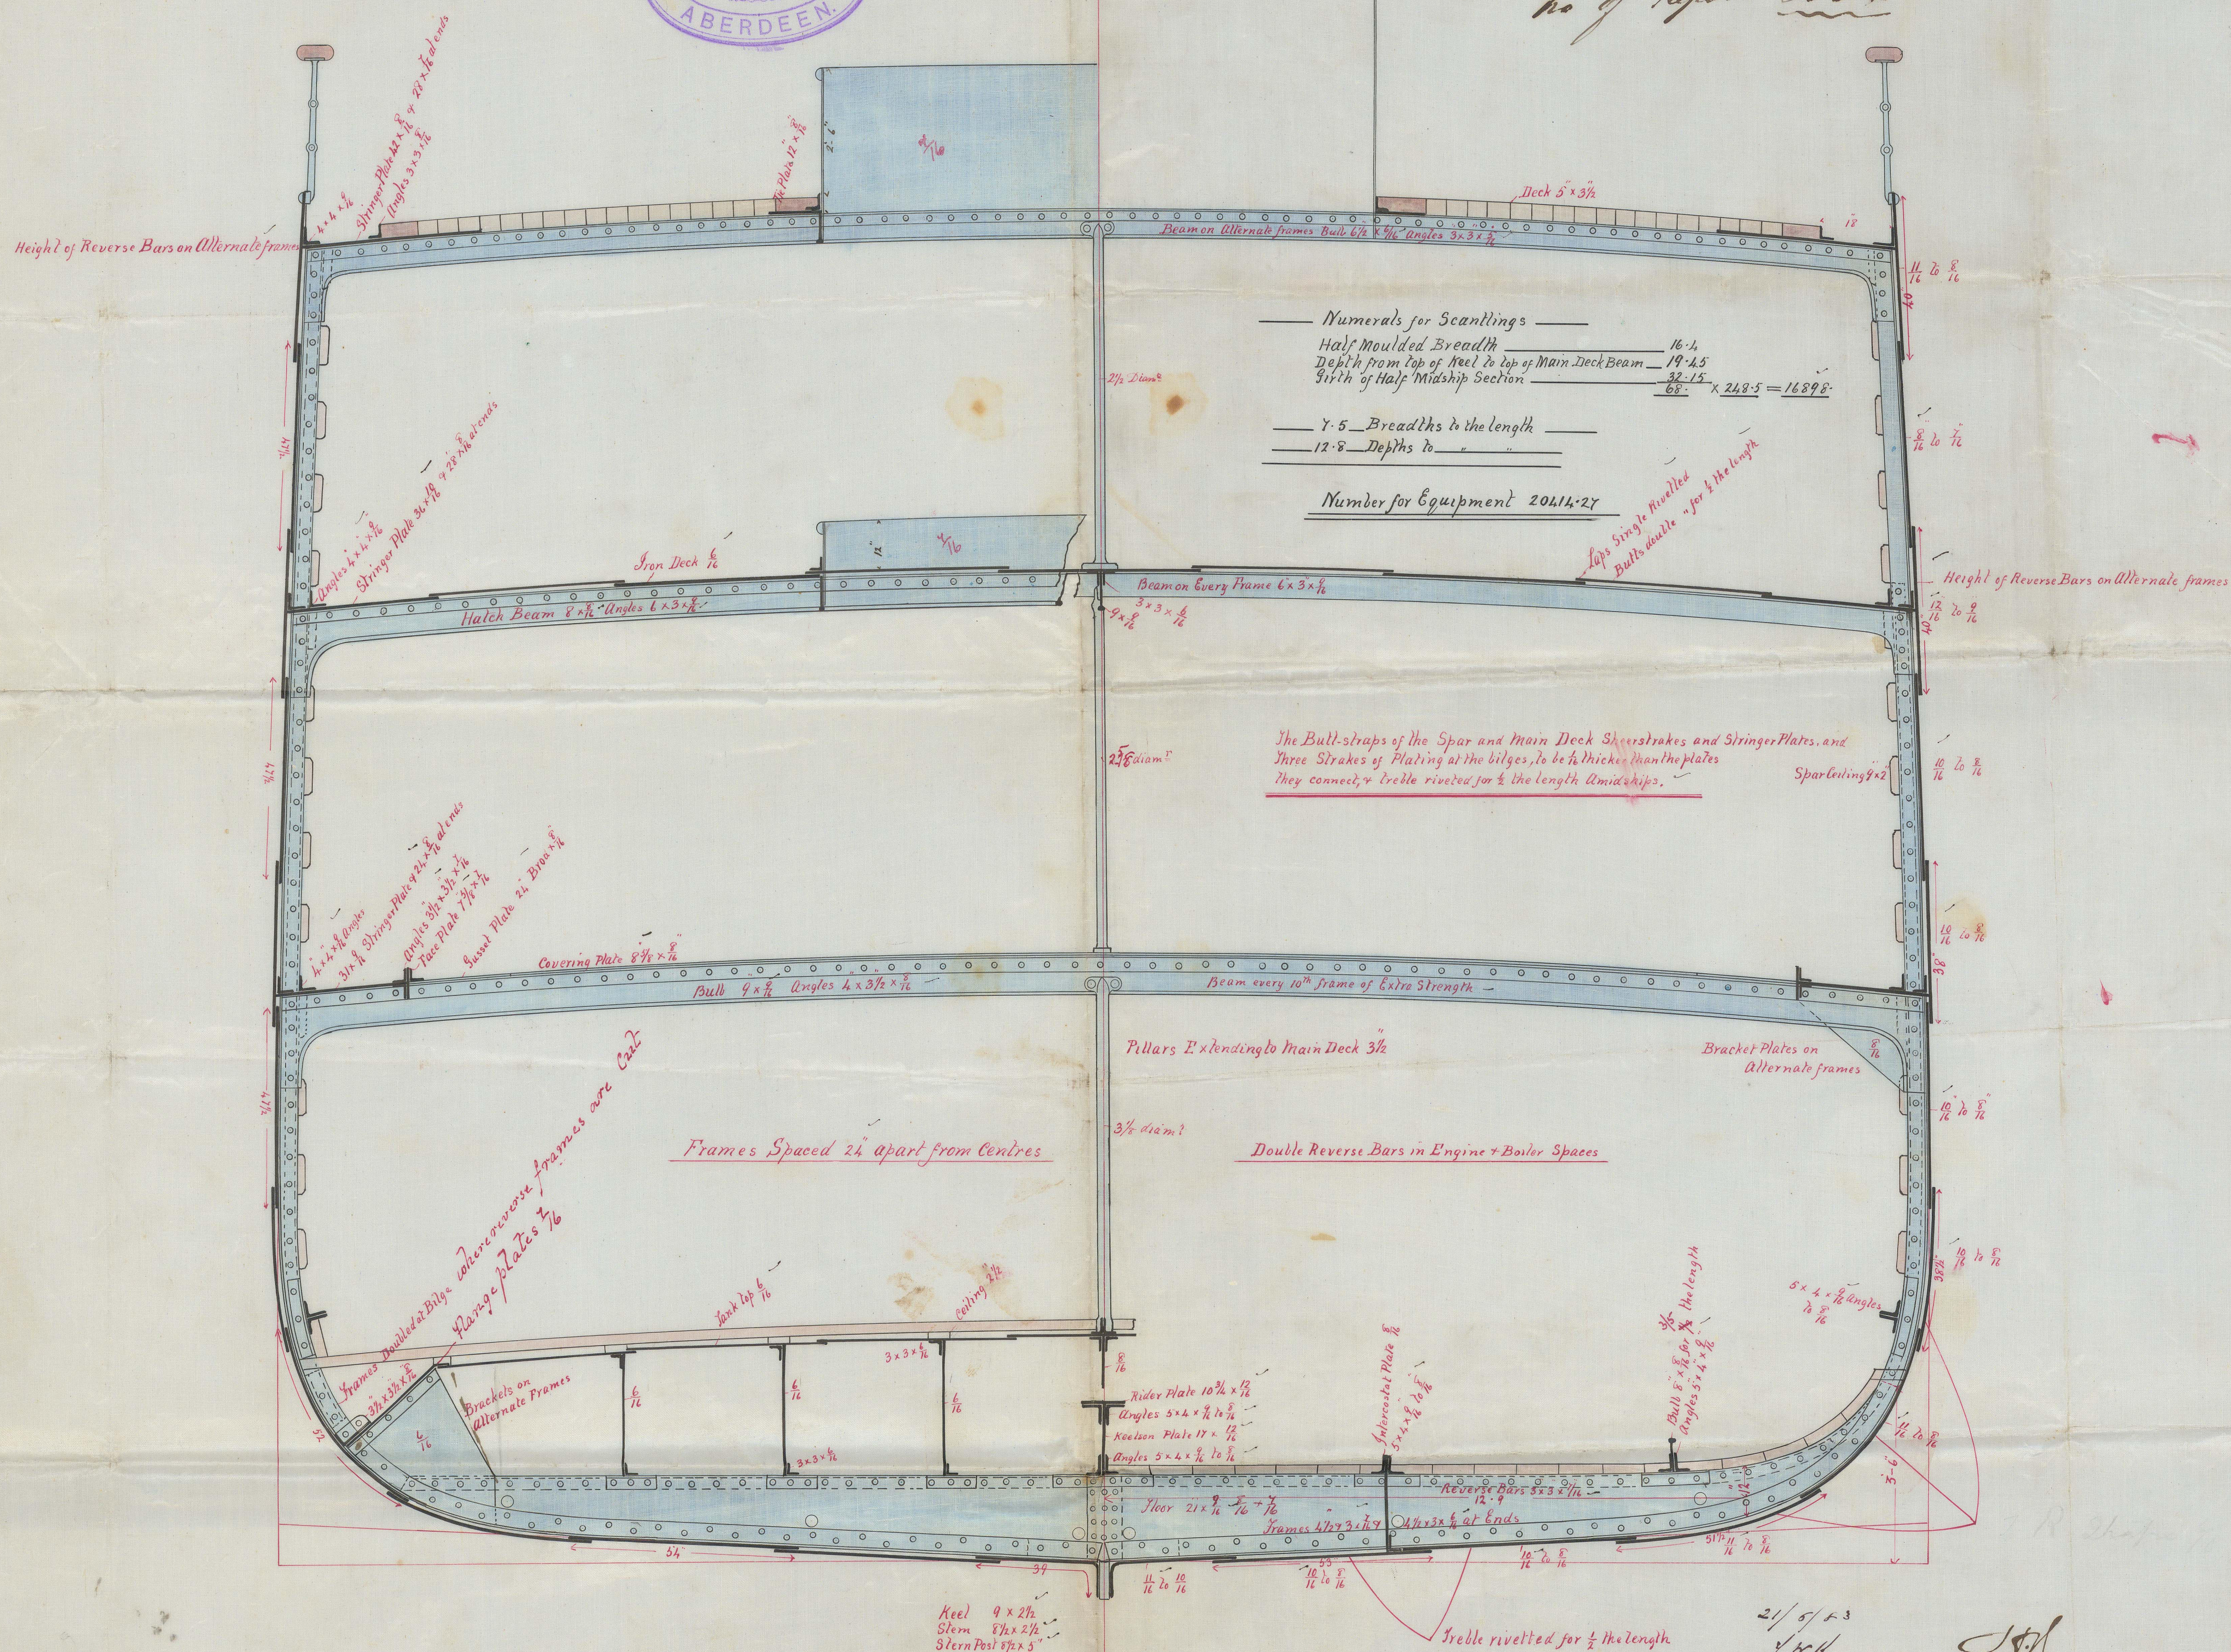

SCALE  $\frac{1}{2}$  INCH TO A FOOT

21/5/83  
J.H.K.

25/6/83