


1911-8

LONGITUDINAL SECTION

No 310

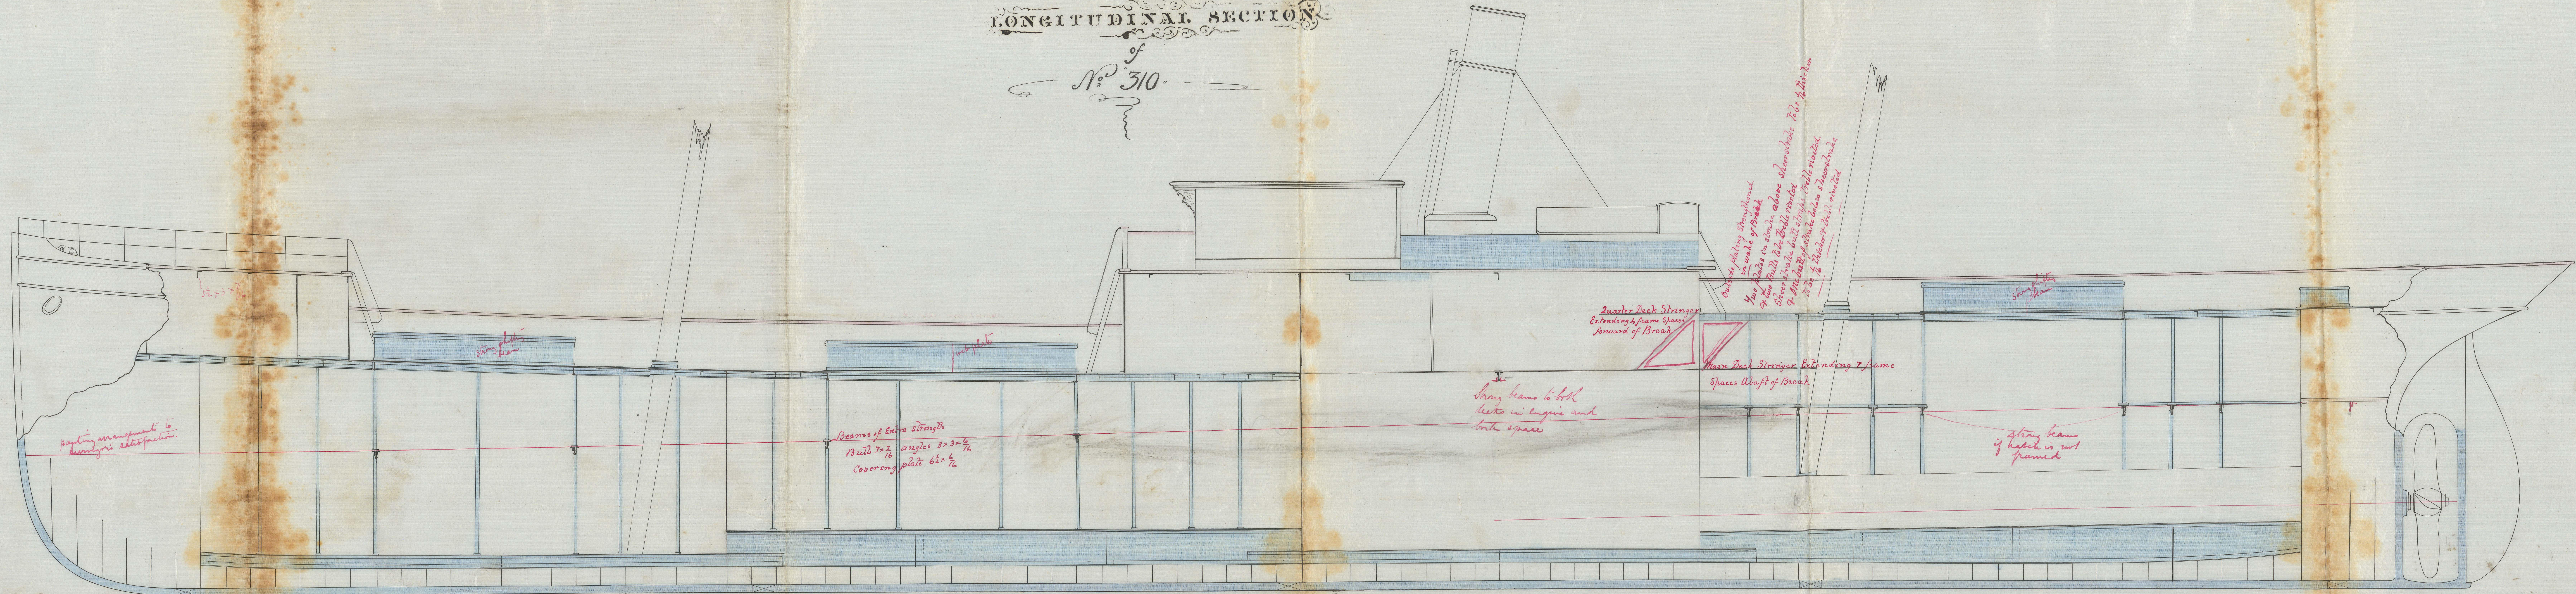

padding arrangement to
heavy iron adaptation.

Beams of Extra Strength
Built 7/16 angles 3x3x 5/16
Covering plate 6x 5/16

String beams to hold
decks in engine and
boiler space

Quarter Deck Stringer
Extending 4 frame spaces
forward of Break

Main Deck Stringer extending 7 frame
spaces abaft of Break

String beams
if hatch is not
framed

Outside plating strengthened
in wake of Break
Two plates in each above
& below Break Plate built riveted

String plate

18/11/18

SCALE 1/4" INCH TO A FOOT